



US NO. 441 (S.R. 7)

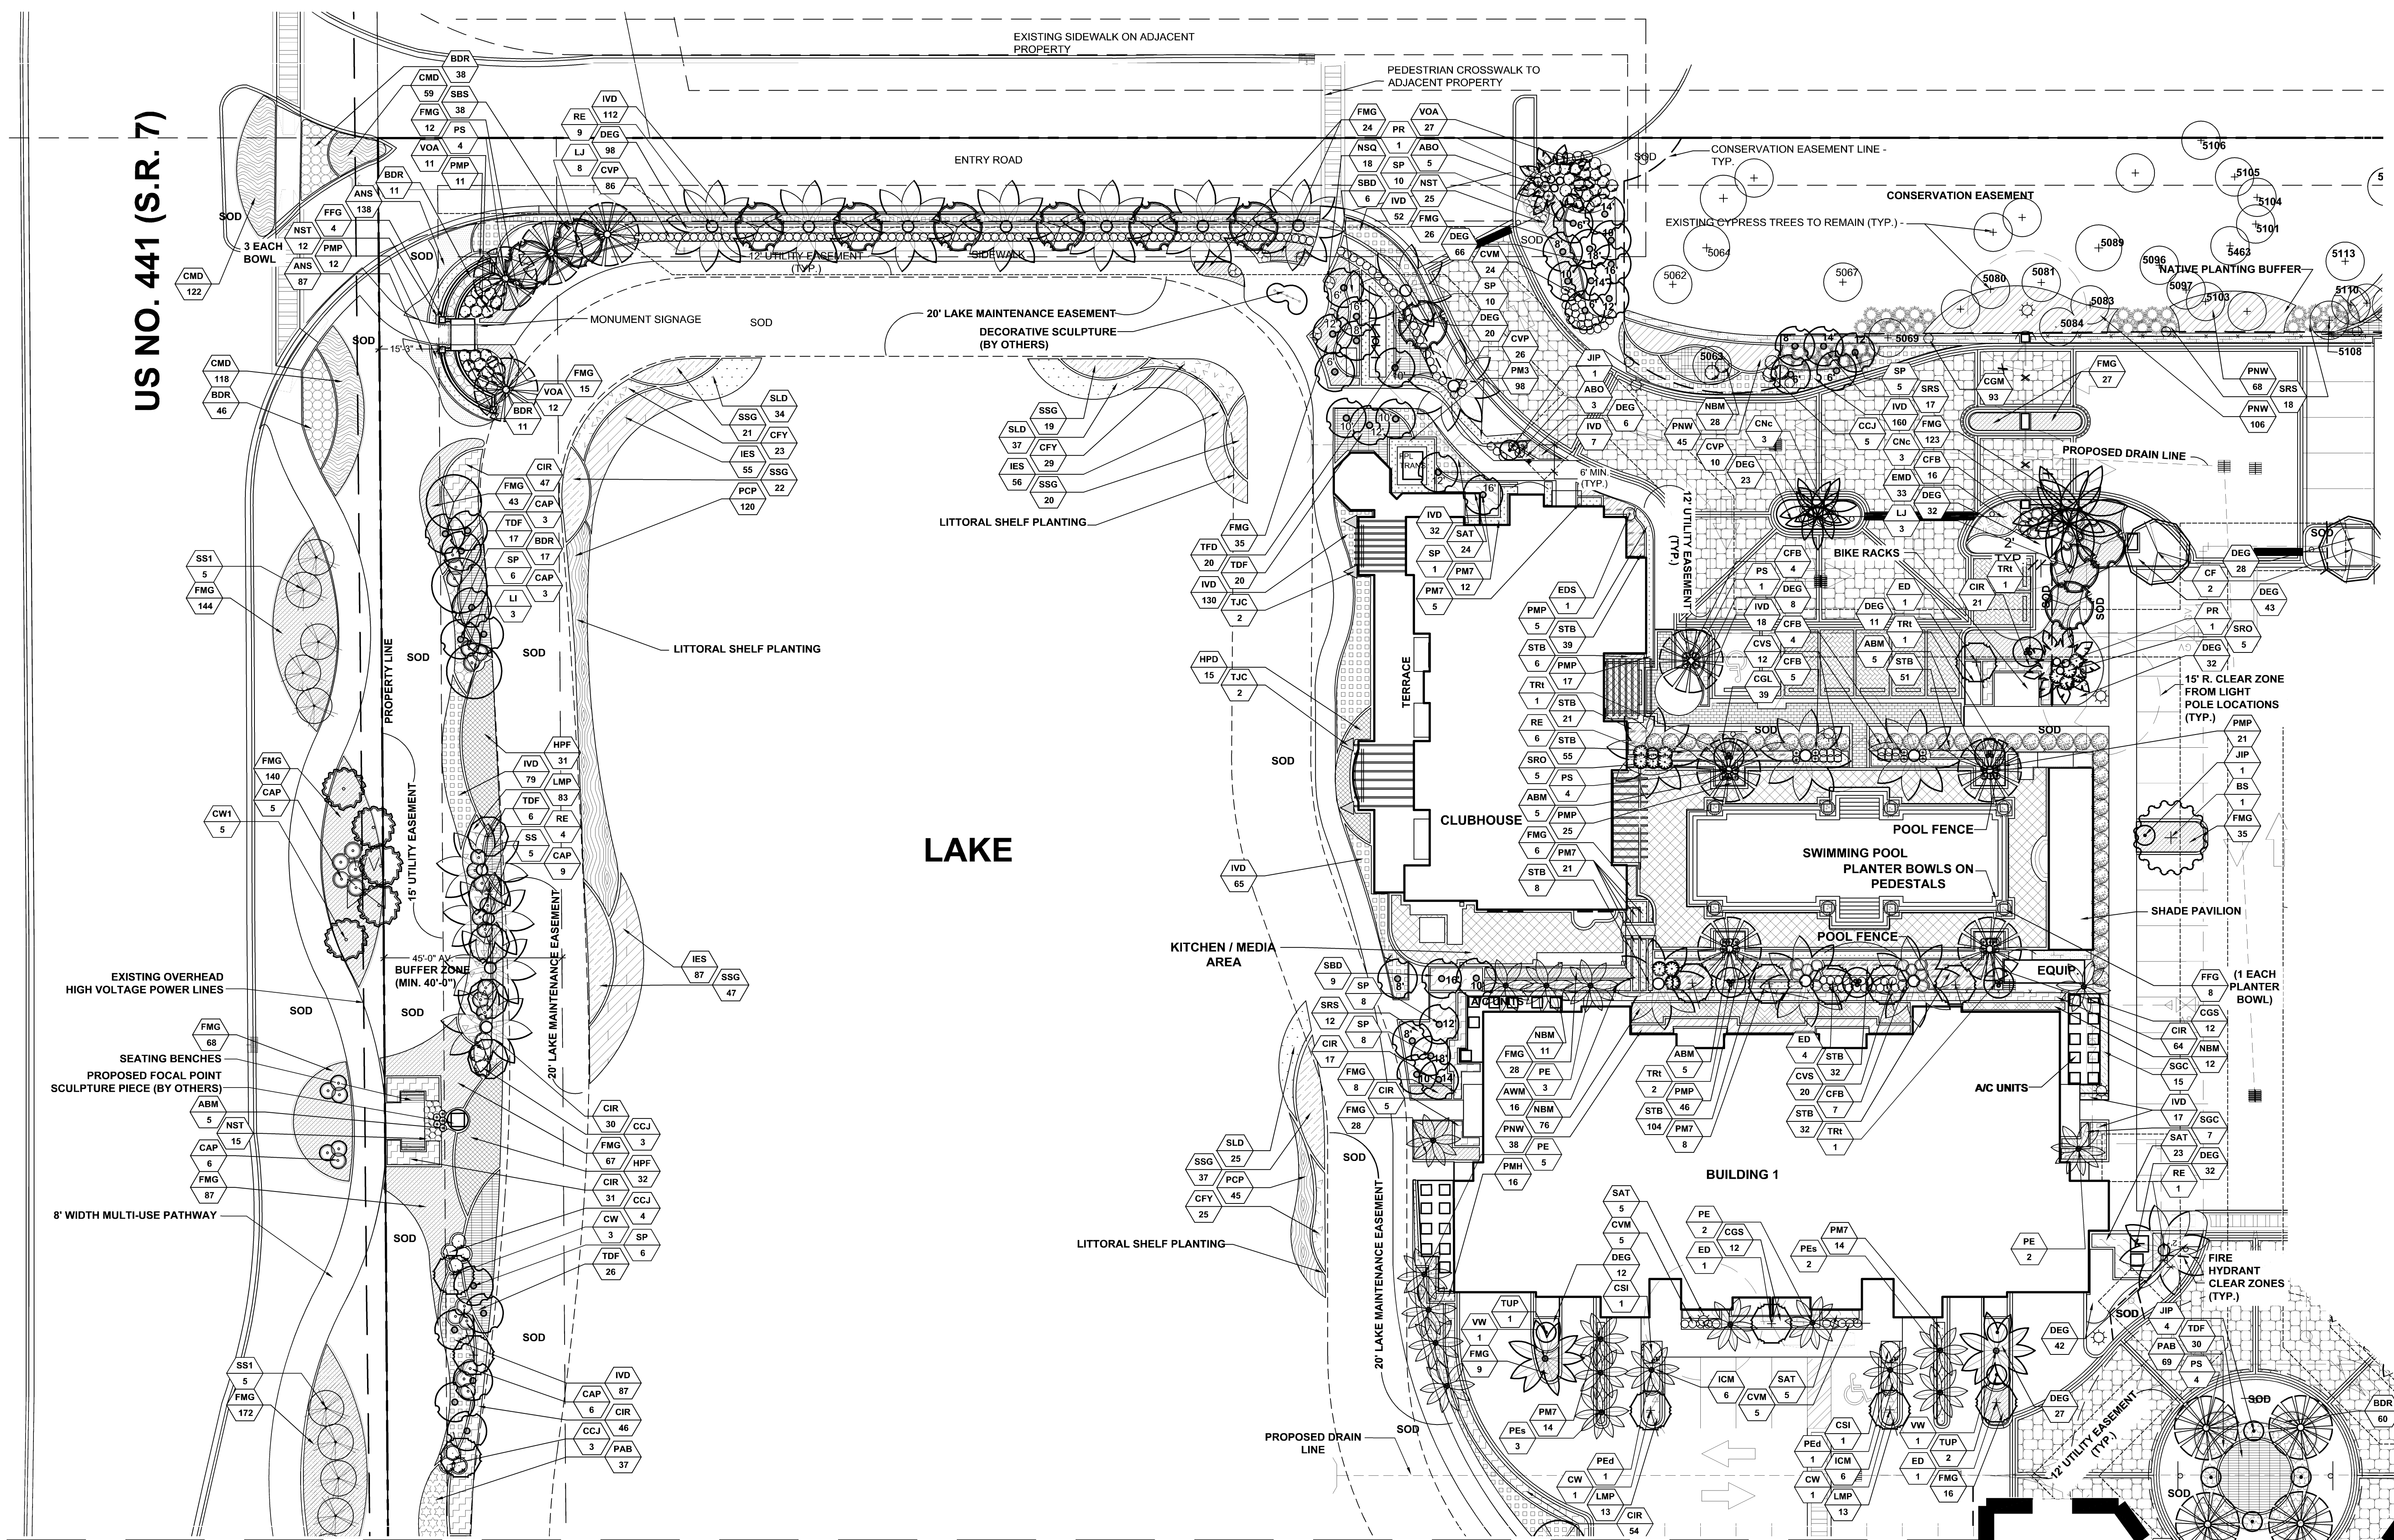

MATCH LINE SHEET LP-1 TO LP-2

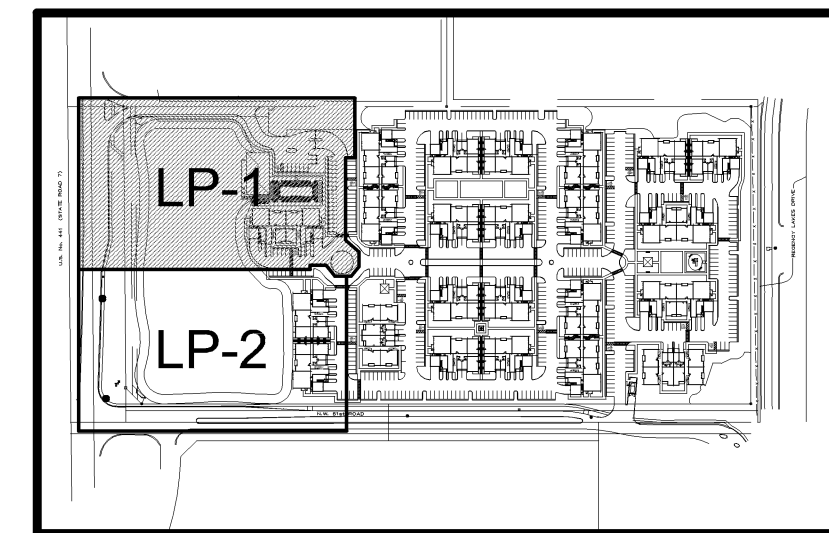

KEYMAP

SCALE: 1" = 20'-0"

ARCHITECTURE  
LANDSCAPE ARCHITECTURE  
LAND PLANNING  
INTERIOR DESIGN  
GOVERNMENTAL PROCESSING

**ARCHITECTURAL ALLIANCE**  
1123 SW FOURTH AVENUE, FORT LAUDERDALE, FLORIDA 33315, ANZ524344, LCC000377  
TEL: (954) 764-8888 FAX: (954) 764-0751 E-MAIL: landscape@archall.net

HUGH JOHNSON  
RLA #C000237

Revision Dates

Overall As-Built Landscape Plan  
**CASA PALMA**  
ZOM DEVELOPMENT, LLC.  
COCONUT CREEK, FLORIDA

Sheet Description  
Overall As-Built Landscape Plan

Release Date  
12/12/14

Project Number  
1165

Drawing Number  
**LP-1**

Sheet 1 OF 12