
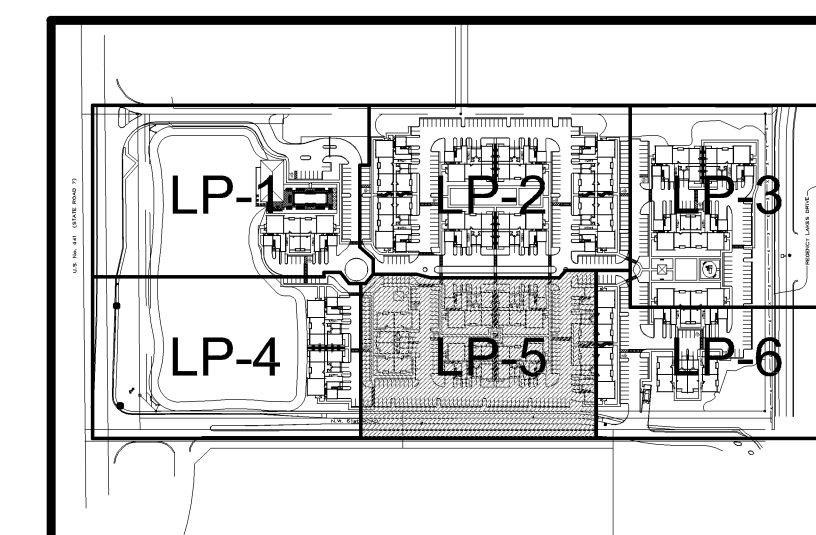



MATCH LINE SHEET LP-5 TO LP-4

MATCH LINE SHEET LP-5 TO LP-2

MATCH LINE SHEET LP-5 TO LP-6

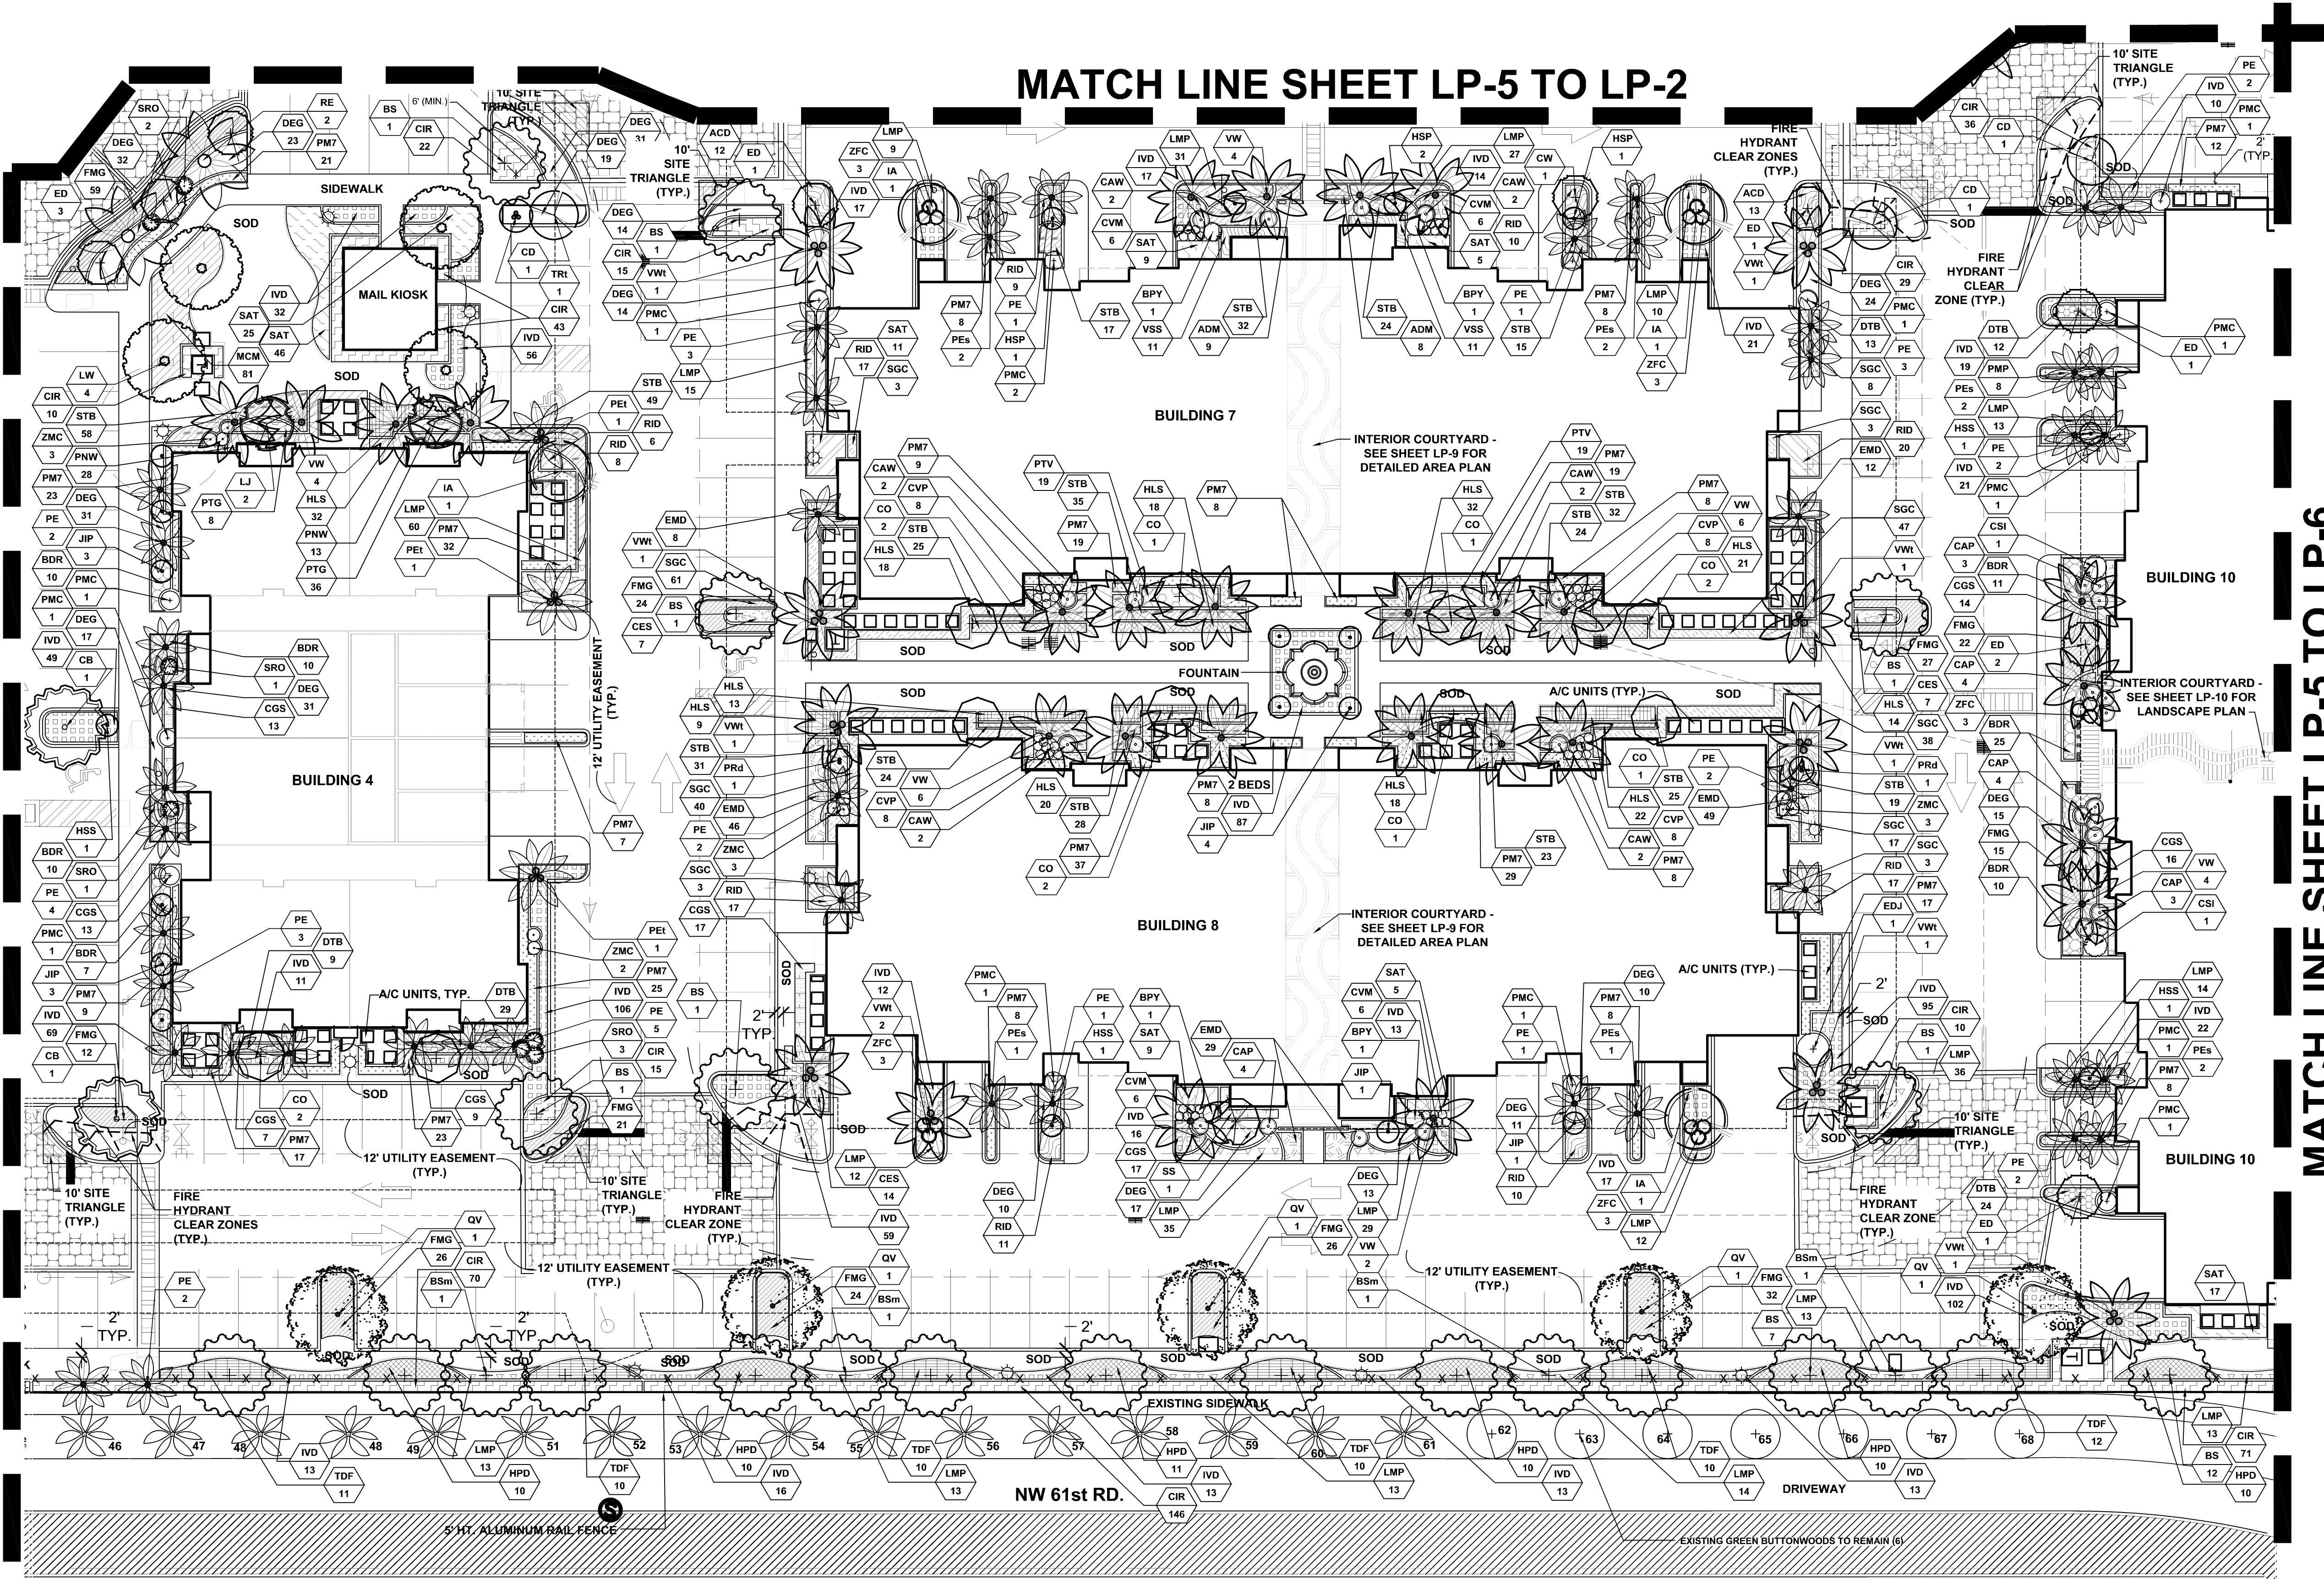

KEYMAP

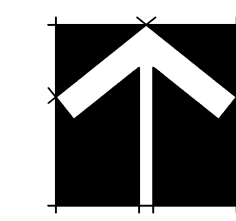

SCALE: 1" = 20'-0"

Overall As-Built Landscape Plan
CASA PALMA
 ZOM DEVELOPMENT, LLC.
 COCONUT CREEK, FLORIDA

Sheet Description
 Overall As-Built
 Landscape
 Plan

Release Date
 12/12/14

Project Number
 1165

Drawing Number

LP-5

Sheet 5 OF 12

ARCHITECTURE
 LANDSCAPE ARCHITECTURE
 LAND PLANNING
 INTERIOR DESIGN
 GOVERNMENTAL PROCESSING
ARCHITECTURAL ALLIANCE
 1123 SW FOURTH AVENUE, FORT LAUDERDALE, FLORIDA 33115, AN20141441.LCO000077
 TEL: (954) 764-8888 FAX: (954) 764-0751 E-MAIL: landscape@archall.net

HUGH JOHNSON
 RLA#000237

Seal

Revision Dates