


**BUILDING 7 COURTYARD LANDSCAPE PLAN**

SCALE: 1/4" = 1'-0"

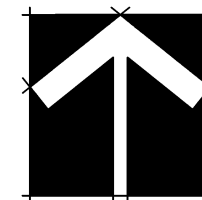

**PLANT LIST BUILDING 8**

**Trees and Palms**

PEs M 7 *Ptychosperma elegans* / Solitaire Palm

**Shrubs and Ground Covers**

Code	Native/Drought	Qty.	Botanical Name / Common Name	Specifications
FJF	M	18	<i>Fatsia japonica</i> / False Aralia	7 Gallon, 30-36" OA, Place per Plan
REL	M	8	<i>Rhapis excelsa</i> / Lady Palm	7 Gallon, 4-5' OA, Place per Plan
SAT	V	14	<i>Schefflera arboricola</i> 'Trinette' / Variegated Arboricola	3 Gallon, 24" OA, 24" On Center
STB	V	74	<i>Sansevieria trifasciata</i> 'Black Gold' / Variegated Snake Plant	1 Gallon, 10-12" OA, 18" On Center

B&B Field Grown, 8-12' Staggered OA Hts.

**PLANT LIST BUILDING 7**


**Trees and Palms**

PEs M 8 *Ptychosperma elegans* / Solitaire Palm

**Shrubs and Ground Covers**


Code	Native/Drought	Qty.	Botanical Name / Common Name	Specifications
FJF	M	18	<i>Fatsia japonica</i> / False Aralia	7 Gallon, 30-36" OA, Place per Plan
REL	M	8	<i>Rhapis excelsa</i> / Lady Palm	7 Gallon, 4-5' OA, Place per Plan
SAT	V	10	<i>Schefflera arboricola</i> 'Trinette' / Variegated Arboricola	3 Gallon, 24" OA, 24" On Center
STB	V	59	<i>Sansevieria trifasciata</i> 'Black Gold' / Variegated Snake Plant	1 Gallon, 10-12" OA, 18" On Center

B&B Field Grown, 8-12' Staggered OA Hts.

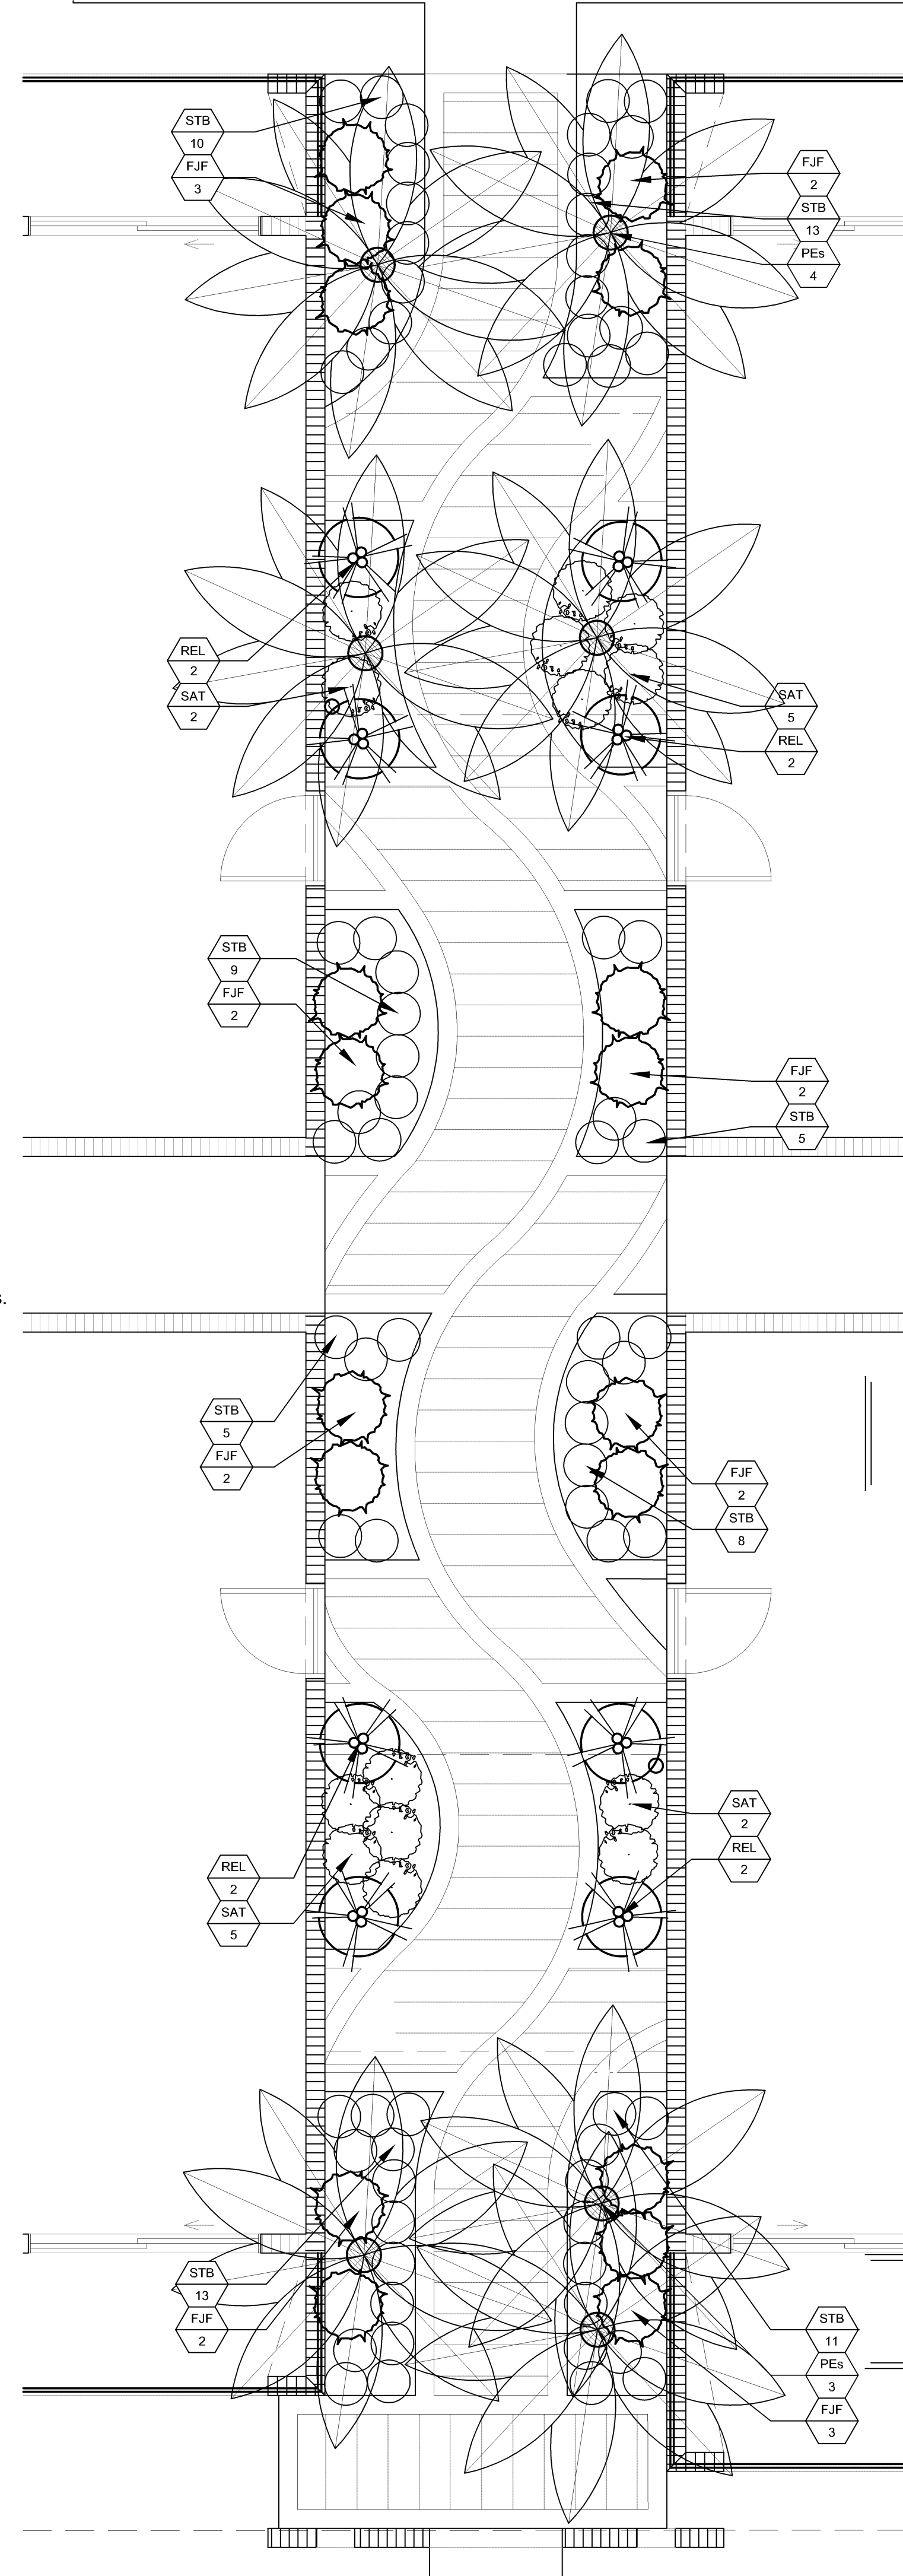

**BUILDING 8 COURTYARD LANDSCAPE PLAN**

SCALE: 1/4" = 1'-0"

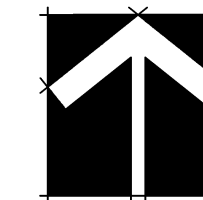

**Overall As-Built Landscape Plan Buildings 7 & 8 Courtyard**

**CASA PALMA**

ZOM DEVELOPMENT, LLC.  
COCONUT CREEK, FLORIDA

---

ARCHITECTURE  
LANDSCAPE ARCHITECTURE  
LAND PLANNING  
INTERIOR DESIGN  
GOVERNMENTAL PROCESSING

**ARCHITECTURAL ALLIANCE**

912 S. FOURTH AVENUE, SUITE 1000, MIAMI, FLORIDA 33135 (305) 375-1100  
TEL: (305) 375-1100 FAX: (305) 375-0707 E-MAIL: [info@architecturalalliance.com](mailto:info@architecturalalliance.com) LIC#000237

---

HUGH JOHNSON  
RLA #C000237

Seal

---

Revision Dates

---

Sheet Description  
Final As-Built Landscape  
Plan Bldgs. 7 &  
8 Courtyard

Release Date  
12/12/14

Project Number  
1165

Drawing Number  
**LP-9**

Sheet 9 OF 12