


STORM SEWER STRUCTURE SCHEDULE

BASIN & CB #	DRAINAGE AREA AC.	FRAME #	RIM	INVERT			
				NORTH	SOUTH	EAST	WEST
AS-BUILT YD 1	FINAL	NA	14.20		11.70		
AS-BUILT YD 2	FINAL	NA	14.05	7.95		7.95	
AS-BUILT 3	FINAL	5105	13.75		6.65		7.45
AS-BUILT 4	FINAL	6148	5105	13.75	6.60	6.60	
AS-BUILT 5	FINAL	6148	NA	14.20			11.70
AS-BUILT 6	FINAL	5105	13.75			7.80	
AS-BUILT 7	FINAL	6148	5105	13.75	7.75	10.20	7.75
AS-BUILT 8	FINAL	6148	NA	14.50			12.00
AS-BUILT YD 9	FINAL	NA	14.64	11.45		11.45	
AS-BUILT 10	FINAL	5105	14.25	7.65	7.85		6.90
AS-BUILT 11	FINAL	5105	14.25			6.85	6.85
AS-BUILT 12	FINAL	6148	NA	14.64	6.55	6.55	6.75
AS-BUILT 13	FINAL	6148	NA	14.70	6.53	6.53	
AS-BUILT 14	FINAL	6210	5105	13.75		10.65	
AS-BUILT 15	FINAL	6148	5105	13.75	10.65		
AS-BUILT 16	FINAL	6148	NA	14.03	10.60	10.60	10.60
AS-BUILT 17	FINAL	5105	13.95			10.55	10.55
AS-BUILT 18	FINAL	6148	NA	15.05	6.50	6.50	10.20
AS-BUILT 19	FINAL	6148	NA	14.70	6.48	6.48	
AS-BUILT YD 20	FINAL	6210	NA	14.20			
AS-BUILT 21	FINAL	6148	5105	13.75	7.85	10.20	
AS-BUILT 22	FINAL	6148	NA	14.45		11.45	
AS-BUILT 23	FINAL	6148	5105	13.75	10.20	7.75	6.35
AS-BUILT 24	FINAL	6148	5105	13.75	6.45	5.35	6.25
AS-BUILT YD 25	FINAL	NA	14.75	12.00			
AS-BUILT 26	FINAL	NA	14.75			12.00	
AS-BUILT YD 27	FINAL	NA	14.75	11.50	11.50		11.50
AS-BUILT YD 28	FINAL	NA	NA	14.30		11.00	11.00
AS-BUILT 29	FINAL	5105	13.75	5.30	6.55		10.20
AS-BUILT 30	FINAL	6148	NA	16.00	6.50		6.40
AS-BUILT 998	NA	5130	14.15	9.75	9.45		
AS-BUILT 999	NA	5130	14.15	7.60	9.75		7.75
AS-BUILT		6016					EX.
AS-BUILT		6016					EX.

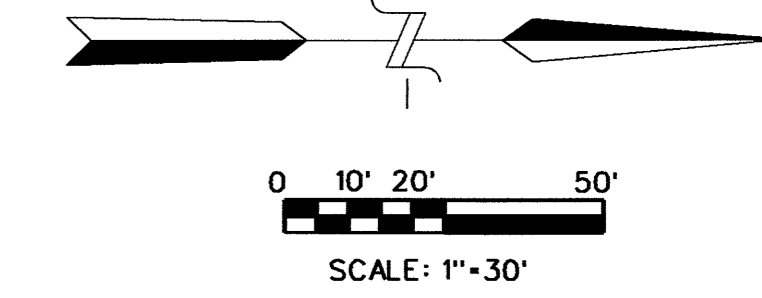

INSTALL SILT FENCE AROUND SITE PERIMETER FOR LENGTH OF CONSTRUCTION. SILT FENCE PER CITY OF COCONUT CREEK & FOOT REQUIREMENTS

48 HOURS BEFORE DIGGING  
**CALL SUNSHINE**  
 TOLL FREE  
**1-800-432-4770**  
 UNDERGROUND UTILITIES NOTIFICATION  
 CENTER OF FLORIDA

CITY OF COCONUT CREEK PERMIT SET MUST BE ON SITE AT ALL TIMES DURING CONSTRUCTION. NOTICE INSPECTION REQUIRED. 48 HRS. PRIOR TO COMMENCING ANY WORK IN THE PUBLIC RIGHT OF WAY CONTACT THE CITY OF COCONUT CREEK ENGINEERING DEPARTMENT FOR INSPECTION. NOTE: APPROVAL OF THIS PLAN DOES NOT CONSTITUTE A PERMIT FOR CONSTRUCTION. A PERMIT FOR CONSTRUCTION MUST BE OBTAINED FROM THE CITY OF COCONUT CREEK ENGINEERING DEPARTMENT PRIOR TO COMMENCING CONSTRUCTION IN THE PUBLIC RIGHT OF WAY.

- EROSION & POLLUTION CONTROL NOTES**
- PRIOR TO ANY CONSTRUCTION, BALED HAY OR SILT SCREENS OR OTHER APPROVED SILT BARRIER SHALL BE INSTALLED BY THE EARTHWORK CONTRACTOR ALONG THE PROPERTY LINE AROUND ENTIRE SITE PERIMETER AND LIMITS OF CONSTRUCTION. SILT SCREENS SHALL REMAIN IN PLACE DURING THE LENGTH OF CONSTRUCTION OF THIS PROJECT (SEE DETAIL INDEX 102). IN ADDITION, SILT SCREENS OR BALED HAY MUST BE INSTALLED PER CITY OF COCONUT CREEK STANDARD DETAIL. CONTRACTOR TO OBTAIN DETAIL FROM CITY ENGINEER.
  - DURING CONSTRUCTION, INLET SEDIMENT FILTERS SHALL REMAIN IN PLACE TO PREVENT THE RUNOFF OF SILT OR OTHER POLLUTANTS INTO THE DRAINAGE SYSTEM. MIRAFI MAY BE USED FOR DITCH BOTTOM INLETS. SEE DETAIL SHEETS FOR CURB INLET SEDIMENT BARRIERS.
  - ANY LOOSE SOIL LEAVING THE SITE MUST BE CLEANED FROM THE ADJACENT ROADWAY ON A DAILY BASIS.

- CITY OF COCONUT CREEK EROSION & POLLUTION CONTROL NOTES**
- PROVIDE TREE PROTECTION OF ALL SITE TREES TO REMAIN. TREE PROTECTION PER CITY OF COCONUT CREEK STANDARD DETAIL. CONTRACTOR TO OBTAIN DETAIL FROM CITY ENGINEER.
  - PROVIDE FOR WEEKLY INSPECTION BY THE CONTRACTOR AND RAINFALL AND LOCATE RAIN GAUGE ON SITE TO MEASURE RAINFALL ACTIVITY.
  - ALL EROSION CONTROL MEASURES MUST MEET ALL THE REQUIREMENTS OF THE CITY OF COCONUT CREEK EROSION AND CONTROL PROCEDURES AND THE FLORIDA STORMWATER, EROSION AND SEDIMENT CONTROL INSPECTOR'S MANUAL.
  - ALL EROSION AND SEDIMENT CONTROL MEASURES AND BMPs MUST BE MAINTAINED AS REQUIRED BY THE CITY FOR THE DURATION OF THE PROJECT.
  - LOG BOOK OF ALL EROSION CONTROL INSPECTIONS MUST BE KEPT AND MAINTAINED ON-SITE.
  - SPILL RESPONSE EQUIPMENT MUST BE ON-SITE AT ALL TIMES.

- GENERAL NOTES**
- DRAINAGE RUNS ARE MEASURED TO CENTER OF STRUCTURE. THE MINIMUM FINISHED FLOOR ELEVATION IS 15.70.
  - SEE PLAN FOR DESIGN ELEVATIONS.
  - THE MINIMUM CROWN OF THE ROAD ELEVATION IS 13.95. SEE PLAN FOR DESIGN ELEVATIONS.
  - DENSITY TESTS SHALL BE PERFORMED BY A CERTIFIED GEOTECHNICAL ENGINEERING FIRM DURING INSTALLATION OF THE DRAINAGE STRUCTURES, PIPE, ROAD SUBGRADE AND BASE. THE CITY OF COCONUT CREEK INSPECTOR MUST BE PRESENT DURING ALL DENSITIES.

- TOPOGRAPHY NOTE:**
- ALL EXISTING AND PROPOSED ELEVATIONS ON THIS PLAN ARE IN NAVD. TO CONVERT TO NGVD, ADD 1.55.

PROJECT: <b>IN THE PINES</b>	TITLE: <b>POLLUTION PREVENTION PLAN, BASIN MAP, &amp; DRAINAGE PLAN</b>	SHEET NUMBER: <b>PD1</b>
DATE: <b>05/15/14</b>	REVISIONS:	OF <b>6</b>
SCALE: <b>1" = 30'</b>	DATE: <b>09/01/14</b> MODIFY PER CITY SP DRC #1	
DRAWN BY: <b>HEJ</b>	DATE: <b>10/25/14</b> REVISE PER CITY SP DRC COMMENTS #2	
CHECKED BY: <b>LJ</b>	DATE: <b>01/01/15</b> UPDATE FOR FINAL ENGINEERING	
APPROVED BY: <b>HEJ</b>		
PROJECT #: <b>13-0020</b>		

**AJ HYDRO ENGINEERING, INC.**  
 5932 NW 73RD COURT  
 PARKLAND, FL 33067  
 TEL (954) 344-7866  
 FAX (954) 344-7866