

An Exterior Facade Renovation for:
BACHRODT CHEVROLET
5600 North State Road 7
Coconut Creek, Florida 33703


revised:	CITY REVIEW COMMENTS
date:	05-24-11
	06-04-11
revision:	CITY REVIEW COMMENTS RDM#2

commission:	11-016
principal:	ERIC ANDERSON
project manager:	CH
file name:	11-016
date:	04-11-11
title:	EXTERIOR ELEVATIONS

EXTERIOR ELEVATIONS

611

of 5 A

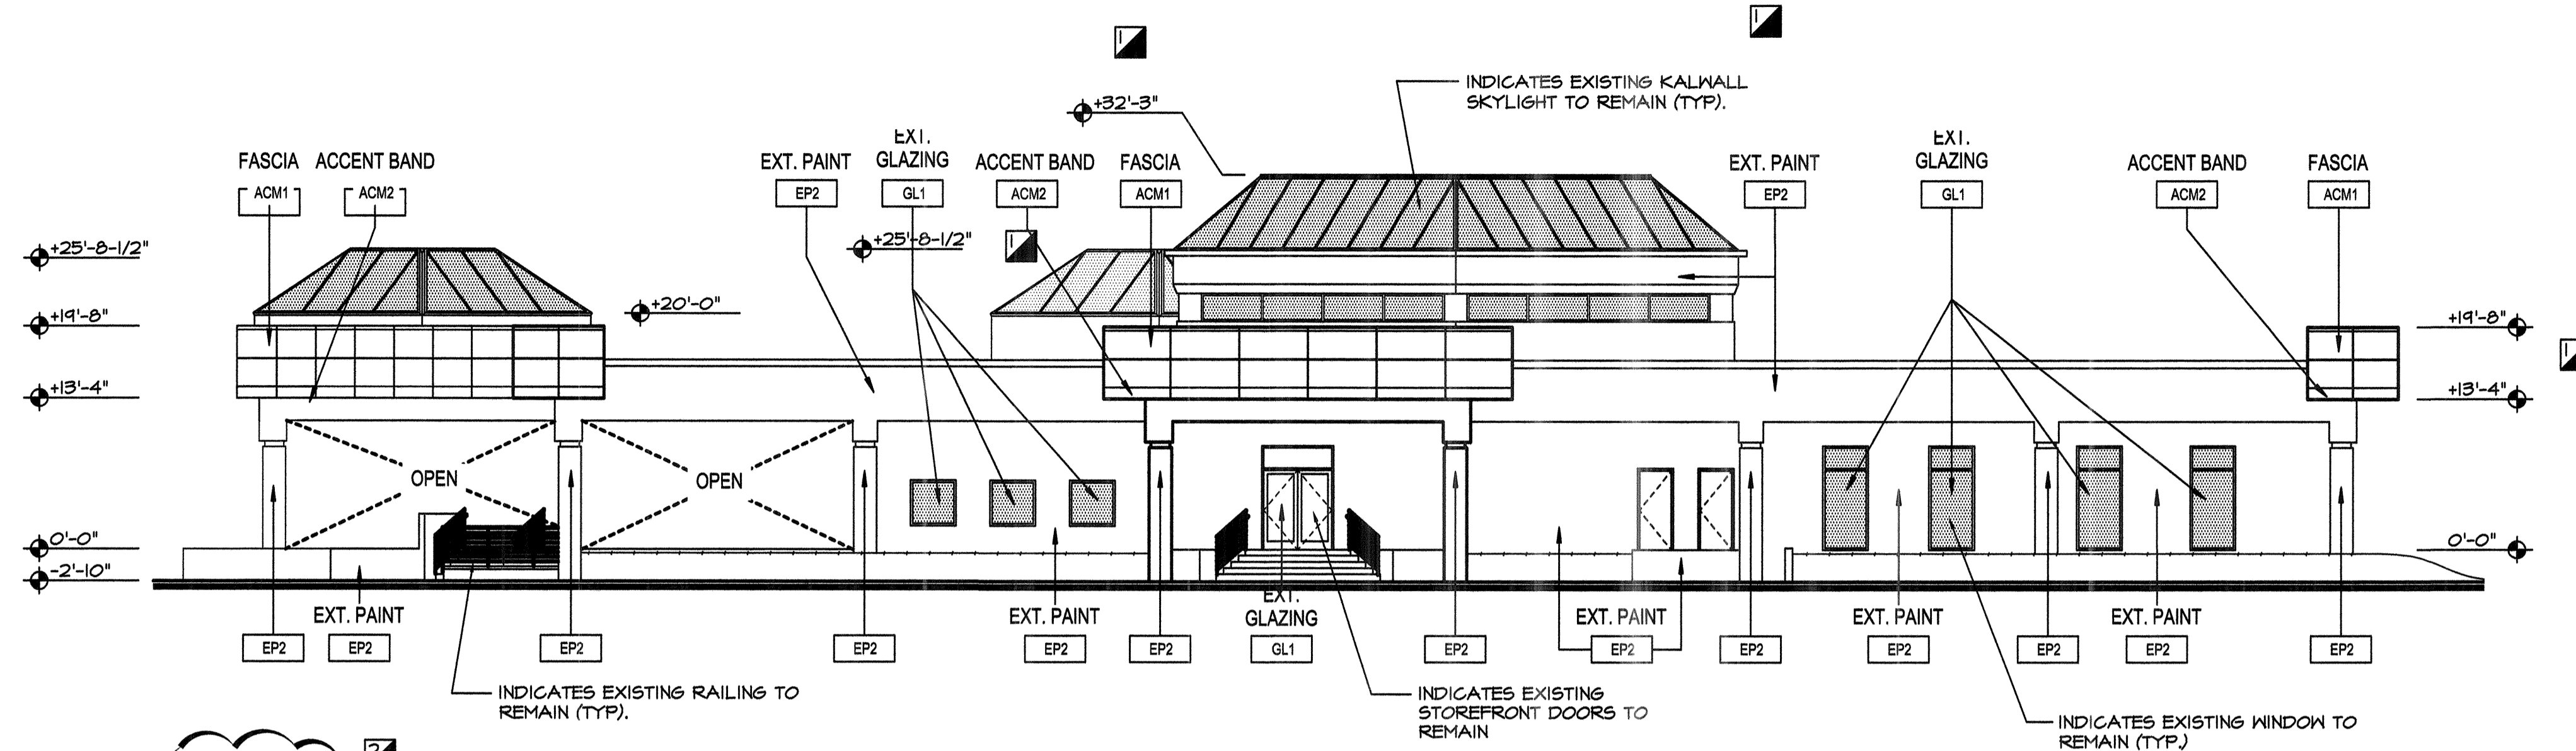


SALES BUILDING - EAST EXTERIOR ELEVATION

3/32" = 1'-0"

3
A611

SIGNAGE SHALL BE SUBMITTED AS A SEPARATE APPROVAL

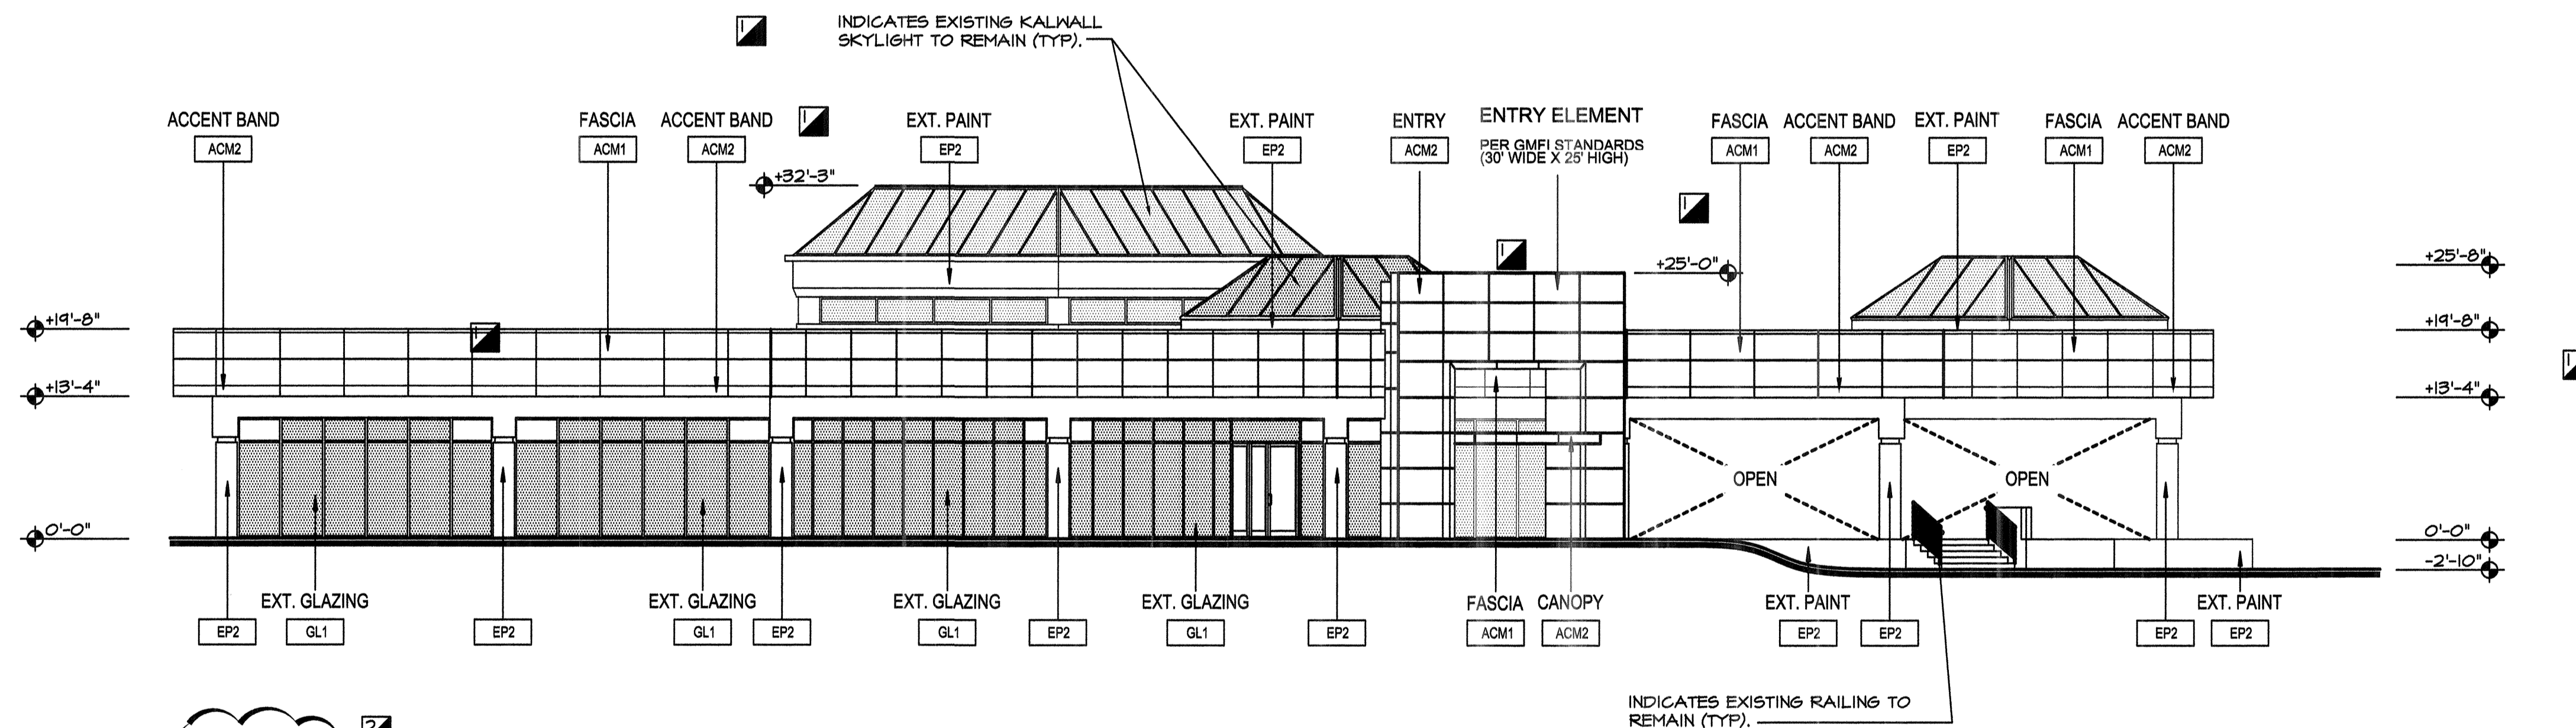

SALES BUILDING WEST EXTERIOR ELEVATION

3/32" = 1'-0"

4
A611

FINISH KEY

ACM1	ALUMINUM COMPOSITE MATERIAL, COLOR: ALPOLIC TBX BRIGHT ALUMINUM METALLIC
ACM2	ALUMINUM COMPOSITE MATERIAL, COLOR: ALPOLIC CVB BLUE - COLOR TO MATCH PMS 300 (CHEVROLET BLUE)
ACM3	ALUMINUM COMPOSITE MATERIAL, COLOR: ALPOLIC DM HLZ ALUMINUM BRUSHED HAIRLINE ALUMINUM
GL1	EXISTING STOREFRONT GLAZING TO REMAIN U.N.O.

REFER TO FINISH LEGEND, SHEET A-XXX FOR EXTERIOR PAINT COLORS