


consultant:

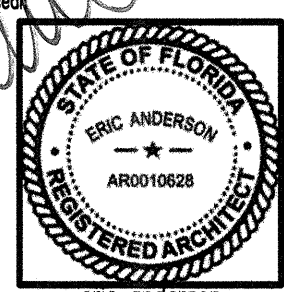

An Exterior Facade Renovation for:  
**BACHRODT CHEVROLET**  
5500 North State Road 7  
Coconut Creek, Florida 33703

revision:	CITY REVIEW COMMENTS
date:	05-24-11


commission: 11-016  
principal: ERIC ANDERSON  
project manager: CH

file name: 11-016  
date: 04-11-11  
title:

EXTERIOR ELEVATIONS

612


of 5 A

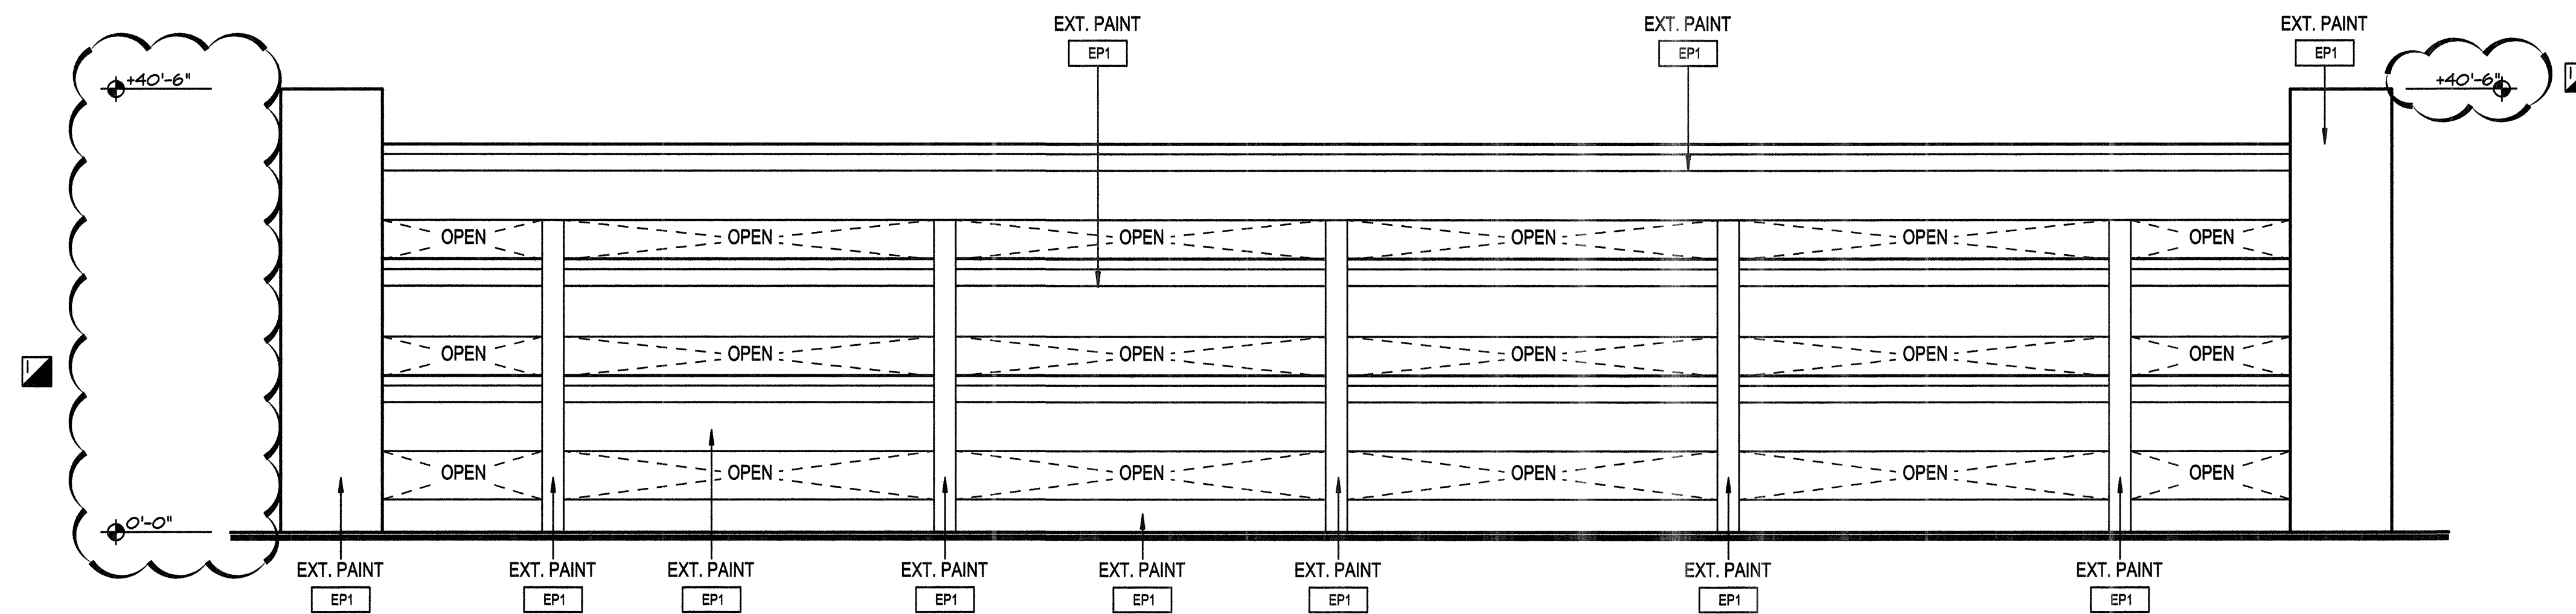

**PARKING STRUCTURE/SERVICE BUILDING - NORTH EXTERIOR ELEVATION**

3/32" = 1'-0"

5  
A612

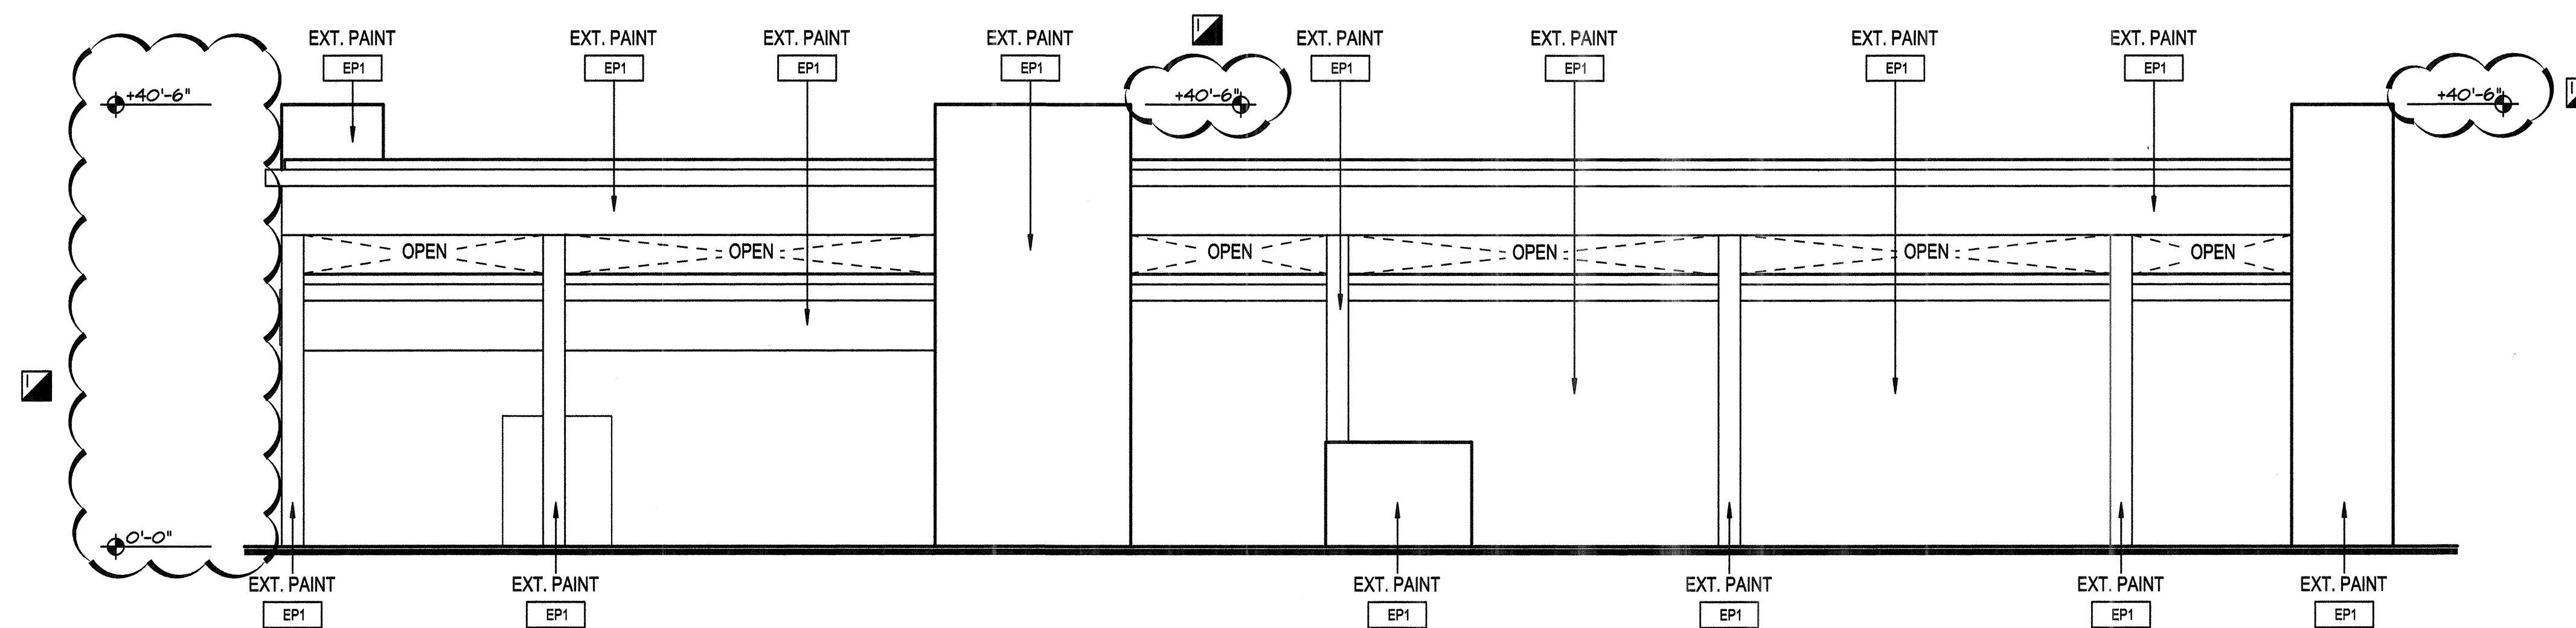

**PARKING STRUCTURE/SERVICE BUILDING - SOUTH EXTERIOR ELEVATION**

3/32" = 1'-0"

6  
A612

**FINISH KEY**

ACM1	ALUMINUM COMPOSITE MATERIAL, COLOR: ALPOLIC TBX BRIGHT ALUMINUM METALLIC
ACM2	ALUMINUM COMPOSITE MATERIAL, COLOR: ALPOLIC CVB BLUE - COLOR TO MATCH FMS 300 (CHEVROLET BLUE)
ACM3	ALUMINUM COMPOSITE MATERIAL, COLOR: ALPOLIC DM HLZ ALUMINUM BRUSHED HAIRLINE ALUMINUM
GL1	EXISTING STOREFRONT GLAZING TO REMAIN U.N.O.

\* REFER TO FINISH LEGEND, SHEET A-XXX FOR EXTERIOR PAINT COLORS