
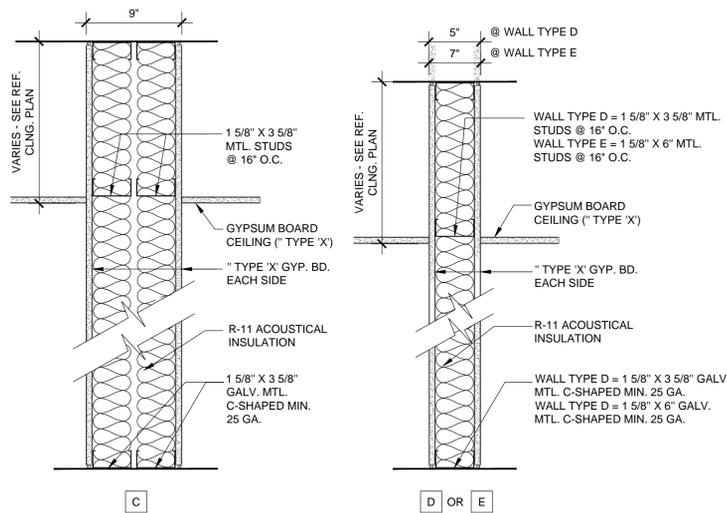



- (A) SHERWIN WILLIAMS SW 7567 NATURAL TAN
- (B) SHERWIN WILLIAMS SW 7506 LOGGIA
- (C) SHERWIN WILLIAMS SW 6967 FRANK BLUE  
(MTL. ROOF COLOR: POLYGON MTL. STRUCTURES; COLOR 'REGAL BLUE')

6 COLOR CODE LEGEND

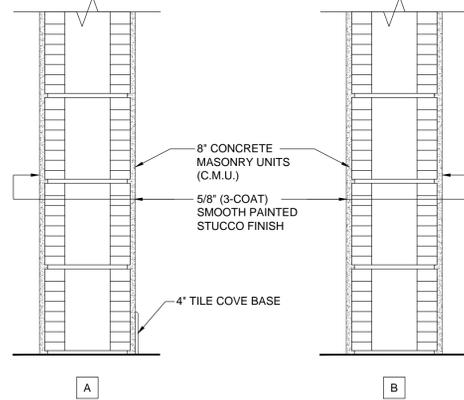


5 WALL TYPES  
SCALE: 1 1/2" = 1'-0"


2 REAR ELEVATION (East Face)  
SCALE: 1/4" = 1'-0"

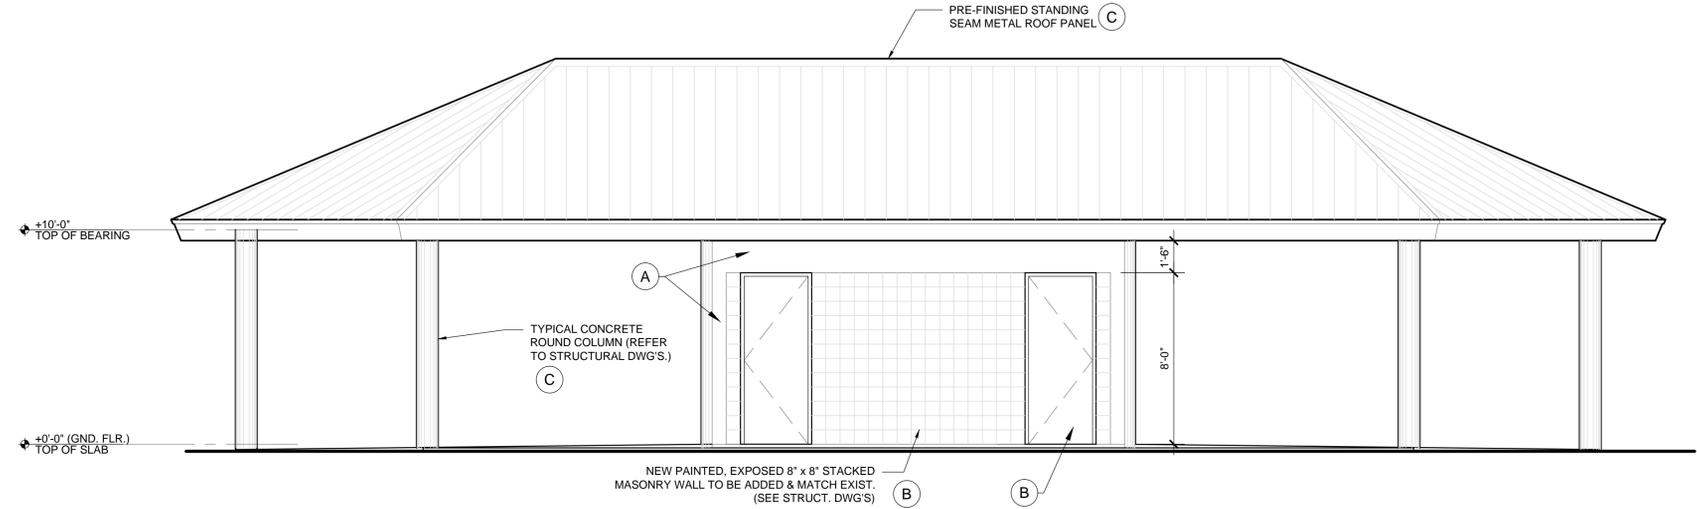


1 FRONT ELEVATION (West Face)  
SCALE: 1/4" = 1'-0"

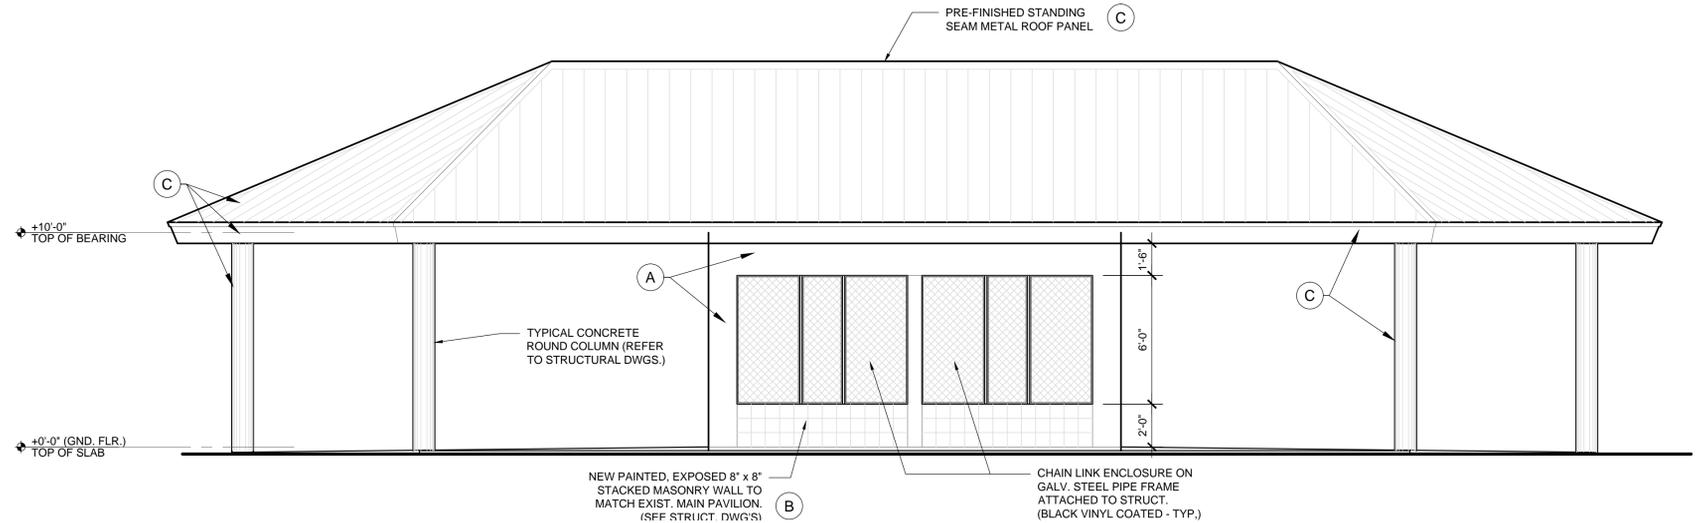

2 REAR ELEVATION (East Face)  
SCALE: 1/4" = 1'-0"

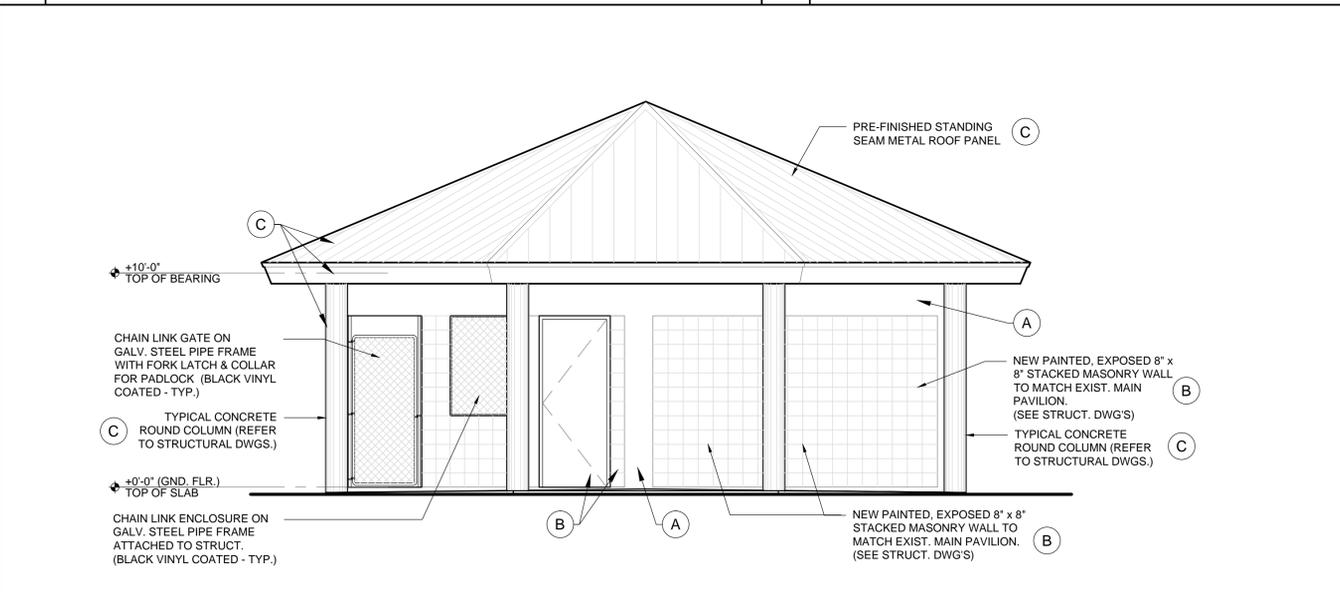

4 LEFT SIDE ELEVATION (North Face)  
SCALE: 1/4" = 1'-0"

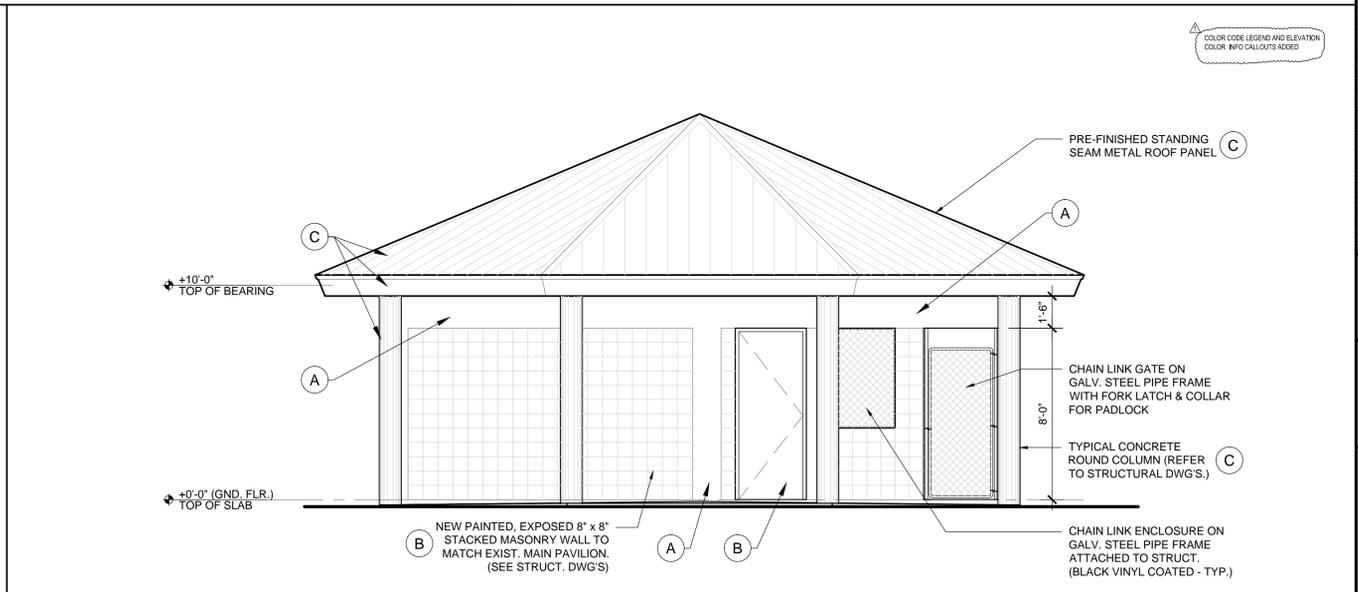

3 RIGHT SIDE ELEVATION (South Face)  
SCALE: 1/4" = 1'-0"



1800 Eller Drive, Suite 500  
Fort Lauderdale, FL 33316  
T 954.961.6806  
F 954.961.6807  
www.synalovski.com

Manuel Synalovski, AIA  
AR 0011628  
SEAL

LICENSE NO. AA26001863

**WINDMILL PARK**  
700 LYONS ROAD  
COCONUT CREEK, FL 33063  
CLIENT: CITY OF COCONUT CREEK

REV	DATE	DESCRIPTION
1/A	12/14/15	DRG REVIEW COMMENTS

DESIGN DELIVERABLE: PERMIT SET  
ISSUE DATE: 01/26/16

PROJECT NUMBER: 1252-140622  
DRAWN BY: KW  
CHECKED BY: MS  
Copyright (c) by SYNALOVSKI ROMANIK SAYE  
All Rights Reserved.

SHEET TITLE:  
**DOG PAVILLION ELEVATIONS**

SHEET NUMBER:  
**A2-1.2**

E:\1252-140622 Windmill Park Improvements\DWG\01.2 Dog Pavilion ELEV.dwg 1/26/16 1:21:05 PM