

FORCED RELOCATION
LYONS RD
SOUTH

TOTAL UNDERGROUND FOOTAGE = 3,581'
DIRECTIONAL BORE = 3,581'
2" HDPE CONDUIT = 3,581'
24"X36"X30" HANDHOLES = 5

- 001

—


COVER
- 002-006

—


PLAN VIEWS
- 007-012

—

PROFILES

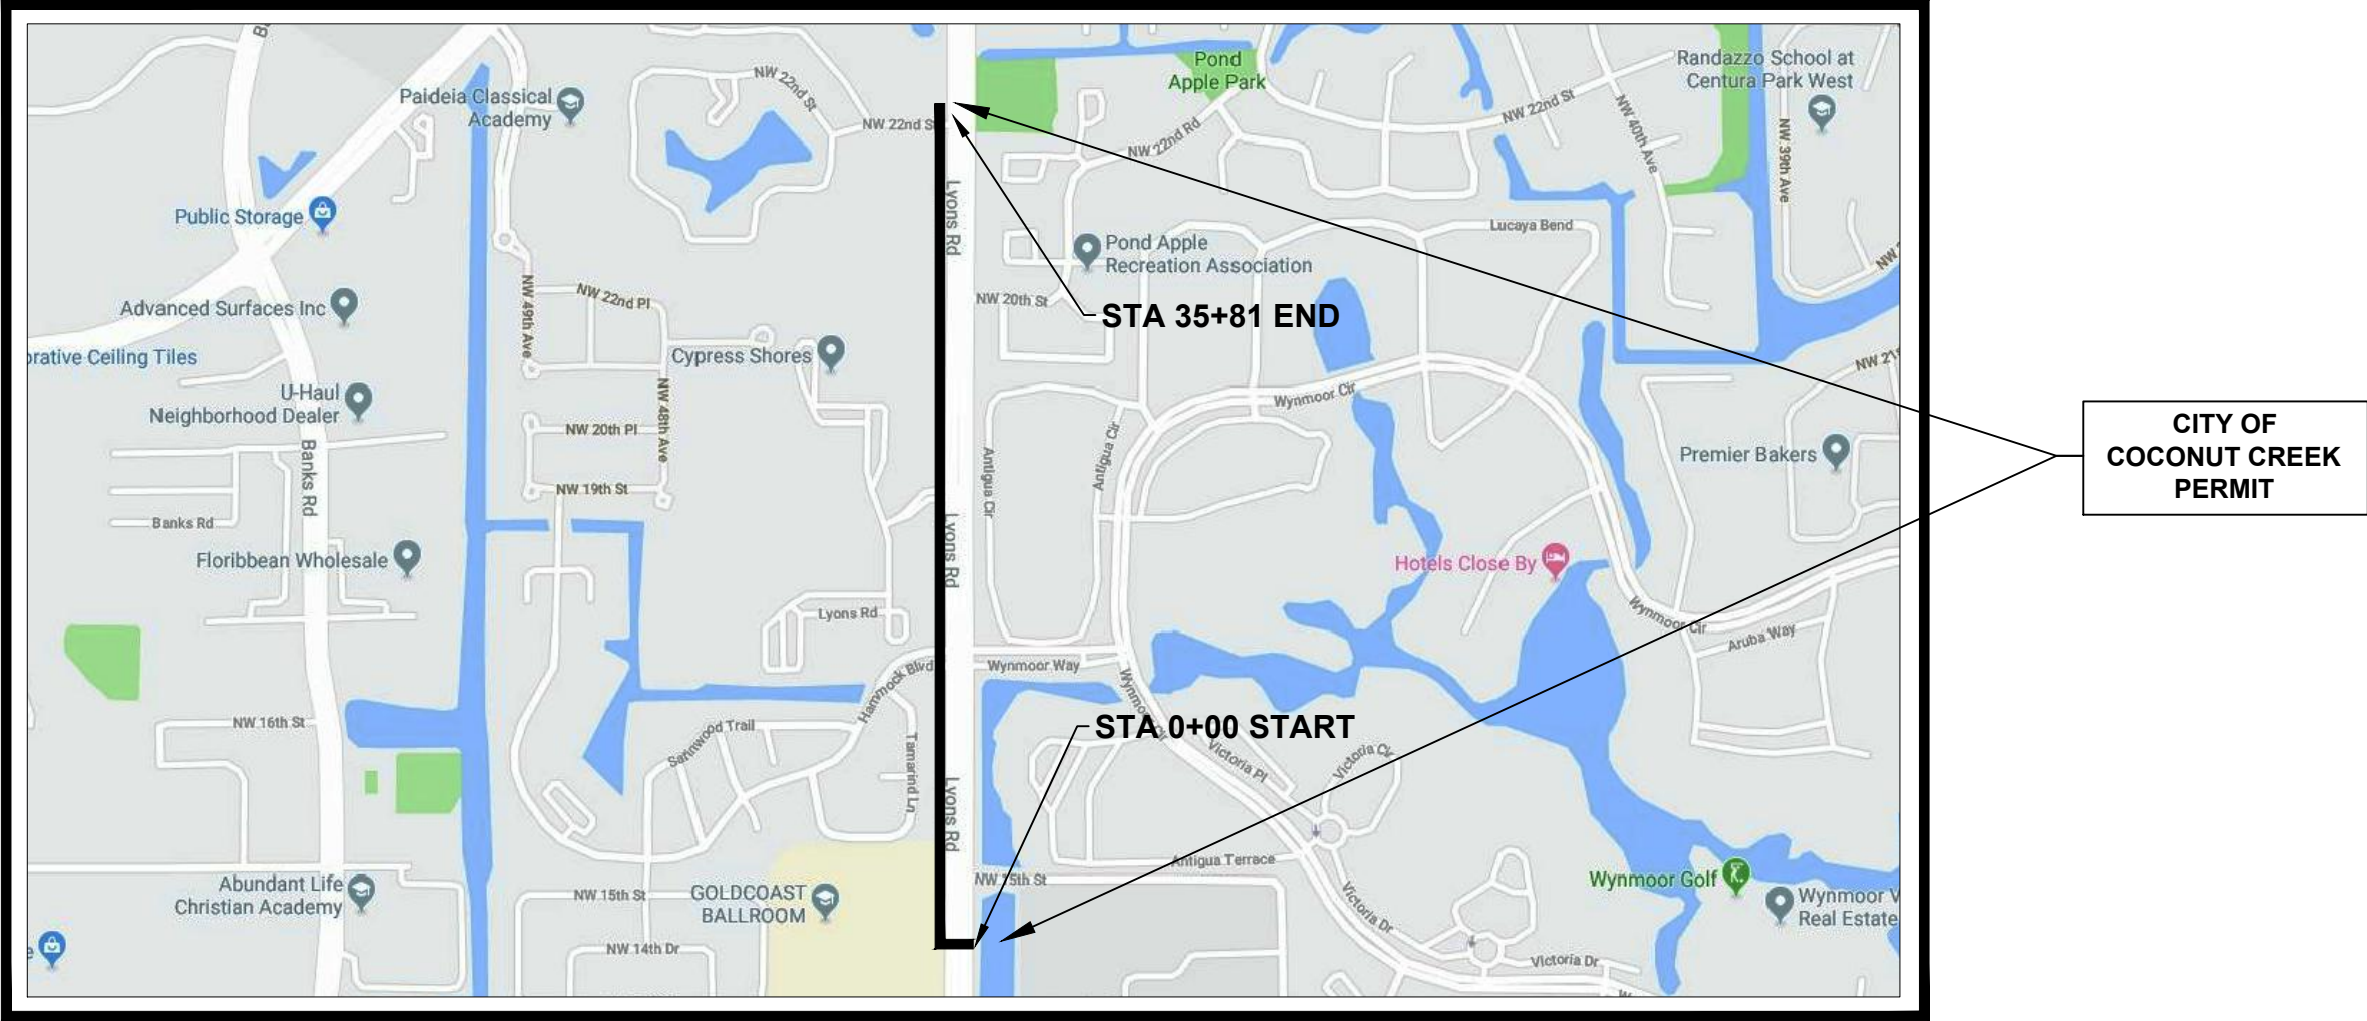

LOCATION MAP
NTS

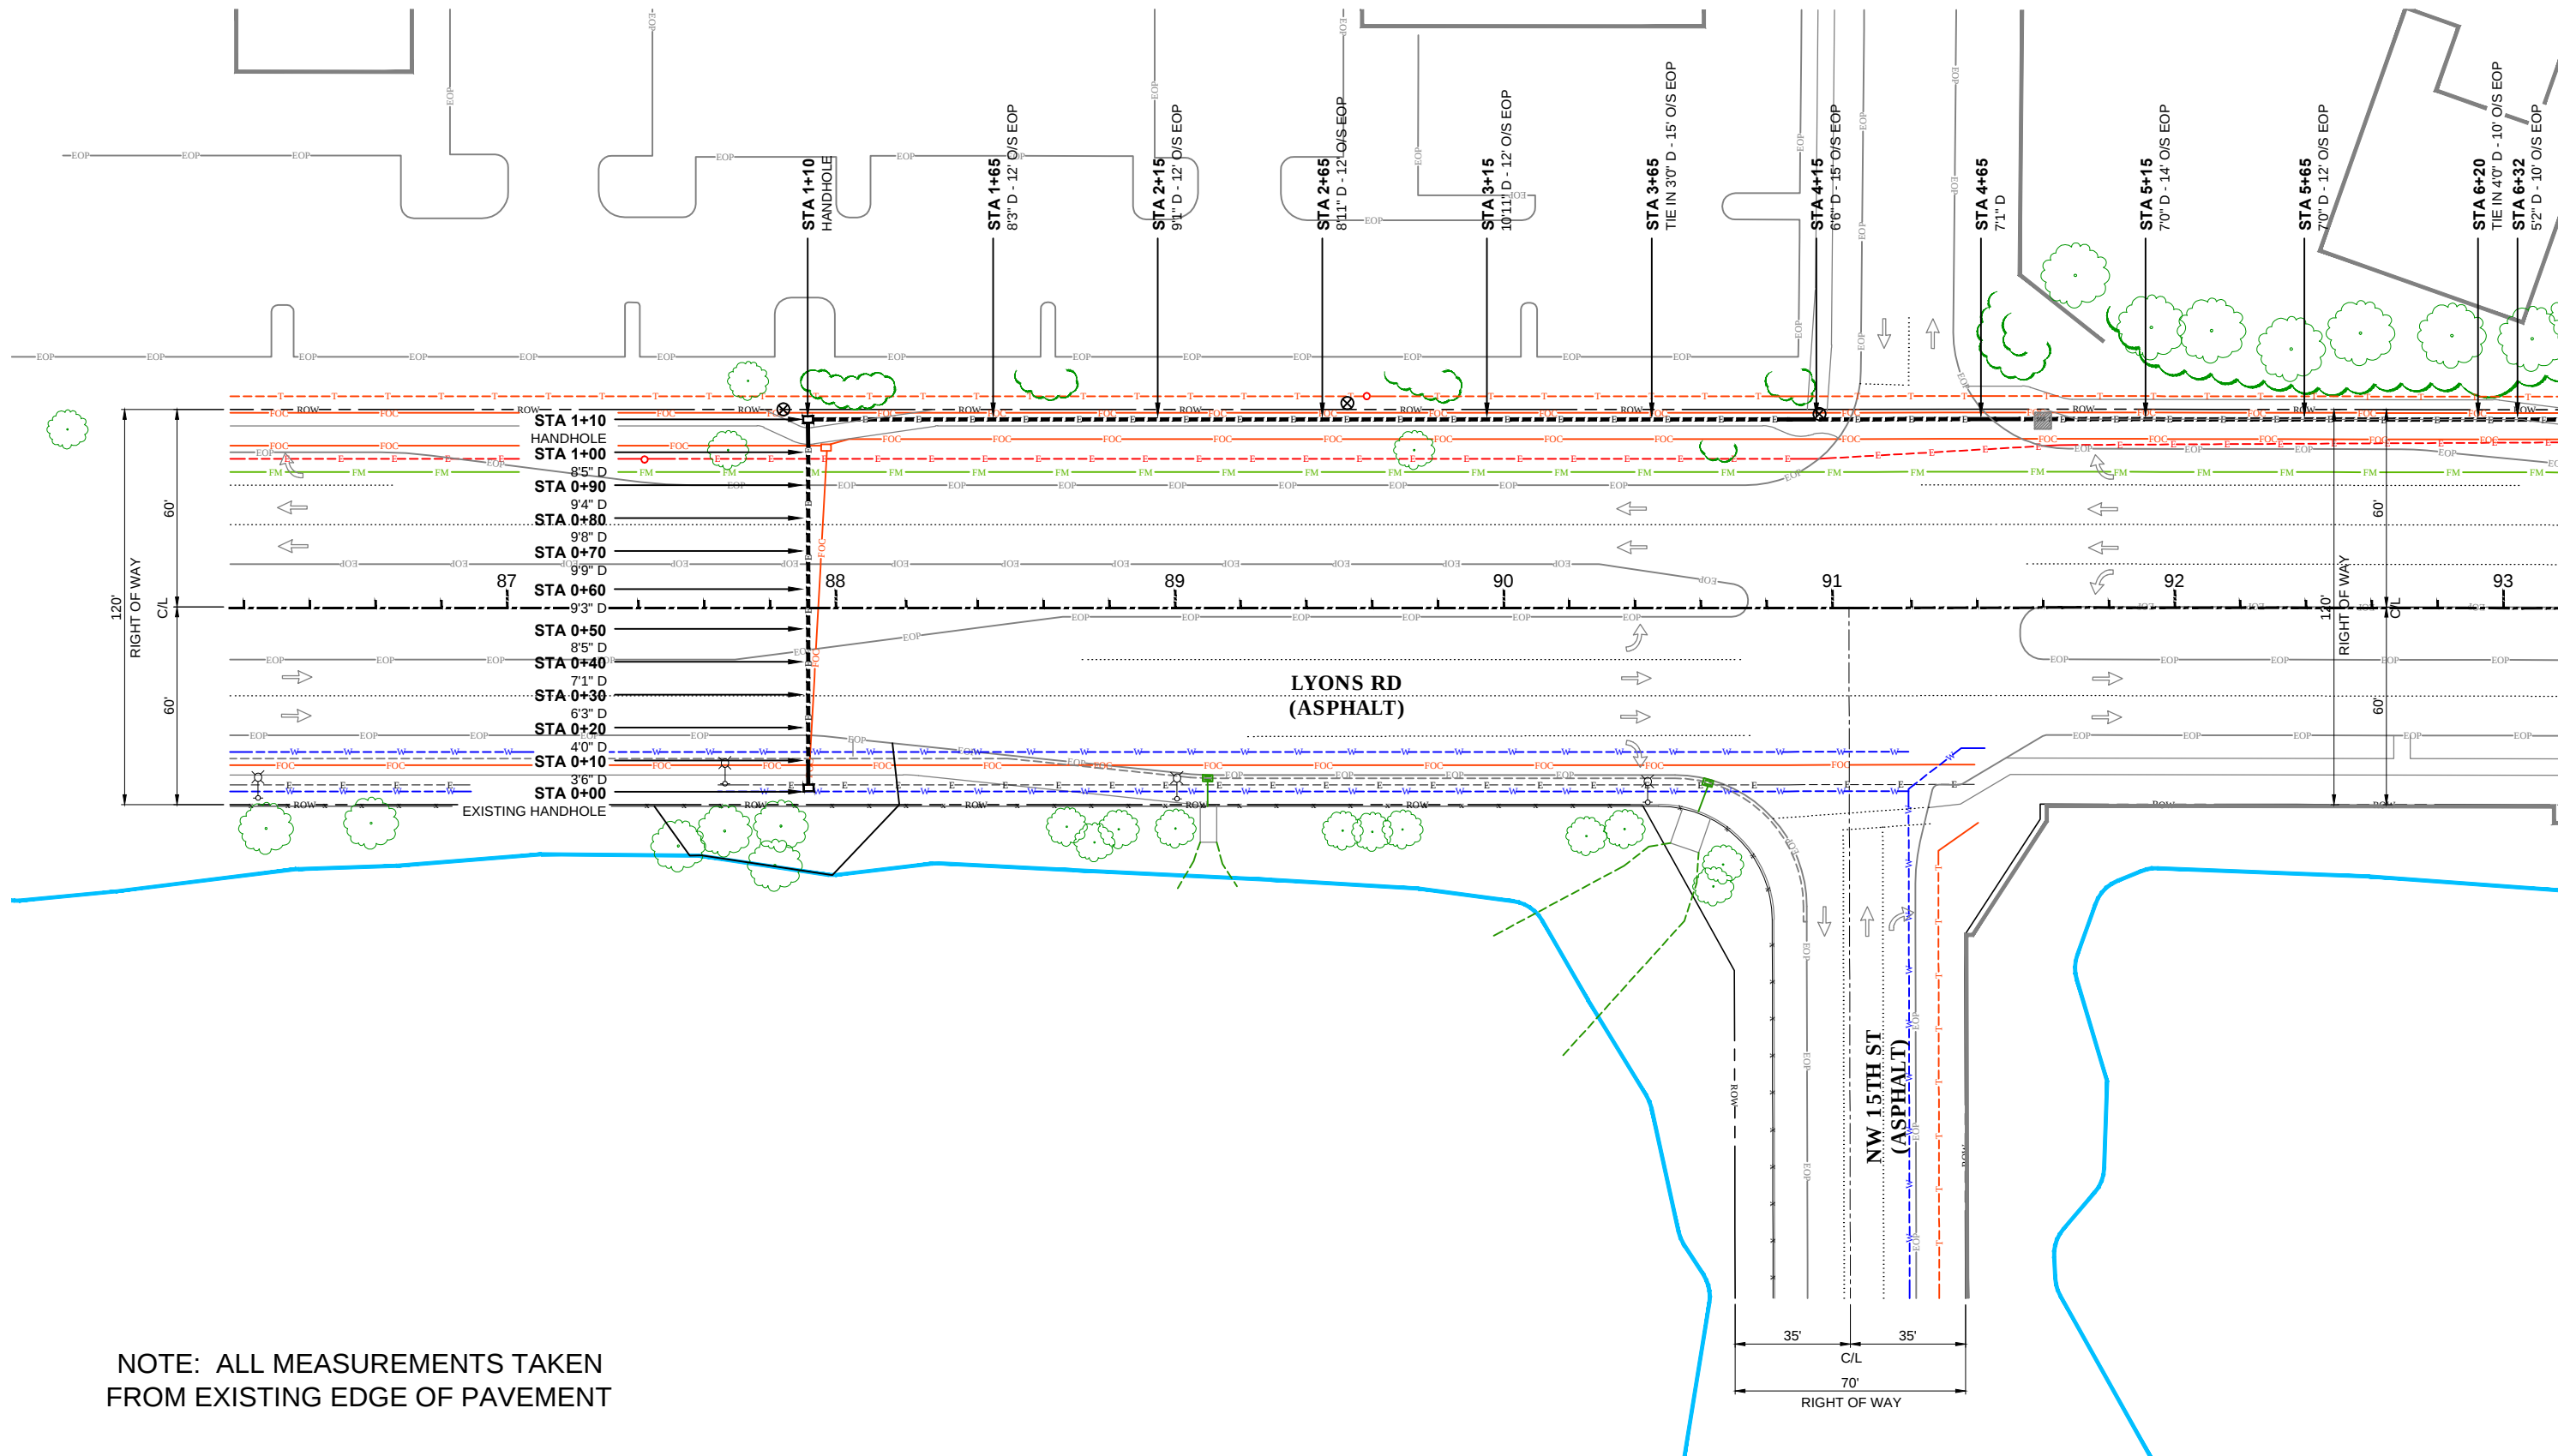

NOTE: ALL MEASUREMENTS TAKEN FROM EXISTING EDGE OF PAVEMENT

MATCH TO SHEET 003 - STA 6+45




REV.	DATE	DESCRIPTION
	080119	FIRST SUBMITTAL
	111419	AS BUILT


PROJECT:	FORCED RELOCATION LYONS RD SOUTH AS BUILT
SCALE:	1"=50'
FILE NAME:	FR-LYONS RD - SOUTH.DWG
DATE:	11/14/19
DRAWING:	CADDERCOMM

COUNTY:	BROWARD
CITY:	COCONUT CREEK
LOCATION:	LYONS RD
TOWNSHIP:	48S
RANGE:	42E
SECTION:	20

SHEET NUMBER	002 OF 012
TRACKING #:	ASK-SE-1553

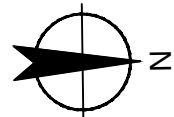

MATCH TO SHEET 002 - STA 6+45

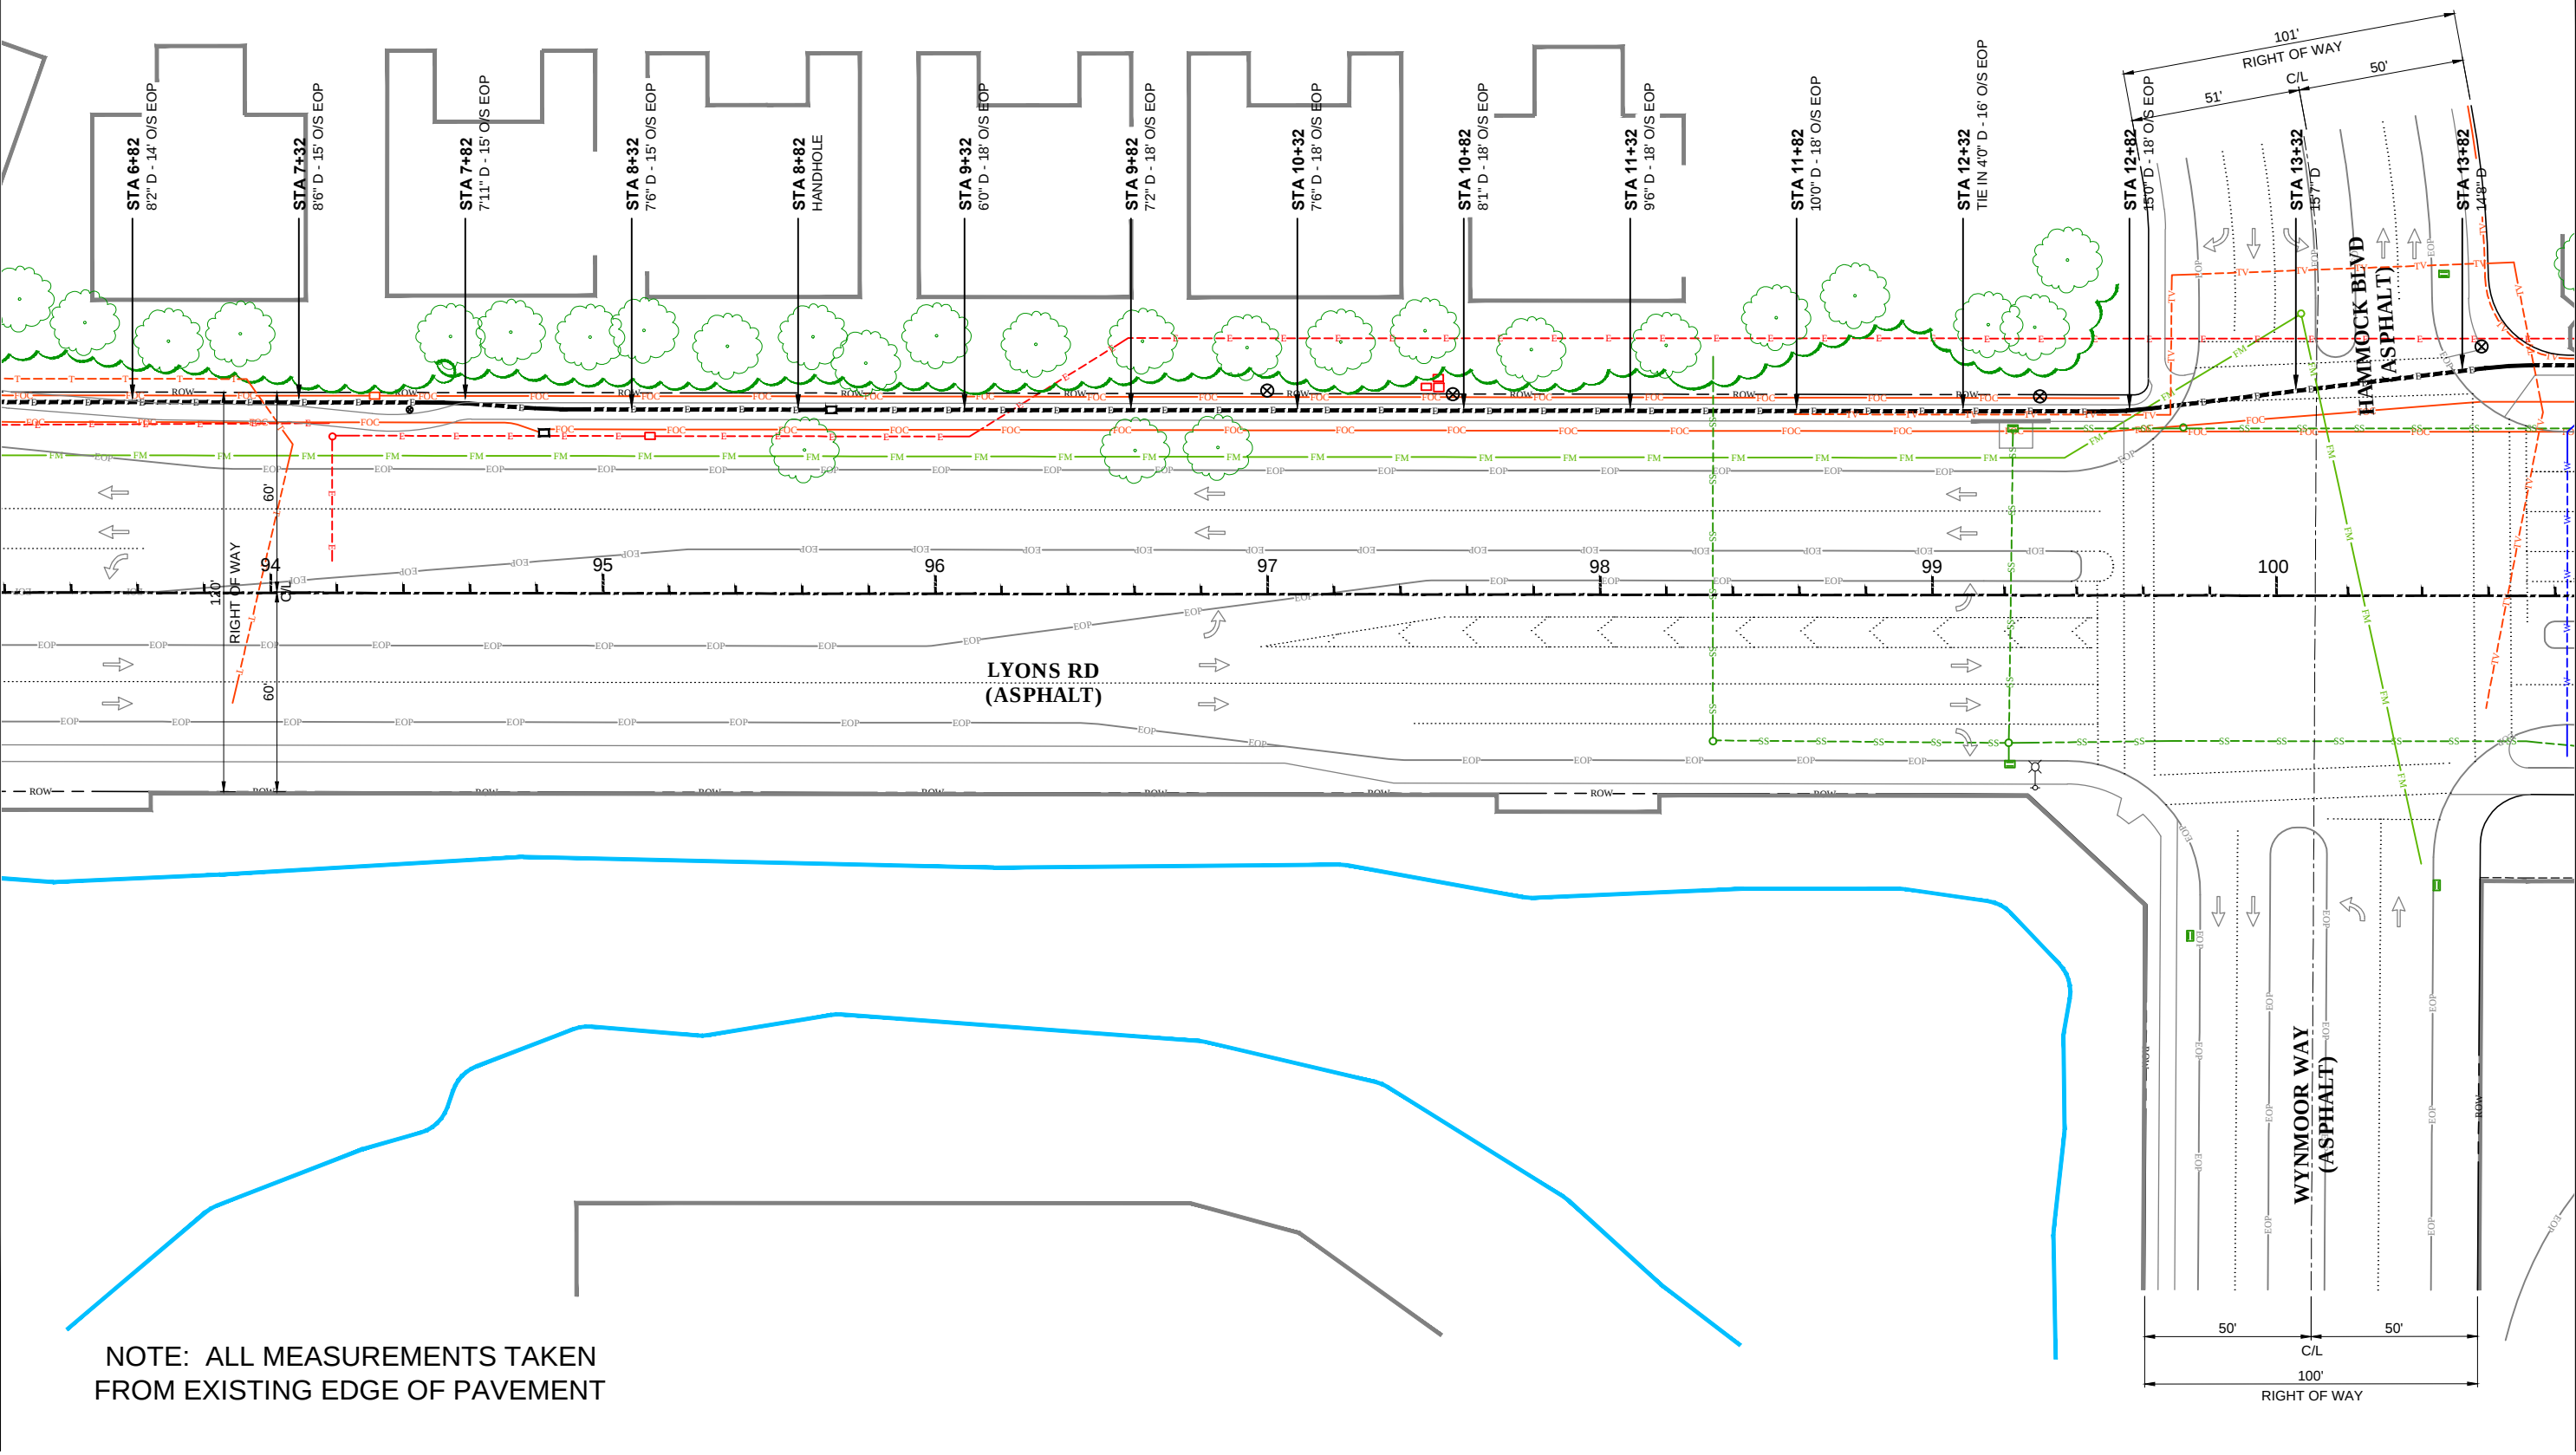

MATCH TO SHEET 004 - STA 14+20

NOTE: ALL MEASUREMENTS TAKEN FROM EXISTING EDGE OF PAVEMENT



REV.	DATE	DESCRIPTION
	080119	FIRST SUBMITTAL
	111419	AS BUILT

PROJECT:
**FORCED RELOCATION
LYONS RD SOUTH
AS BUILT**

SCALE: 1"=50'

FILE NAME: FR-LYONS RD - SOUTH.DWG

DATE: 11/14/19

DRAWING: CADDERCORE

COUNTY: BROWARD


CITY: COCONUT CREEK

LOCATION: LYONS RD


TOWNSHIP: 48S RANGE: 42E SECTION: 20

SHEET NUMBER
003 OF 012

TRACKING #:
ASK-SE-1553

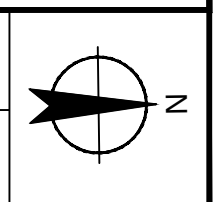

MATCH TO SHEET 003 - STA 14+20

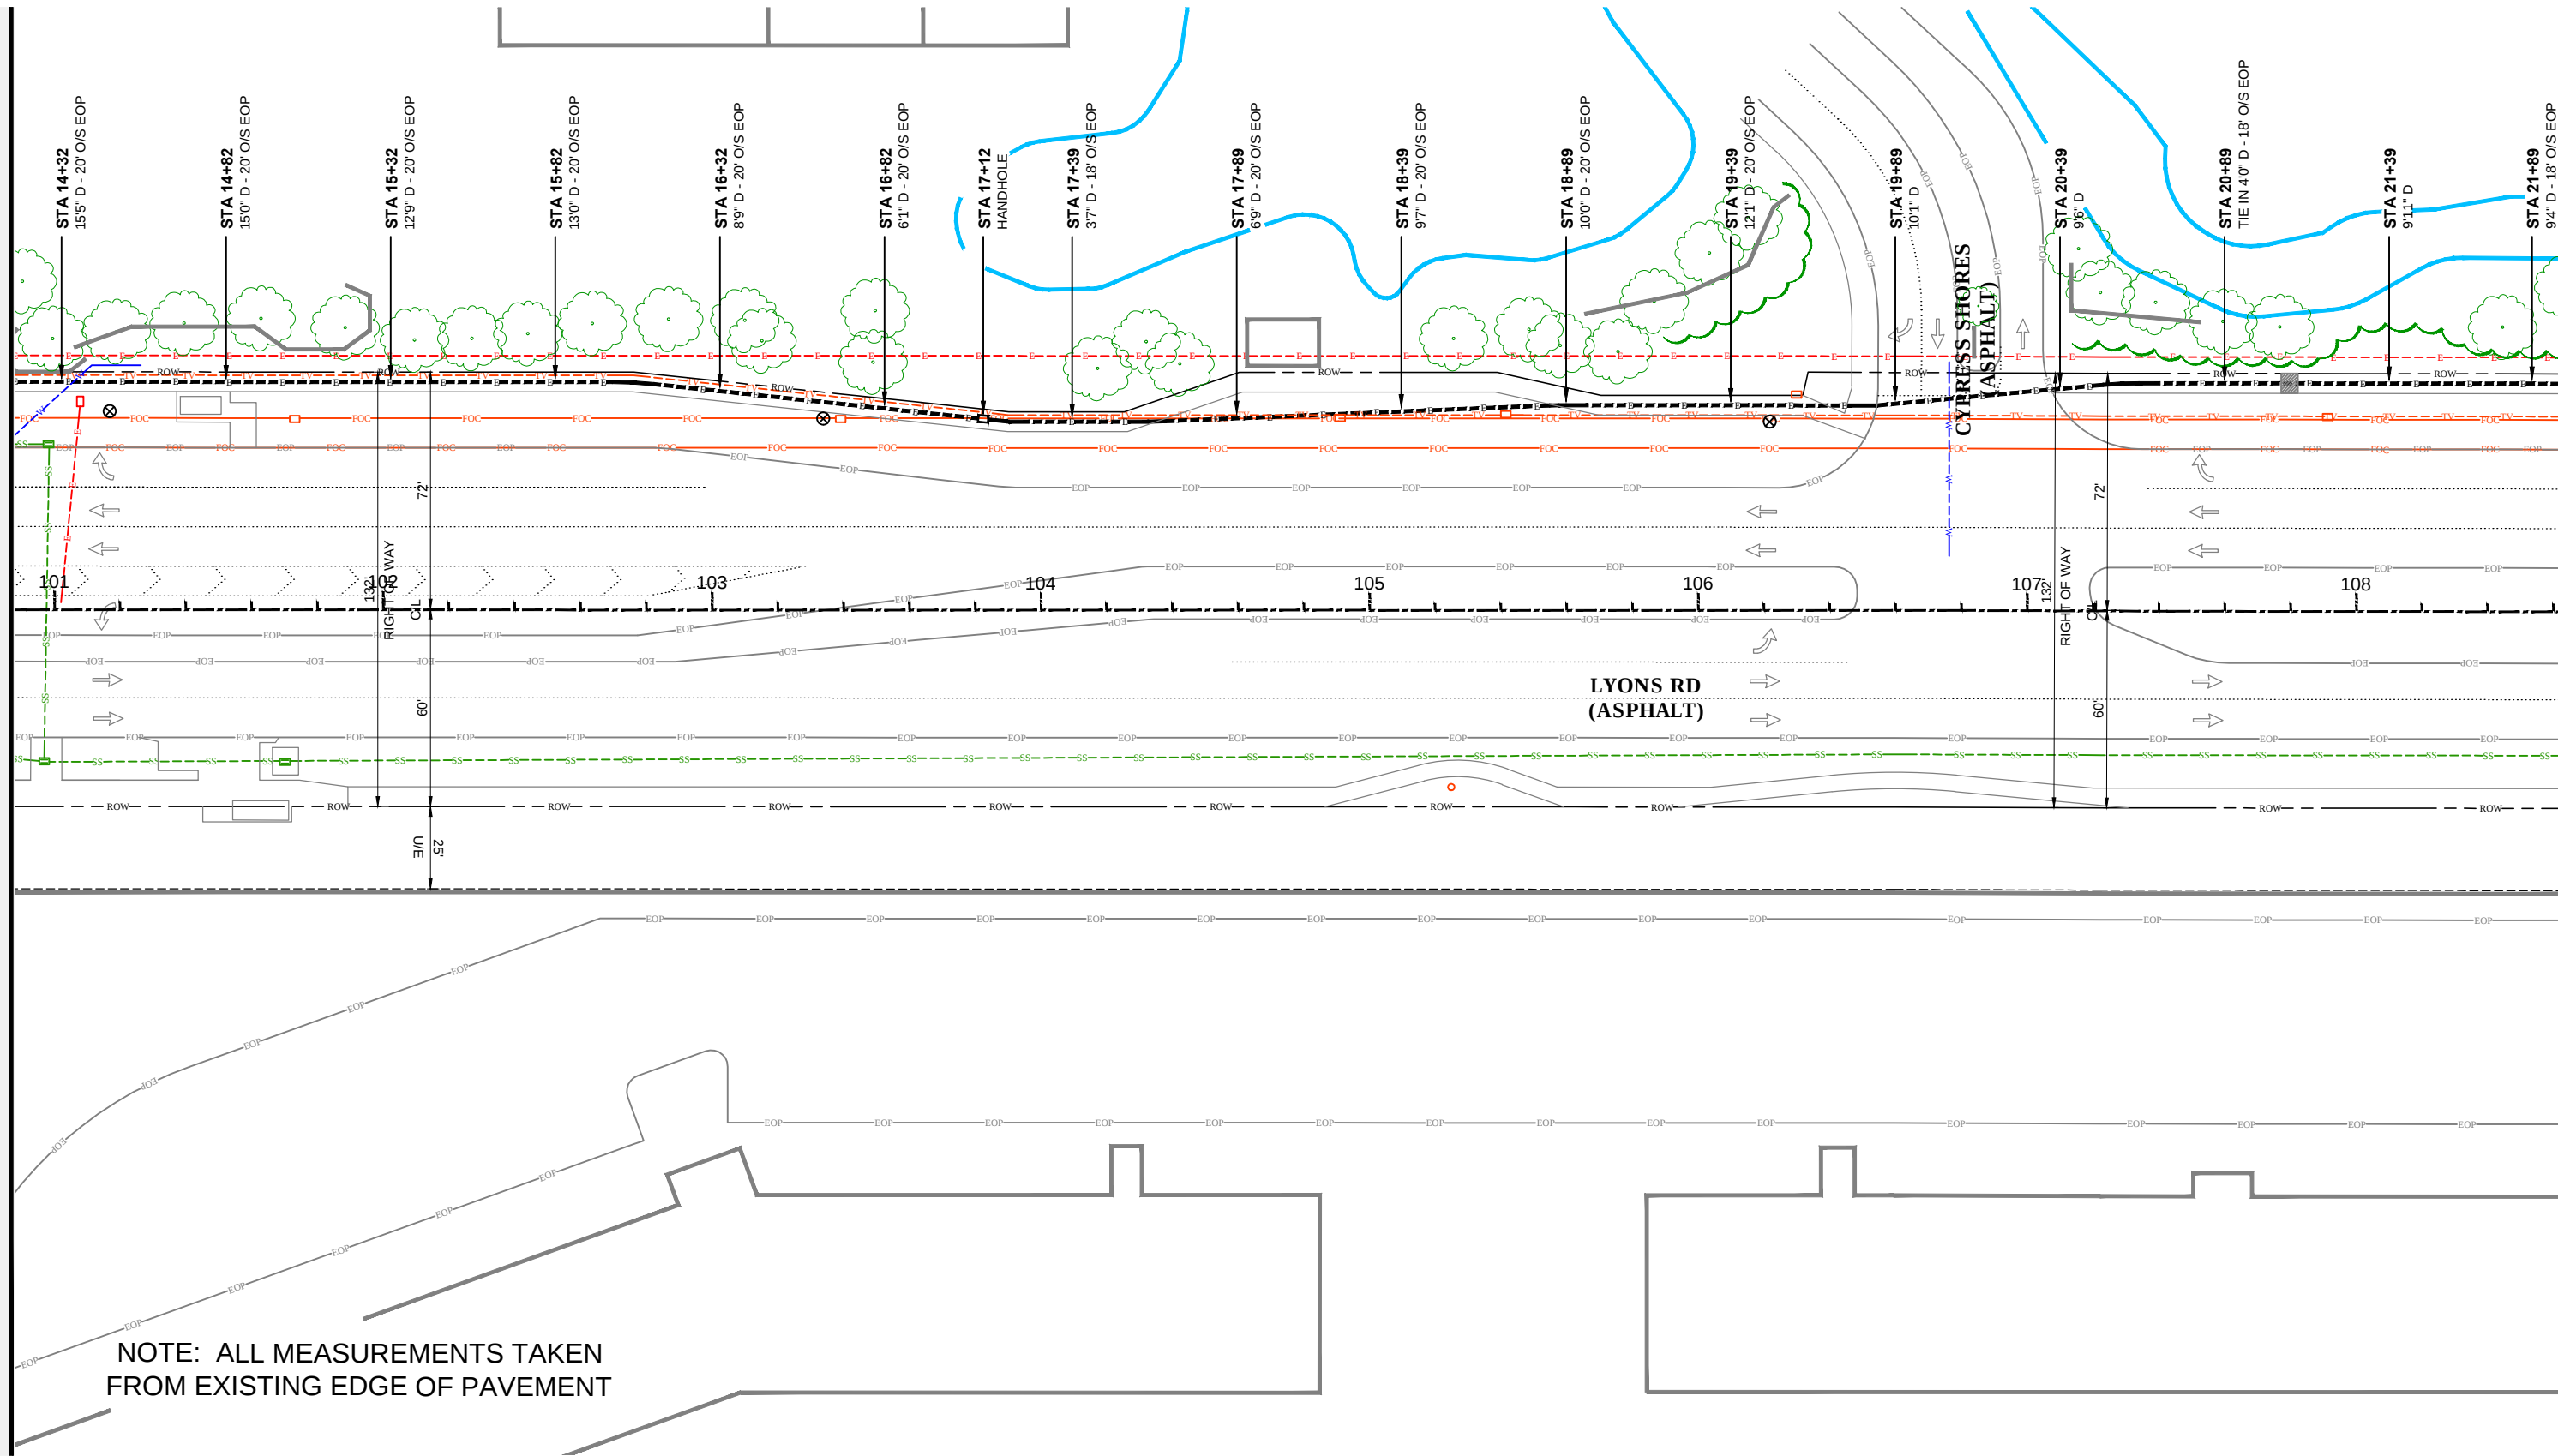

MATCH TO SHEET 005 - STA 21+95




REV.	DATE	DESCRIPTION
	080119	FIRST SUBMITTAL
	111419	AS BUILT


PROJECT:	FORCED RELOCATION LYONS RD SOUTH AS BUILT
SCALE:	1"=50'
FILE NAME:	FR-LYONS RD - SOUTH.DWG
DATE:	11/14/19
DRAWING:	CADDERCOMM

COUNTY:	BROWARD
CITY:	COCONUT CREEK
LOCATION:	LYONS RD
TOWNSHIP:	48S
RANGE:	42E
SECTION:	20

SHEET NUMBER	004 OF 012
TRACKING #:	ASK-SE-1553

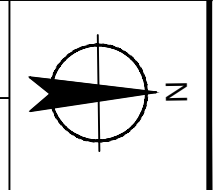

MATCH TO SHEET 004 - STA 21+95

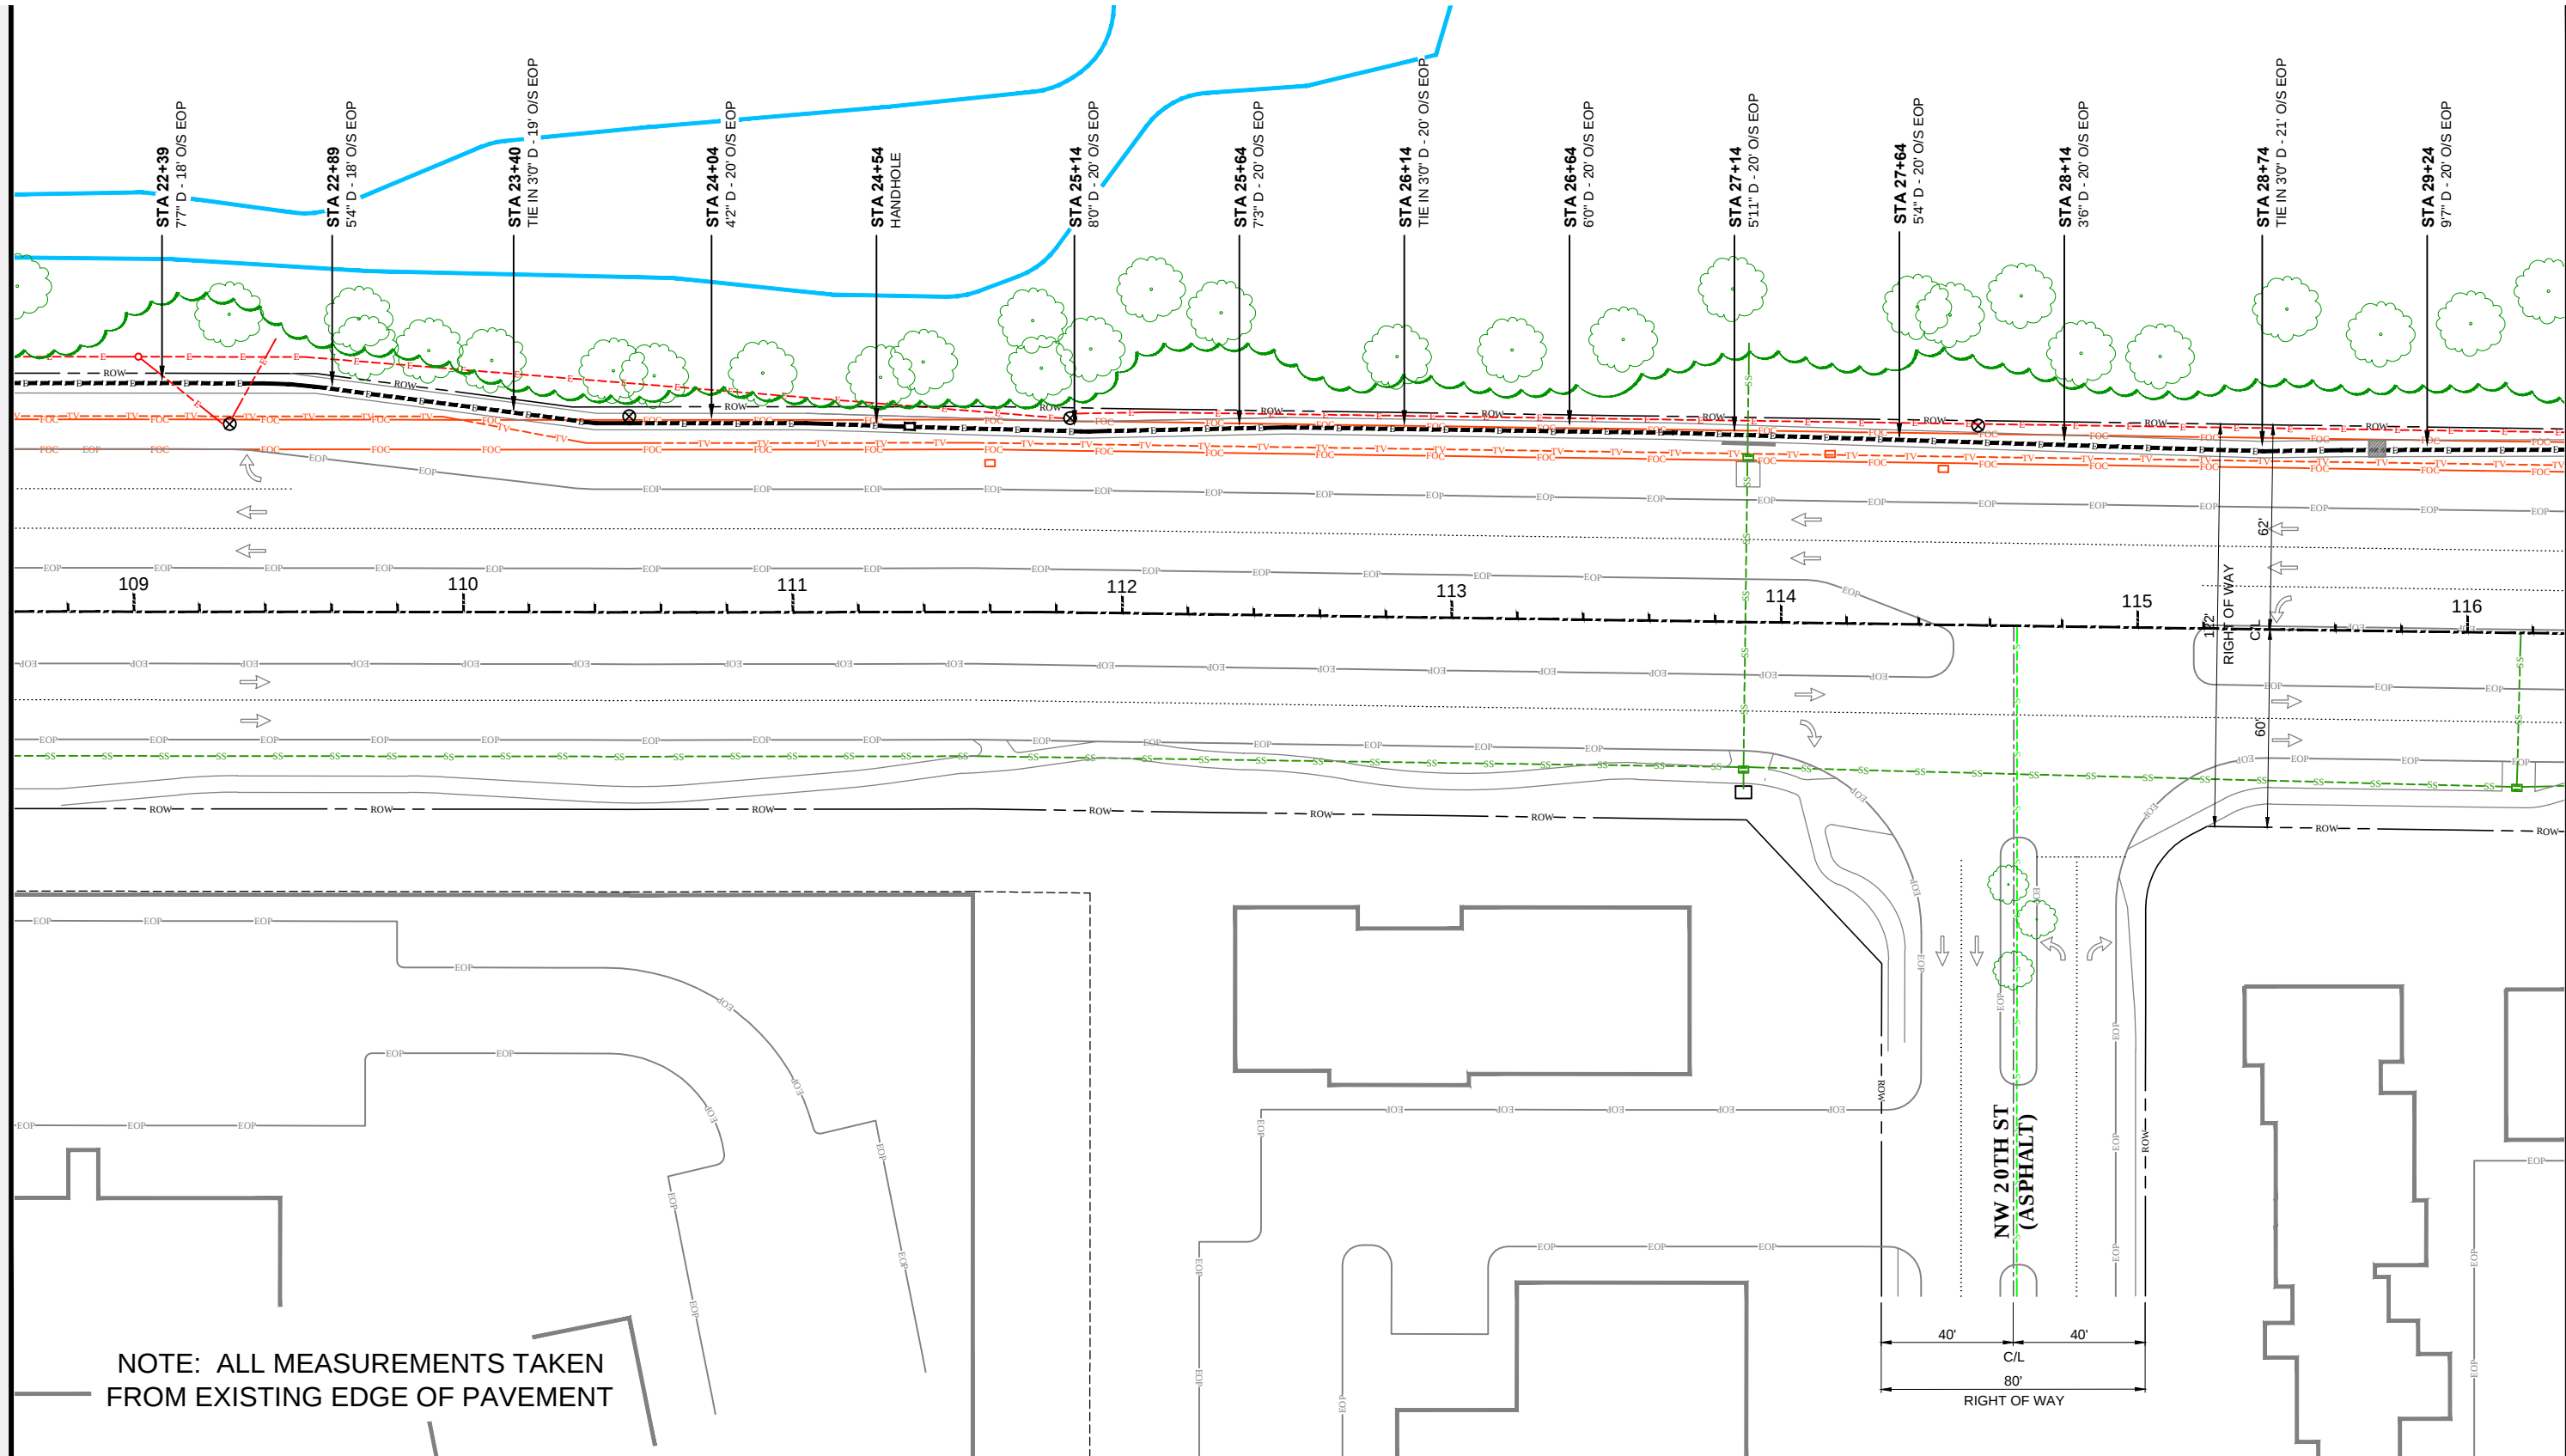

MATCH TO SHEET 006 - STA 29+70

NOTE: ALL MEASUREMENTS TAKEN FROM EXISTING EDGE OF PAVEMENT




REV.	DATE	DESCRIPTION
	080119	FIRST SUBMITTAL
	111419	AS BUILT


PROJECT:	FORCED RELOCATION LYONS RD SOUTH AS BUILT
SCALE :	1"=50'
FILE NAME :	FR-LYONS RD - SOUTH.DWG
DATE :	11/14/19
DRAWING :	CADDERCOMM

COUNTY:	BROWARD
CITY:	COCONUT CREEK
LOCATION:	LYONS RD
TOWNSHIP:	48S
RANGE :	42E
SECTION :	20

SHEET NUMBER	005 OF 012
TRACKING # :	ASK-SE-1553

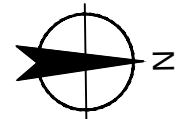

MATCH TO SHEET 005 - STA 29+70

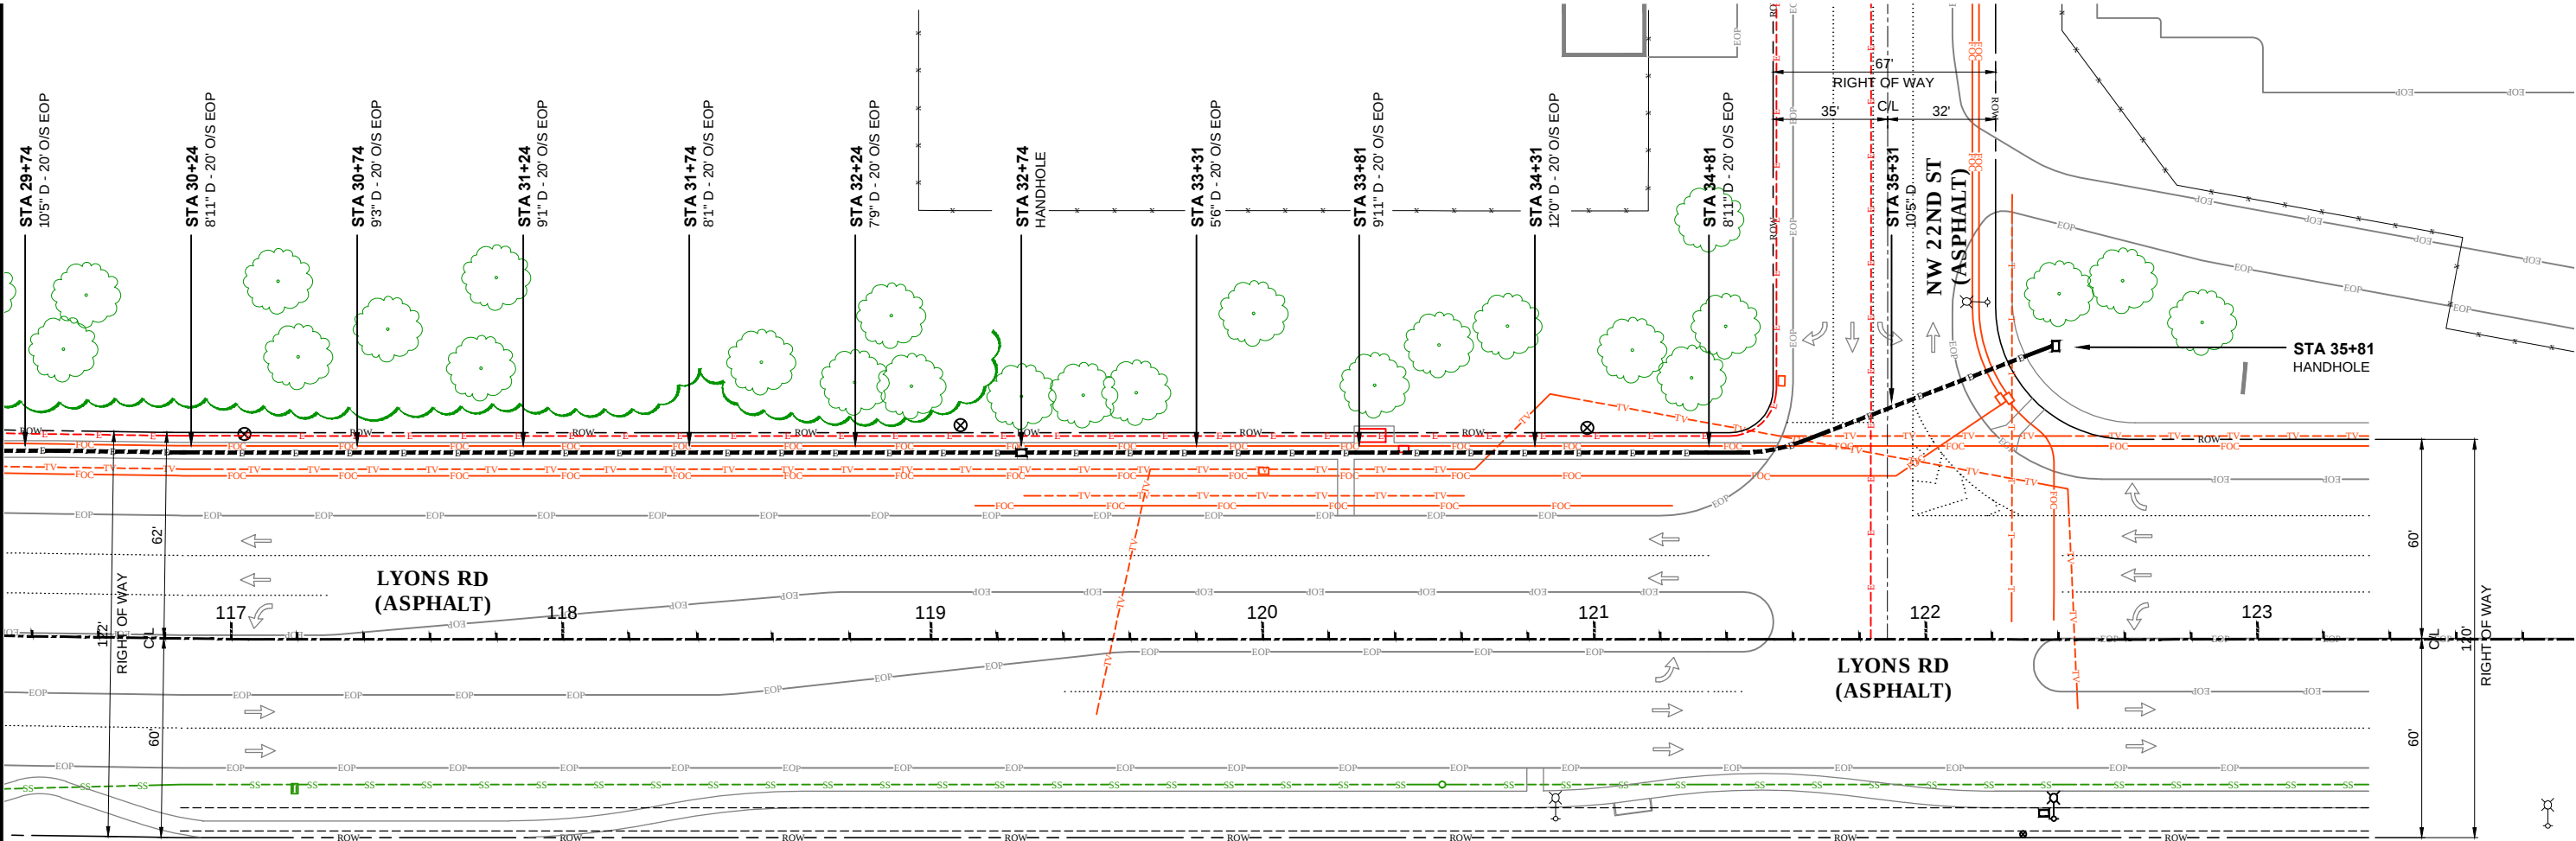

NOTE: ALL MEASUREMENTS TAKEN FROM EXISTING EDGE OF PAVEMENT



➡ DIRECTION OF ENGINEERING

REV.	DATE	DESCRIPTION
	080119	FIRST SUBMITTAL
	111419	AS BUILT

PROJECT:
**FORCED RELOCATION
LYONS RD SOUTH
AS BUILT**

SCALE : 1"=50'

FILE NAME : FR-LYONS RD - SOUTH.DWG

DATE : 11/14/19

DRAWING : CADDERRCOMM

COUNTY: BROWARD


CITY: COCONUT CREEK


LOCATION: LYONS RD

TOWNSHIP: 48S RANGE: 42E SECTION: 20


SHEET NUMBER
006 OF 012

TRACKING # :
ASK-SE-1553

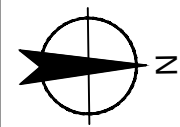

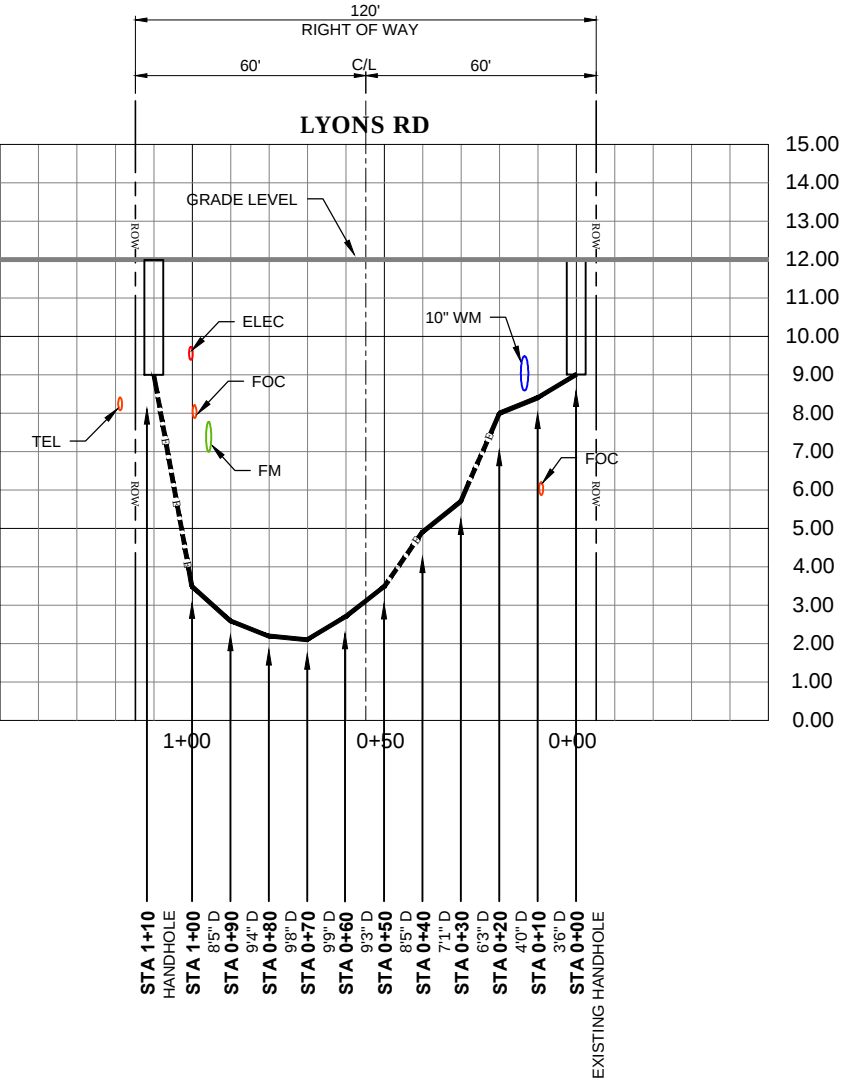

PROFILE - LYONS RD
HORIZONTAL SCALE: 1"=50'
VERTICAL SCALE: 1"=5'

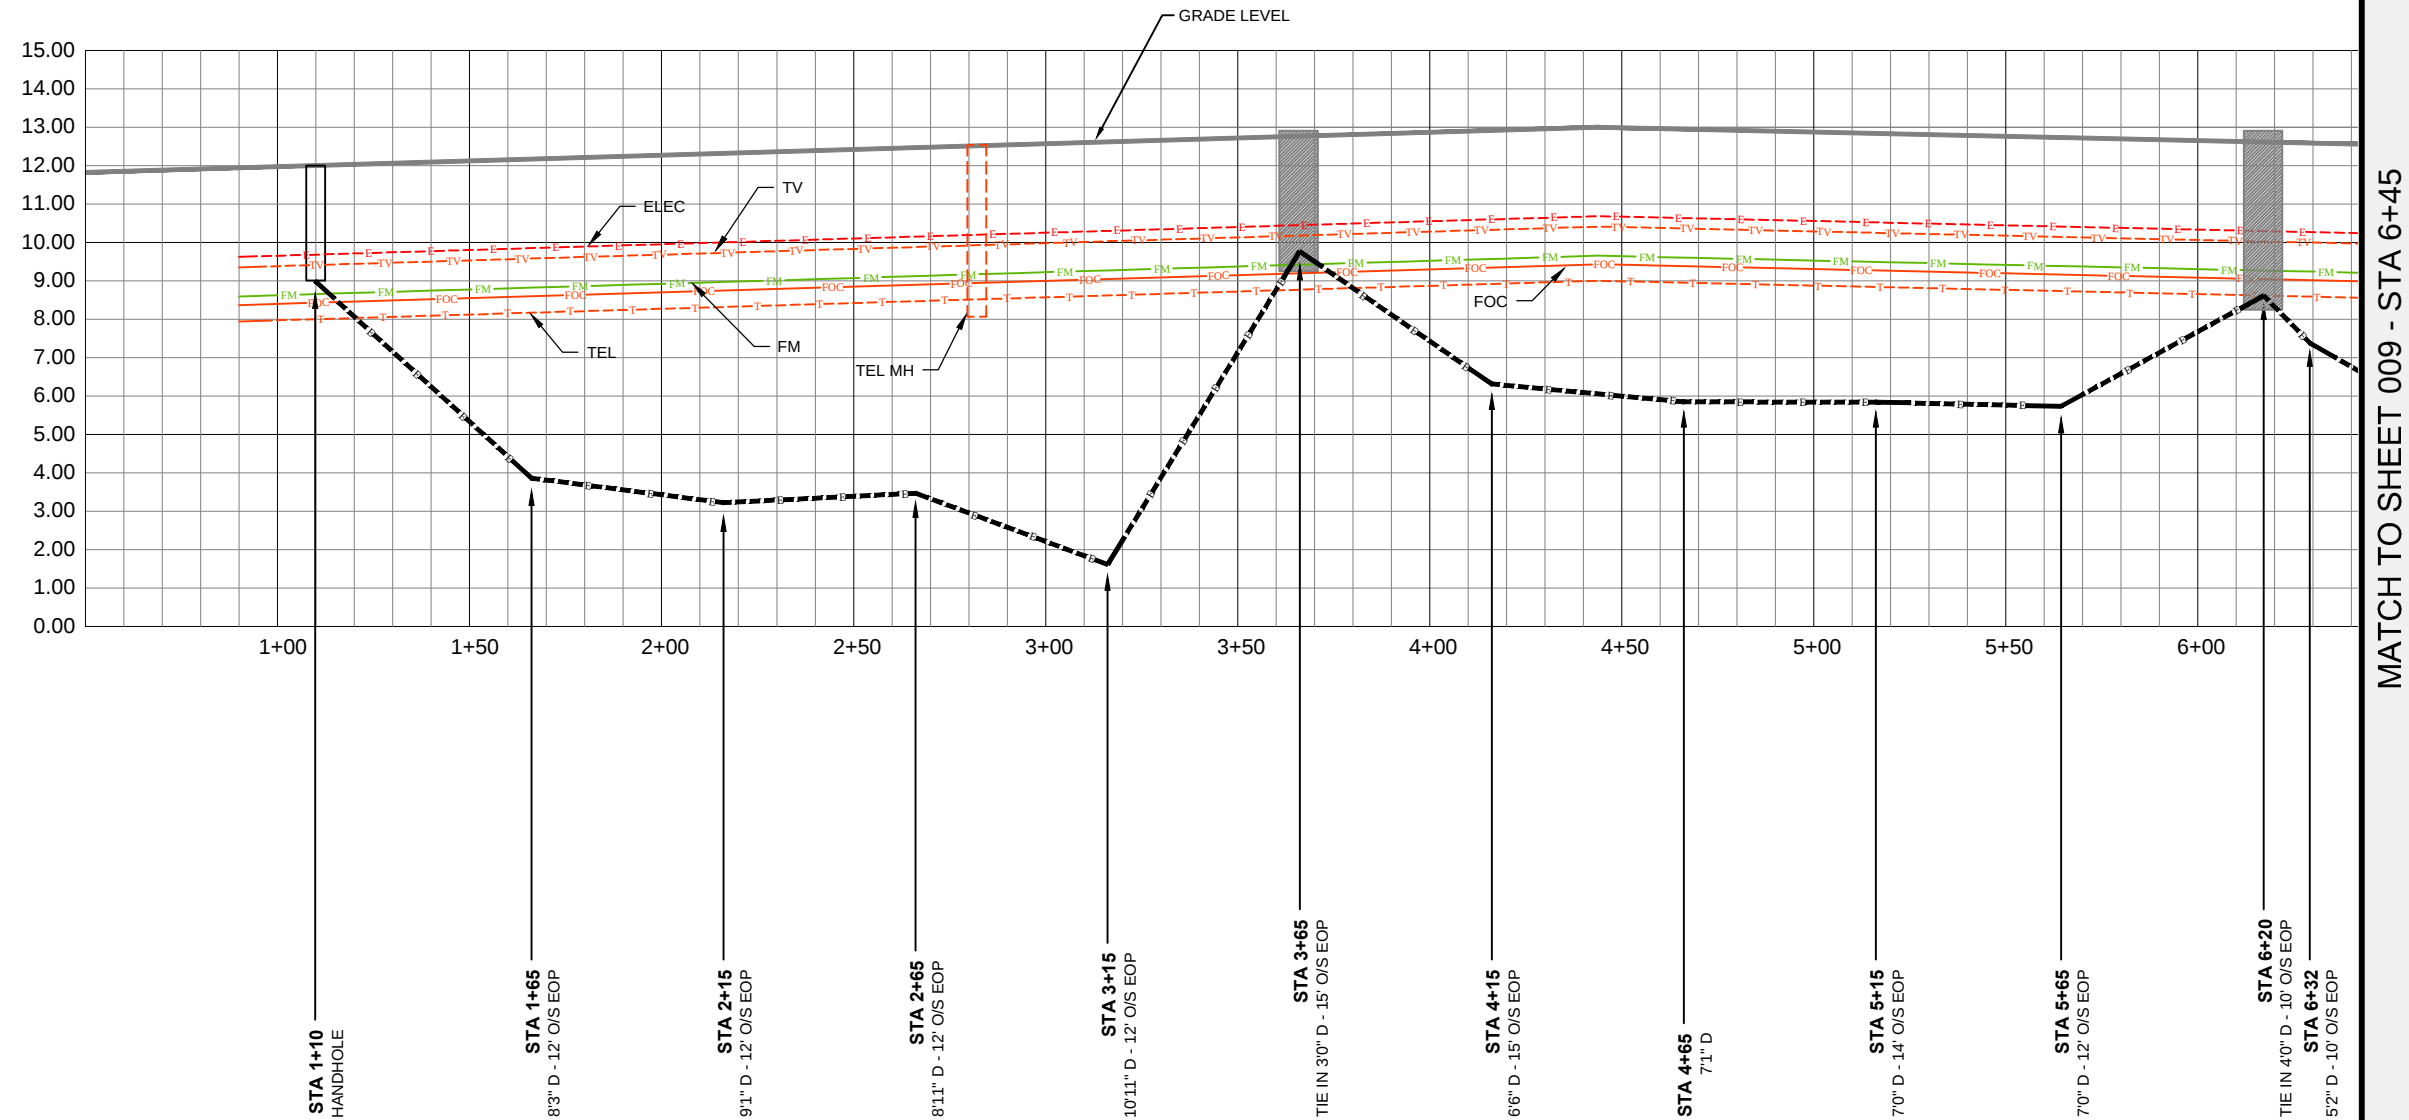

PROFILE - LYONS RD


HORIZONTAL SCALE: 1"=50'
VERTICAL SCALE: 1"=5'



DIRECTION OF ENGINEERING

REV.	DATE	DESCRIPTION	PROJECT:	COUNTY:	SHEET NUMBER	
	080119	FIRST SUBMITTAL	FORCED RELOCATION LYONS RD SOUTH AS BUILT	BROWARD	008 OF 012	
	111419	AS BUILT		COCONUT CREEK		
			SCALE :	LOCATION:	TRACKING # : ASK-SE-1553	
			FILE NAME :	LYONS RD		
			DATE :	TOWNSHIP :		
			DRAWING :	RANGE :	SECTION :	
				48S	42E	20

MATCH TO SHEET 008 - STA 6+45

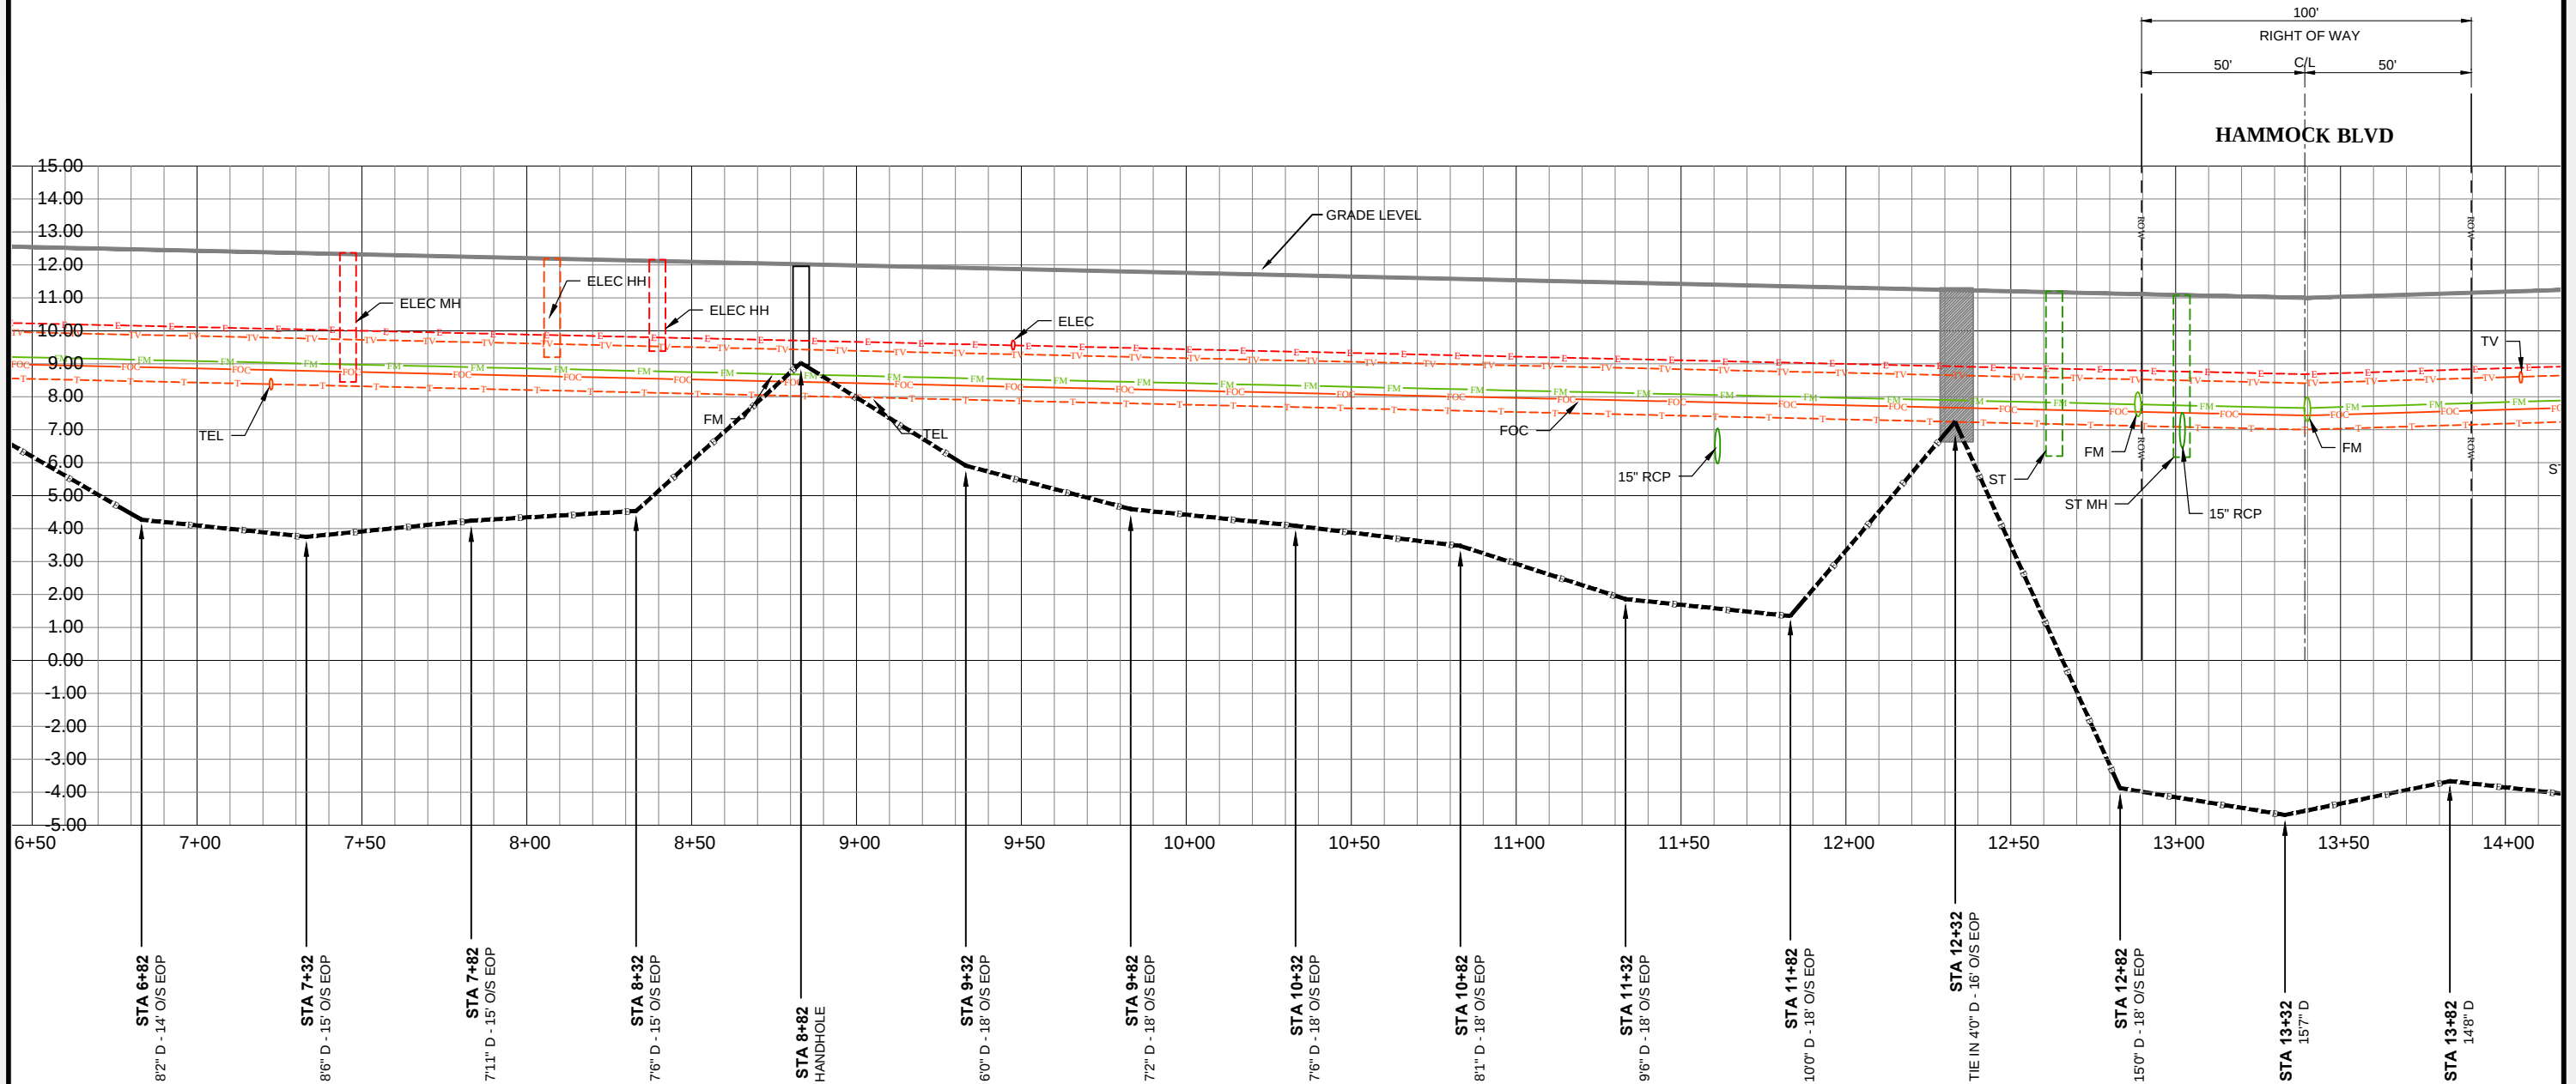

MATCH TO SHEET 010 - STA 14+20

PROFILE - LYONS RD

HORIZONTAL SCALE: 1"=50'
VERTICAL SCALE: 1"=5'



DIRECTION OF ENGINEERING


REV.	DATE	DESCRIPTION
	080119	FIRST SUBMITTAL
	111419	AS BUILT

PROJECT:	FORCED RELOCATION LYONS RD SOUTH AS BUILT
SCALE:	1"=50'
FILE NAME:	FR-LYONS RD - SOUTH.DWG
DATE:	11/14/19
DRAWING:	CADDERCOMM

COUNTY:	BROWARD
CITY:	COCONUT CREEK
LOCATION:	LYONS RD
TOWNSHIP:	48S
RANGE:	42E
SECTION:	20

SHEET NUMBER	009 OF 012
TRACKING #:	ASK-SE-1553

MATCH TO SHEET 009 - STA 14+20

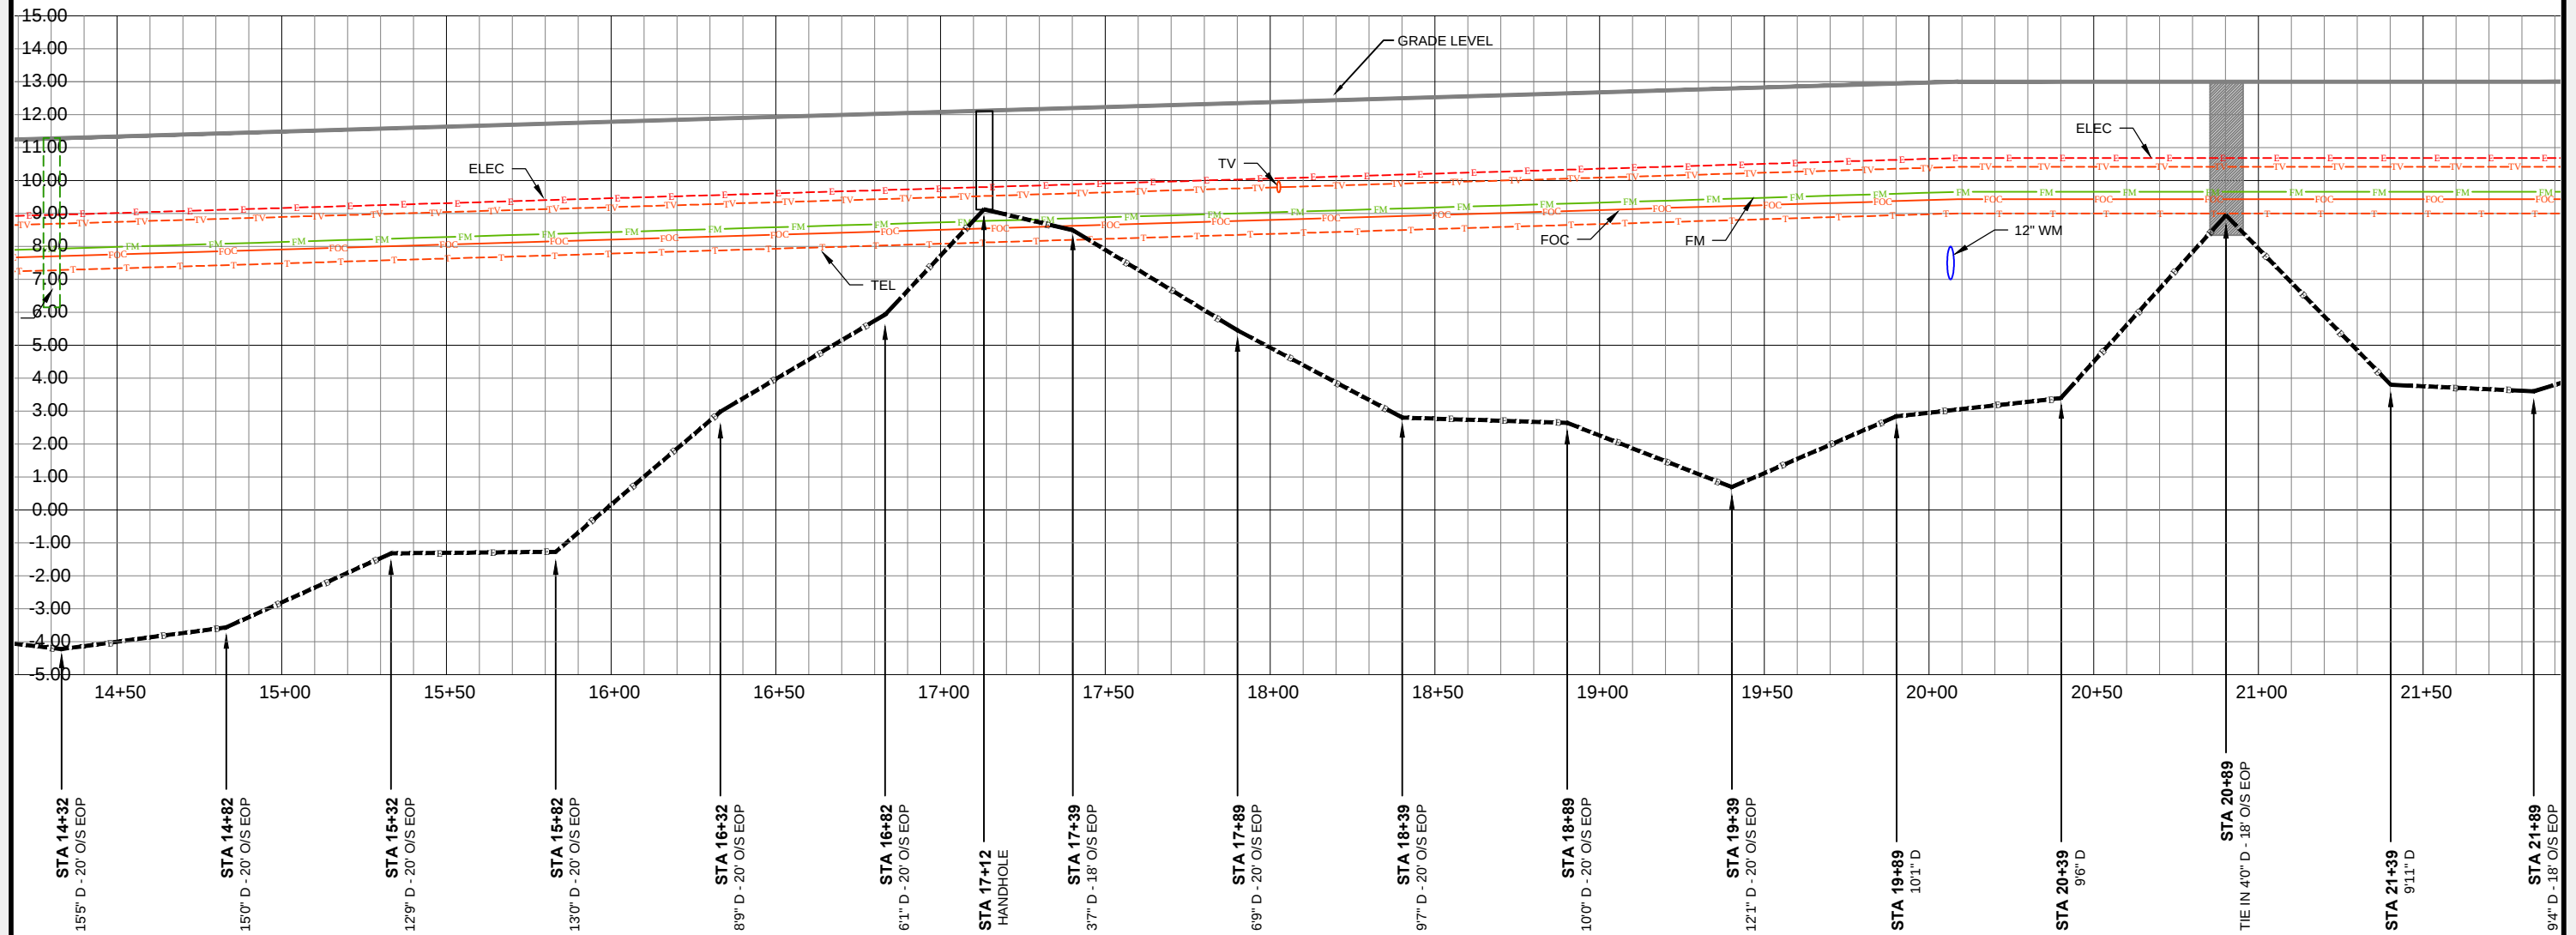

MATCH TO SHEET 011 - STA 21+95

PROFILE - LYONS RD
HORIZONTAL SCALE: 1"=50'
VERTICAL SCALE: 1"=5'



DIRECTION OF ENGINEERING


REV.	DATE	DESCRIPTION
	080119	FIRST SUBMITTAL
	111419	AS BUILT

PROJECT:	FORCED RELOCATION LYONS RD SOUTH AS BUILT
SCALE :	1"=50'
FILE NAME :	FR-LYONS RD - SOUTH.DWG
DATE :	11/14/19
DRAWING :	CADDERCOMM

COUNTY:	BROWARD
CITY:	COCONUT CREEK
LOCATION:	LYONS RD
TOWNSHIP :	48S
RANGE :	42E
SECTION :	20

SHEET NUMBER	010 OF 012
TRACKING # :	ASK-SE-1553

MATCH TO SHEET 010 - STA 21+95

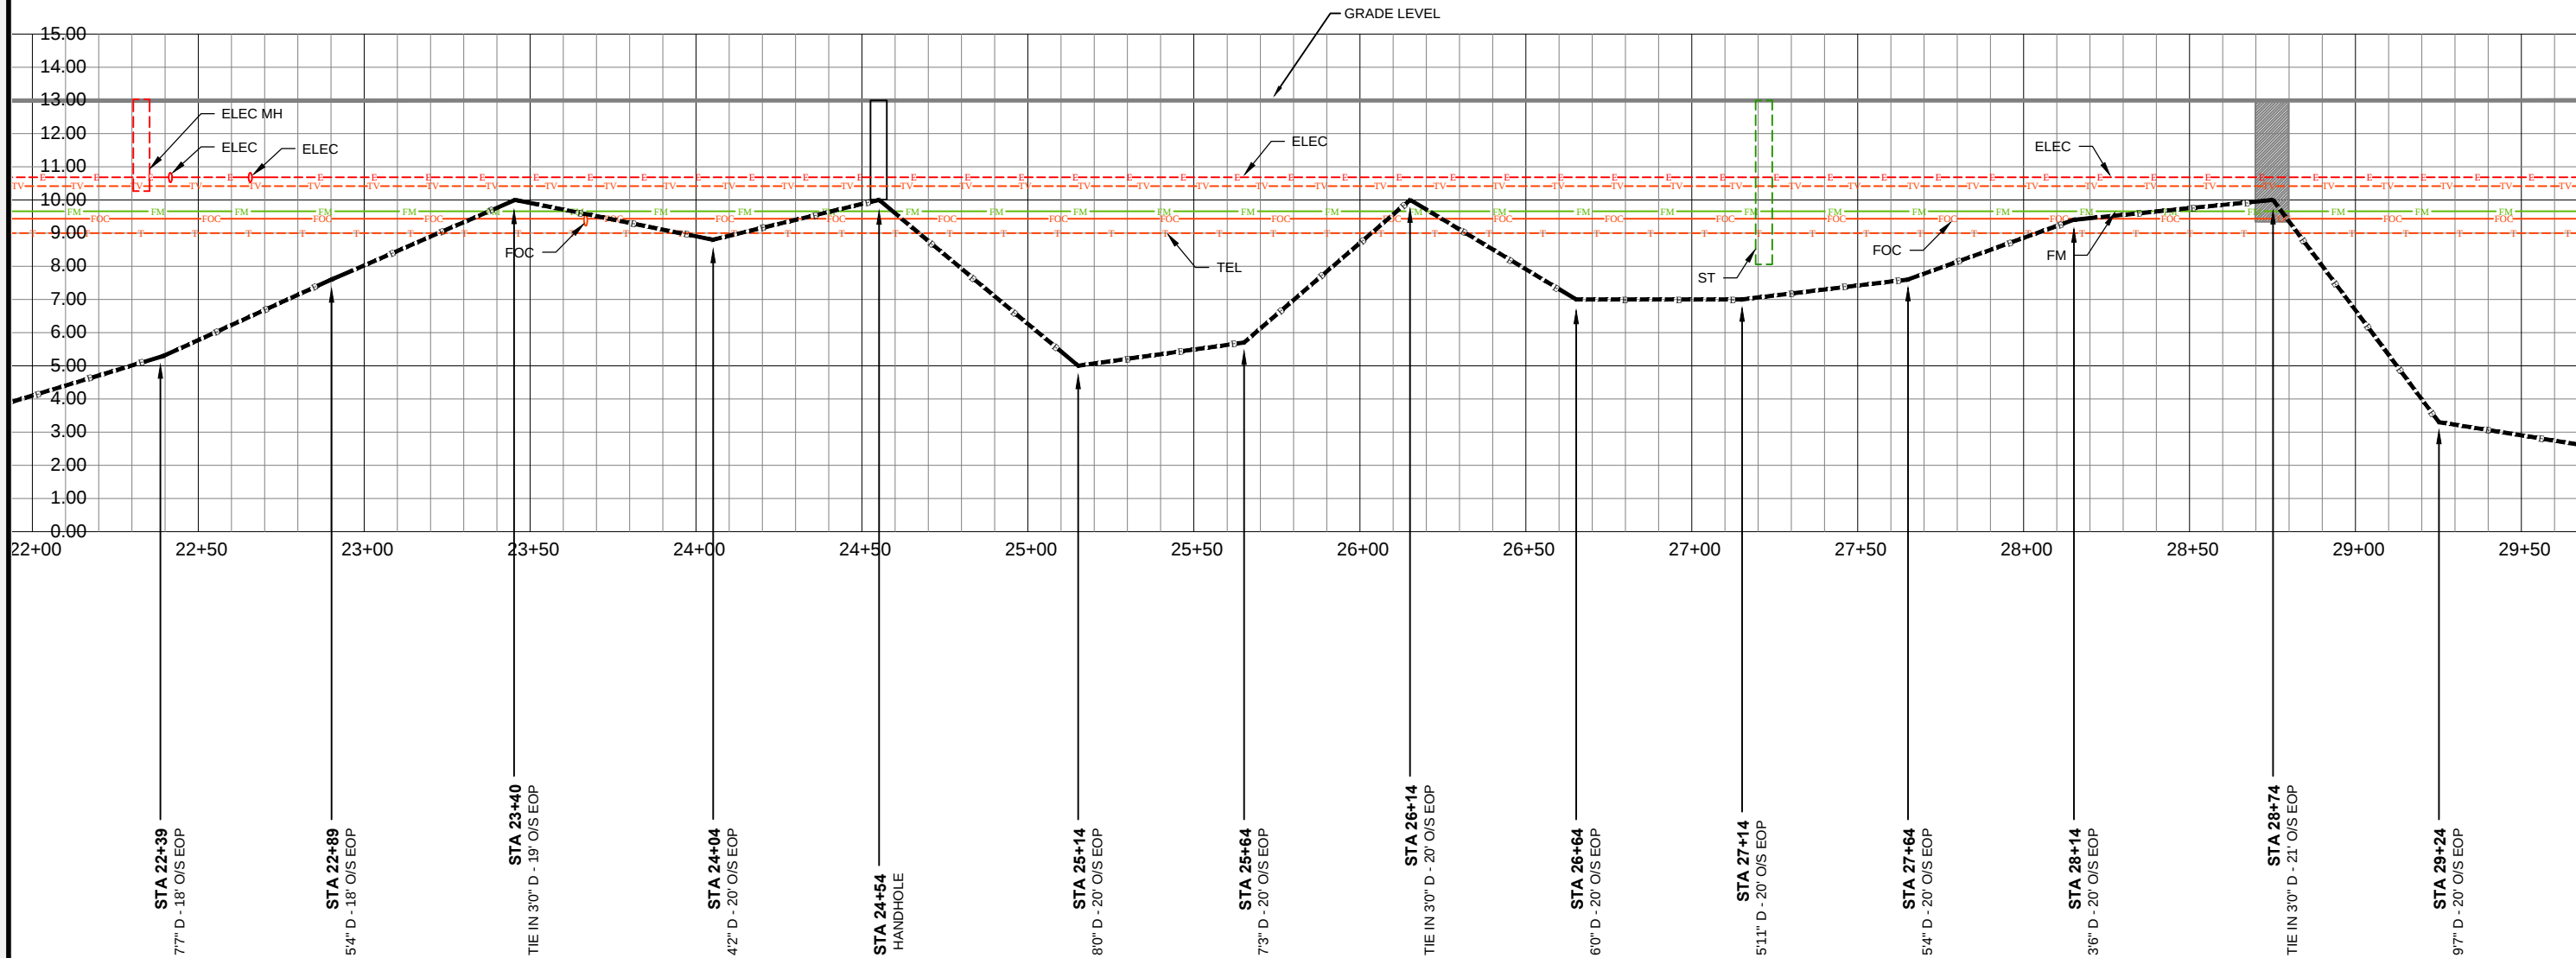

PROFILE - LYONS RD
HORIZONTAL SCALE: 1"=50'
VERTICAL SCALE: 1"=5'

MATCH TO SHEET 012 - STA 29+70




REV.	DATE	DESCRIPTION
	080119	FIRST SUBMITTAL
	111419	AS BUILT

PROJECT:	FORCED RELOCATION LYONS RD SOUTH AS BUILT
SCALE :	1"=50'
FILE NAME :	FR-LYONS RD - SOUTH.DWG
DATE :	11/14/19
DRAWING :	CADDERCOMM

COUNTY:	BROWARD	
CITY:	COCONUT CREEK	
LOCATION:	LYONS RD	
TOWNSHIP :	RANGE :	SECTION :
48S	42E	20

SHEET NUMBER	011 OF 012
TRACKING # :	ASK-SE-1553

MATCH TO SHEET 011 - STA 29+70

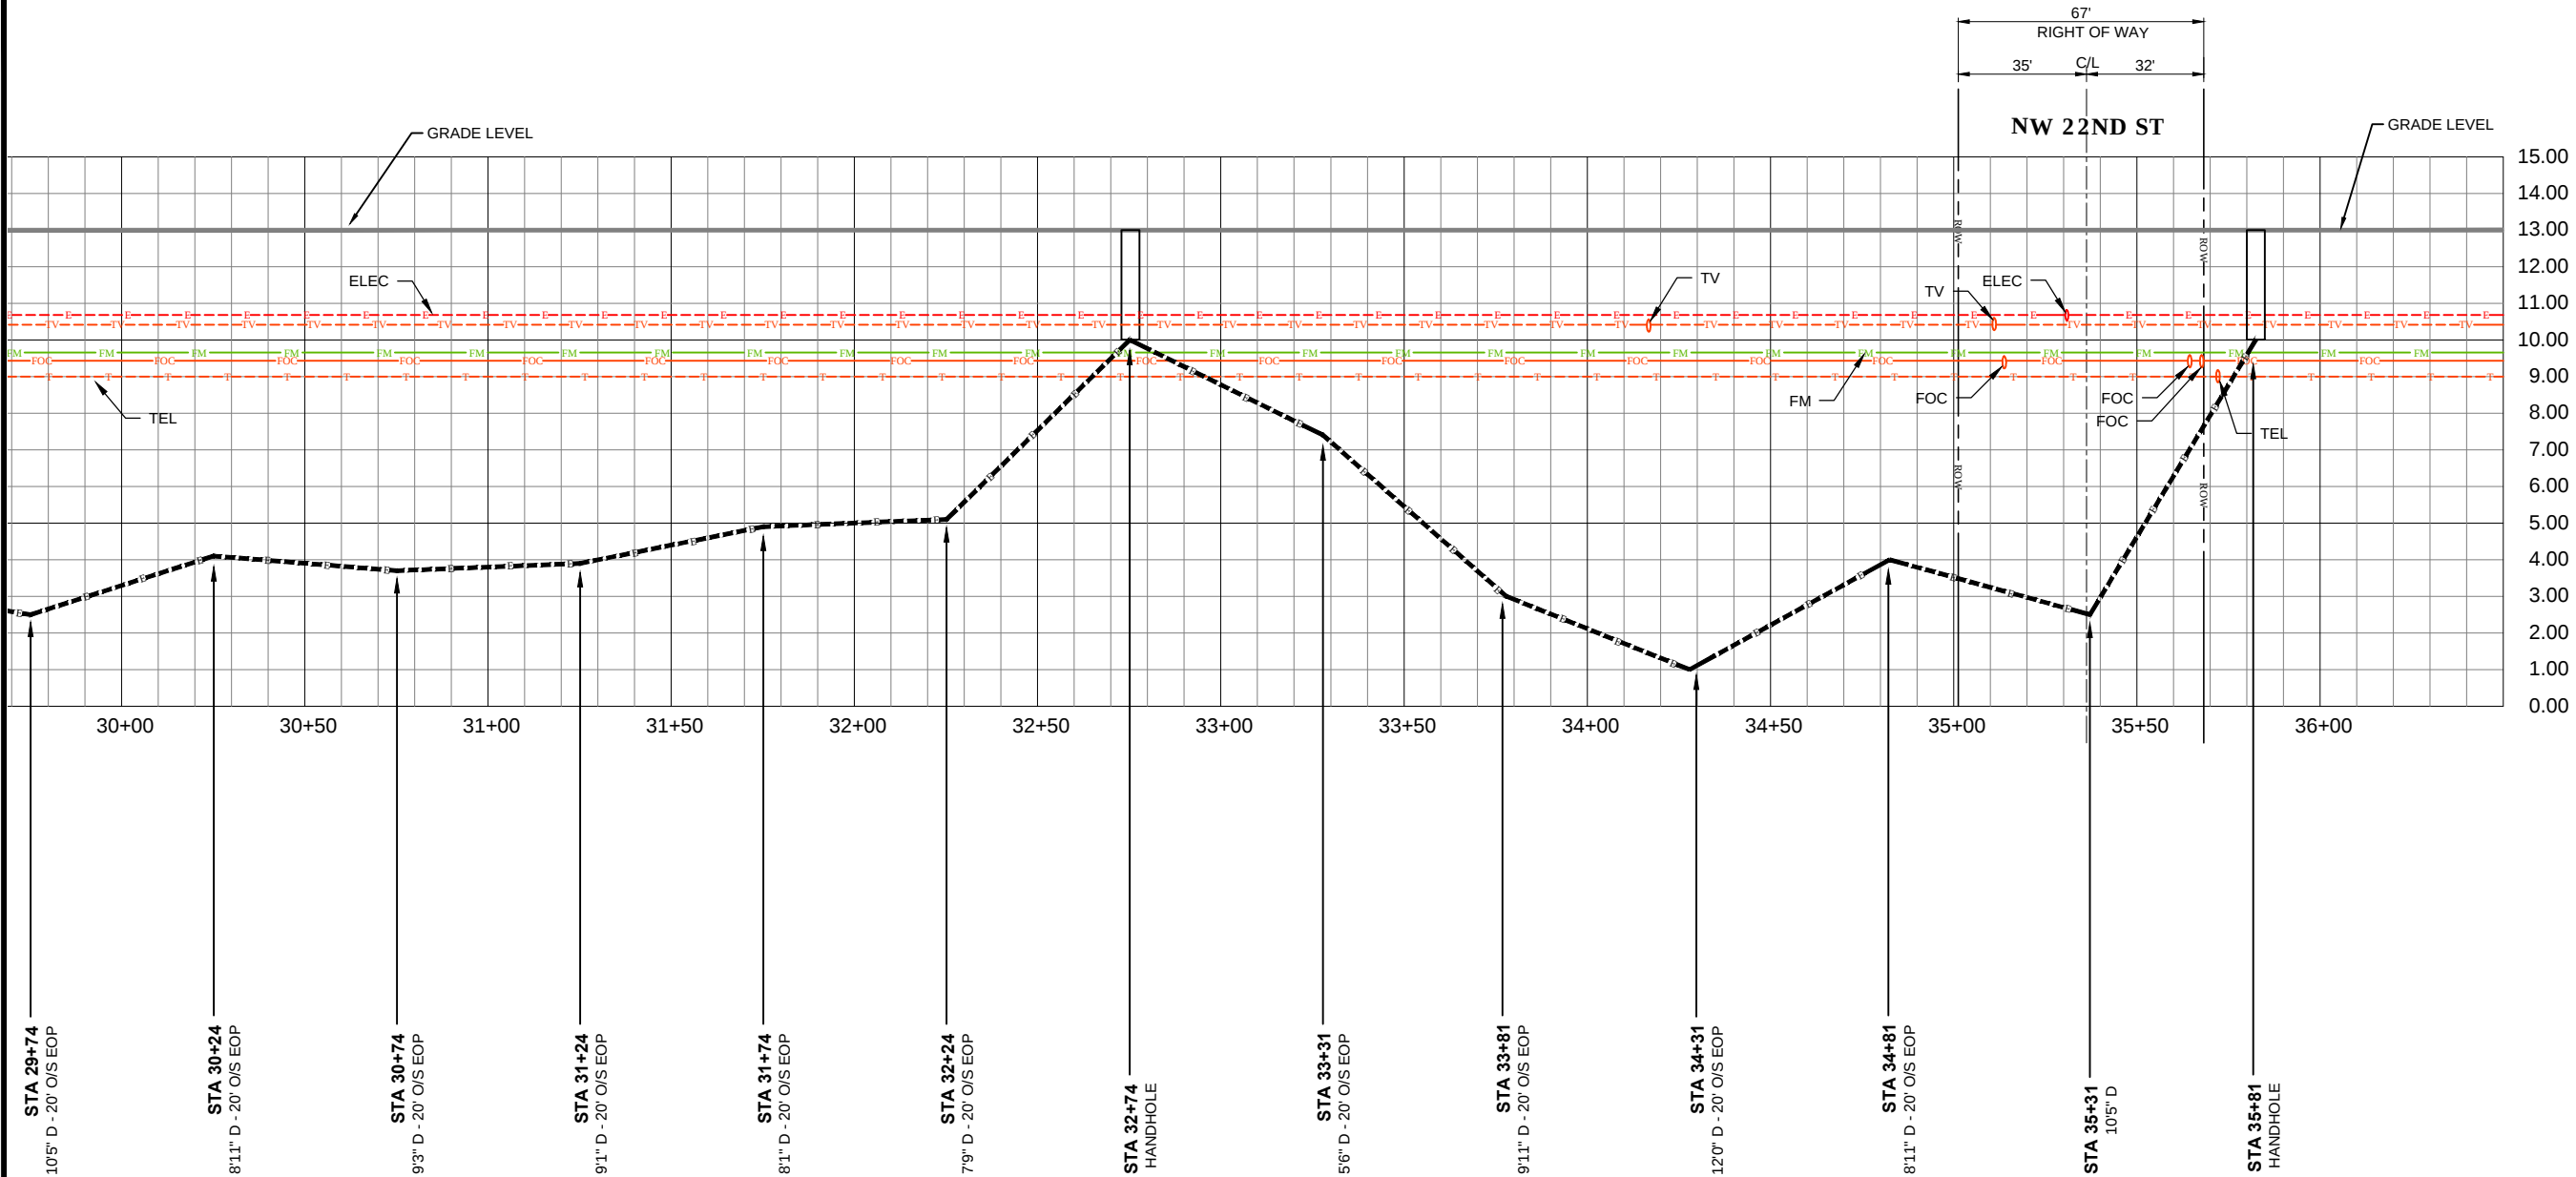

PROFILE - LYONS RD
HORIZONTAL SCALE: 1"=50'
VERTICAL SCALE: 1"=5'



REV.	DATE	DESCRIPTION
	080119	FIRST SUBMITTAL
	111419	AS BUILT

PROJECT:	FORCED RELOCATION LYONS RD SOUTH AS BUILT
SCALE :	1"=50'
FILE NAME :	FR-LYONS RD - SOUTH.DWG
DATE :	11/14/19
DRAWING :	CADDERCOMM

COUNTY:	BROWARD
CITY:	COCONUT CREEK
LOCATION:	LYONS RD
TOWNSHIP :	48S
RANGE :	42E
SECTION :	20

SHEET NUMBER	012 OF 012
TRACKING # :	ASK-SE-1553