

# FIBER OPTIC PHASE 1 TRUNKLINE

LYONS ROAD AND JOHNSON ROAD

MARCH 2016

## INDEX OF DRAWINGS

SHEET 1 OF 3 - COVER SHEET  
 SHEET 2 OF 3 - PLAN VIEW  
 SHEET 3 OF 3 - PROFILE

## JOB DESCRIPTION:

APPROXIMATELY 585' DIRECTIONAL BORE

## GENERAL NOTES

1. NO WORKS ON SIDEWALKS OR PAVEMENT. ALL WORKS TO BE DONE WITHIN GREEN AREAS ONLY
2. ALL RESTORATION TO EQUAL OR BETTER CONDITION
3. JOHNSON ROAD IS WITHIN THE JURISDICTION OF COCONUT CREEK AND LYONS ROAD IS WITHIN THE JURISDICTION OF BROWARD COUNTY.
4. ALL WORKS TO THAT WILL REQUIRED CLOSURE TO THROUGH LANES SHALL REQUIRE A CERTIFIED MOT PERSON TO SET UP THE MOT
5. ALL EXISTING SIGNALIZATION EQUIPMENT IS ASSUMED TO BE IN GOOD WORKING CONDITION UNLESS BROWARD COUNTY TRAFFIC ENGINEERING DIVISION IS NOTIFIED IN WRITING PRIOR TO START OF CONSTRUCTION. ANY SUBSEQUENT DAMAGE TO THE SIGNAL EQUIPMENT SHALL BE REPAIRED BY THE CONTRACTOR AT THE CONTRACTOR'S EXPENSE.
6. NO CONSTRUCTION SHALL COMMENCE PRIOR TO THE LOCATION OF ALL UNDERGROUND UTILITIES. UTILITY LOCATION SERVICES : 1-800-432-4770.




CITY OF COCONUT CREEK  
 UTILITIES AND ENGINEERING DEPARTMENT  
 5295 JOHNSON RD  
 COCONUT CREEK, FL 33073  
 TEL: (954) 973-6786

PROJECT LOCATION:  
 6700 LYONS RD, COCONUT CREEK

SCALE:  
 N.T.S.

APPROVED BY:  
 CITY OF COCONUT CREEK  
 ENGINEERING DIVISION

SHEET NO.:  
 1 OF 3

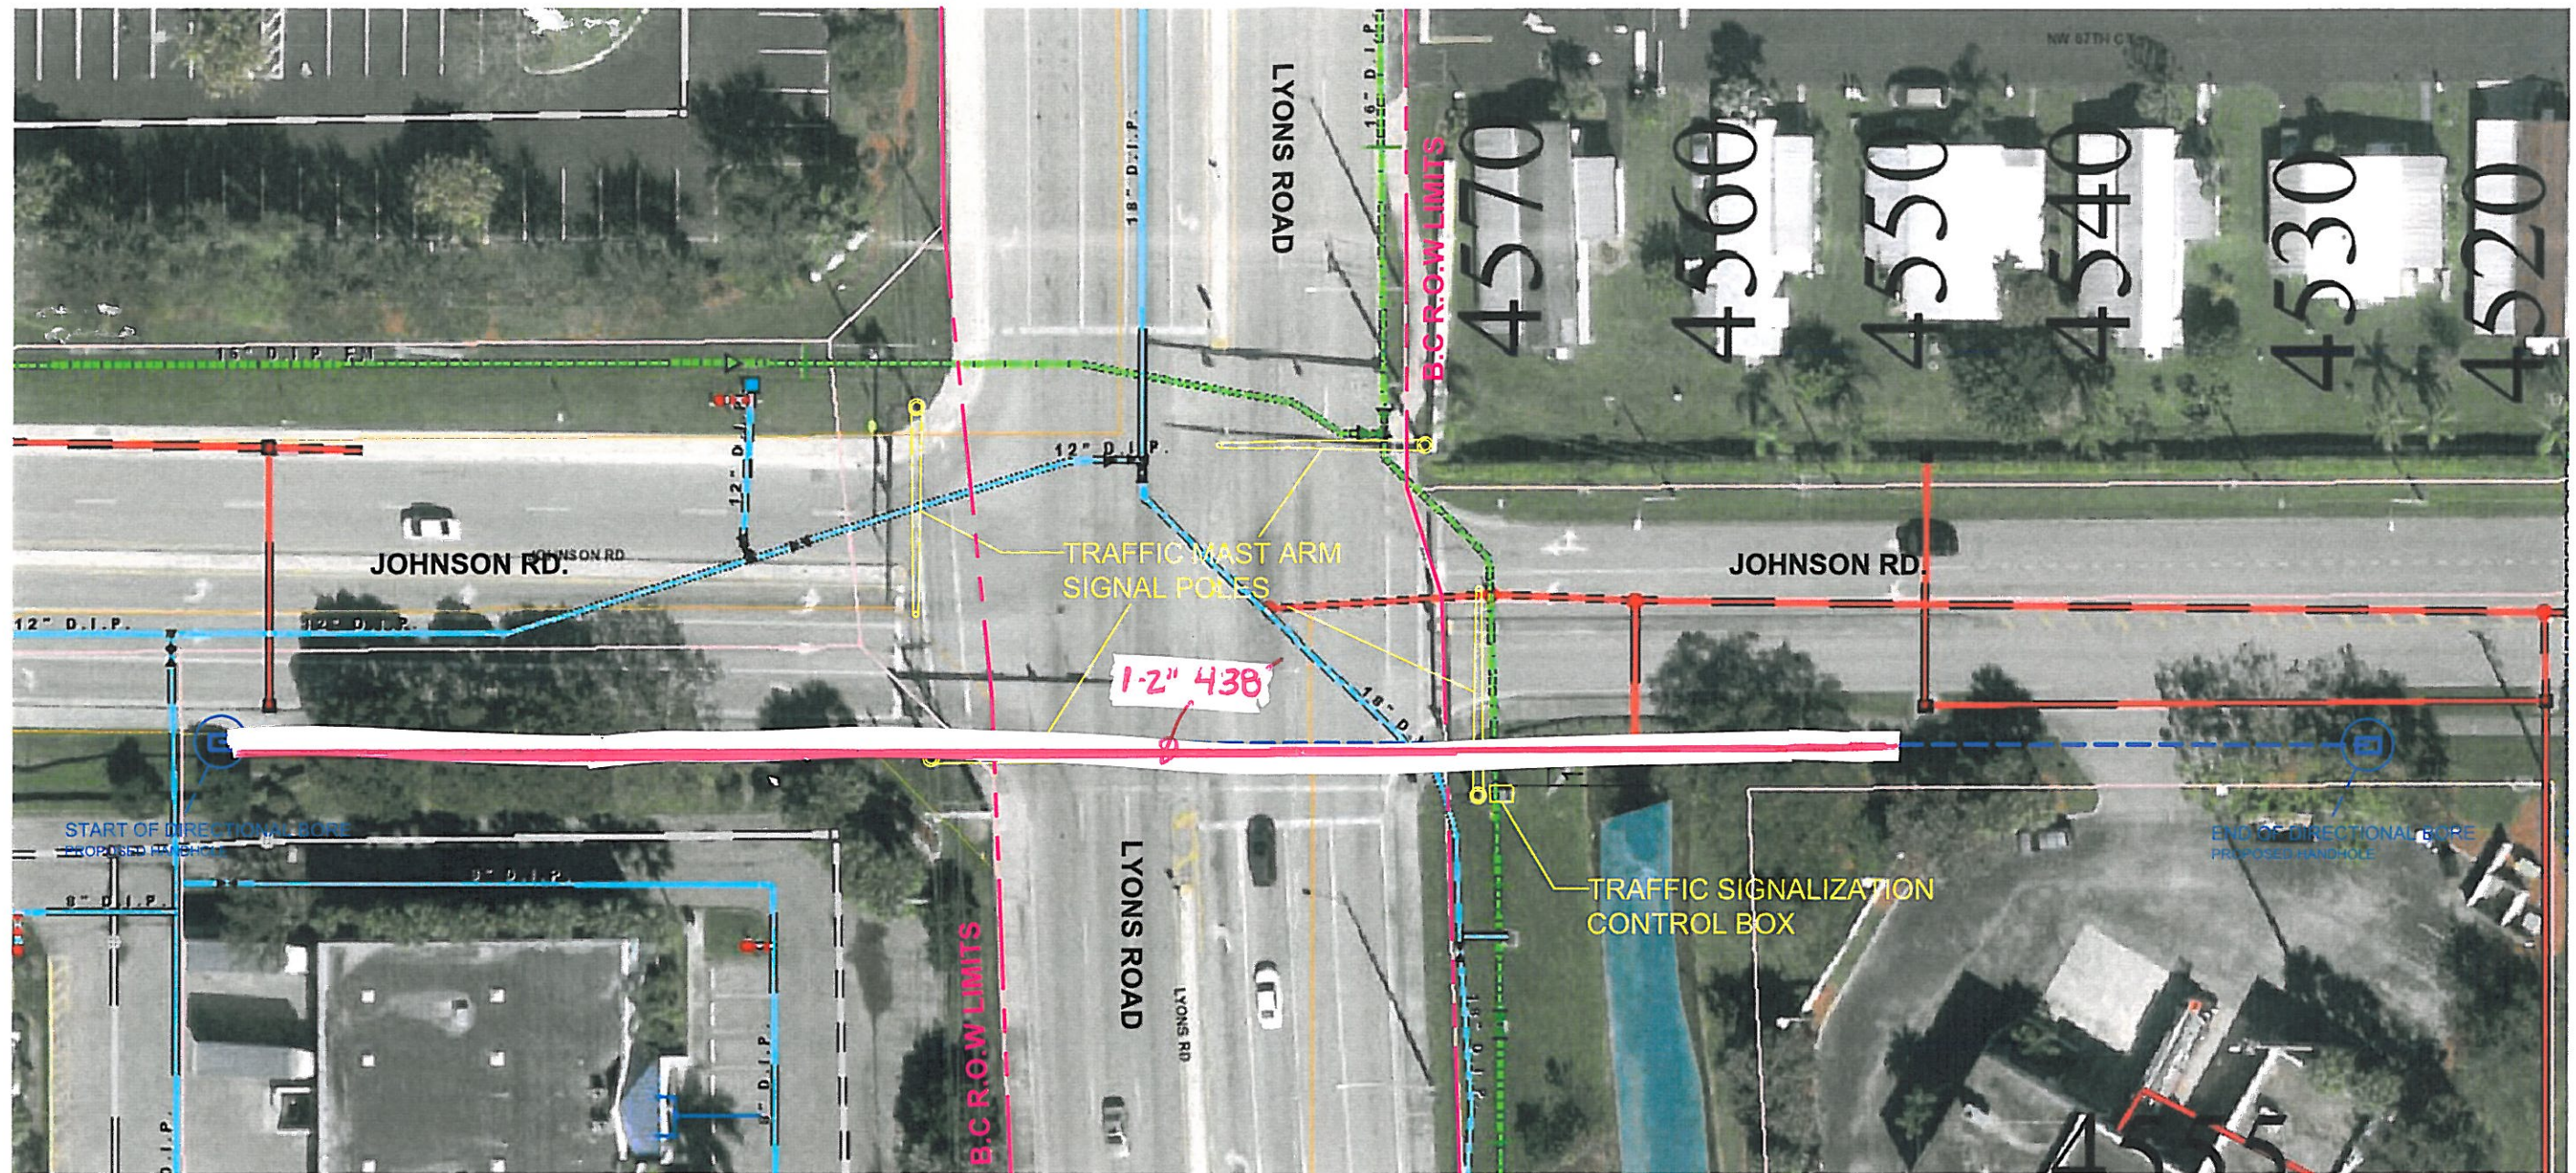

- - - BROWARD COUNTY RIGHT OF WAY LIMITS
- - - CITY OF COCONUT CREEK FORCE MAIN
- - - CITY OF COCONUT CREEK WATER MAIN
- - - CITY OF COCONUT CREEK STORM WATER DRAINAGE STRUCTURE

- - - PROPOSED DIRECTIONAL BORE (Two inches (2") HDPE SDR 11 IPS)

*AS-BUILD BMD 4/5/16*



**CITY OF COCONUT CREEK**  
**UTILITIES AND ENGINEERING DEPARTMENT**  
 5295 JOHNSON RD  
 COCONUT CREEK, FL 33073  
 TEL: (954) 973-6786


PROJECT LOCATION:  
 6700 LYONS RD, COCONUT CREEK

APPROVED BY:  
 CITY OF COCONUT CREEK  
 ENGINEERING DIVISION

SCALE:  
 N.T.S.

SHEET NO.:  
 2 OF 3

# PROFILE

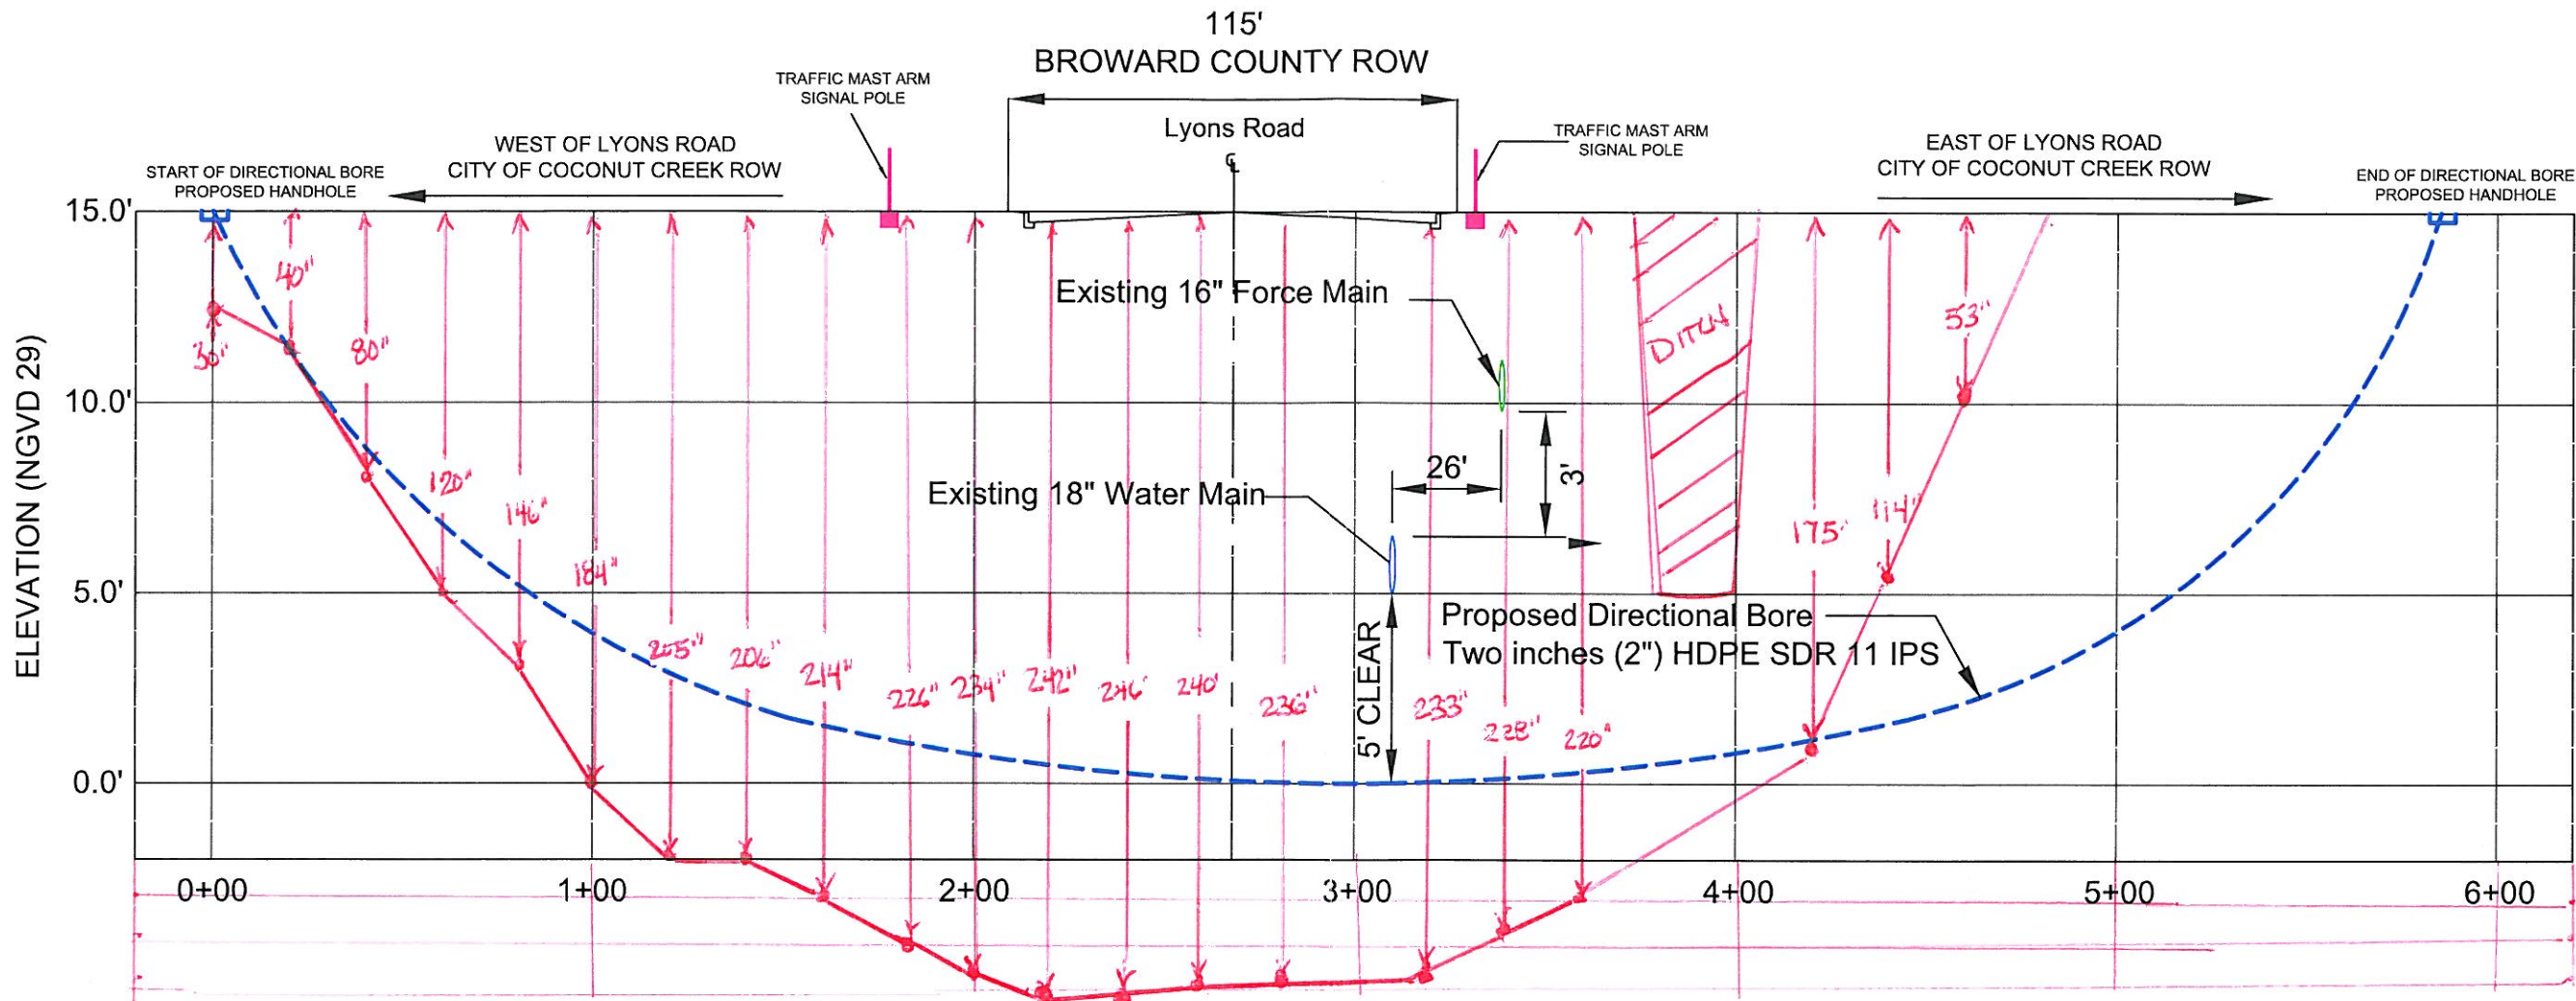

*AS BUILT BM 41516*



CITY OF COCONUT CREEK  
 UTILITIES AND ENGINEERING DEPARTMENT  
 5295 JOHNSON RD  
 COCONUT CREEK, FL 33073  
 TEL: (954) 973-6786

PROJECT LOCATION:  
 6700 LYONS RD, COCONUT CREEK

APPROVED BY:  
 CITY OF COCONUT CREEK  
 ENGINEERING DIVISION

SCALE:  
 N.T.S.

SHEET NO.:  
 3 OF 3