

FORCED RELOCATION
LYONS RD
NORTH


TOTAL UNDERGROUND FOOTAGE = 3,038'

DIRECTIONAL BORE = 3,038'

2" HDPE CONDUIT = 3,038'

24"X36"X30" HANDHOLES = 3

001	————	COVER
002-006	————	PLAN VIEW
007-011	————	PROFILES

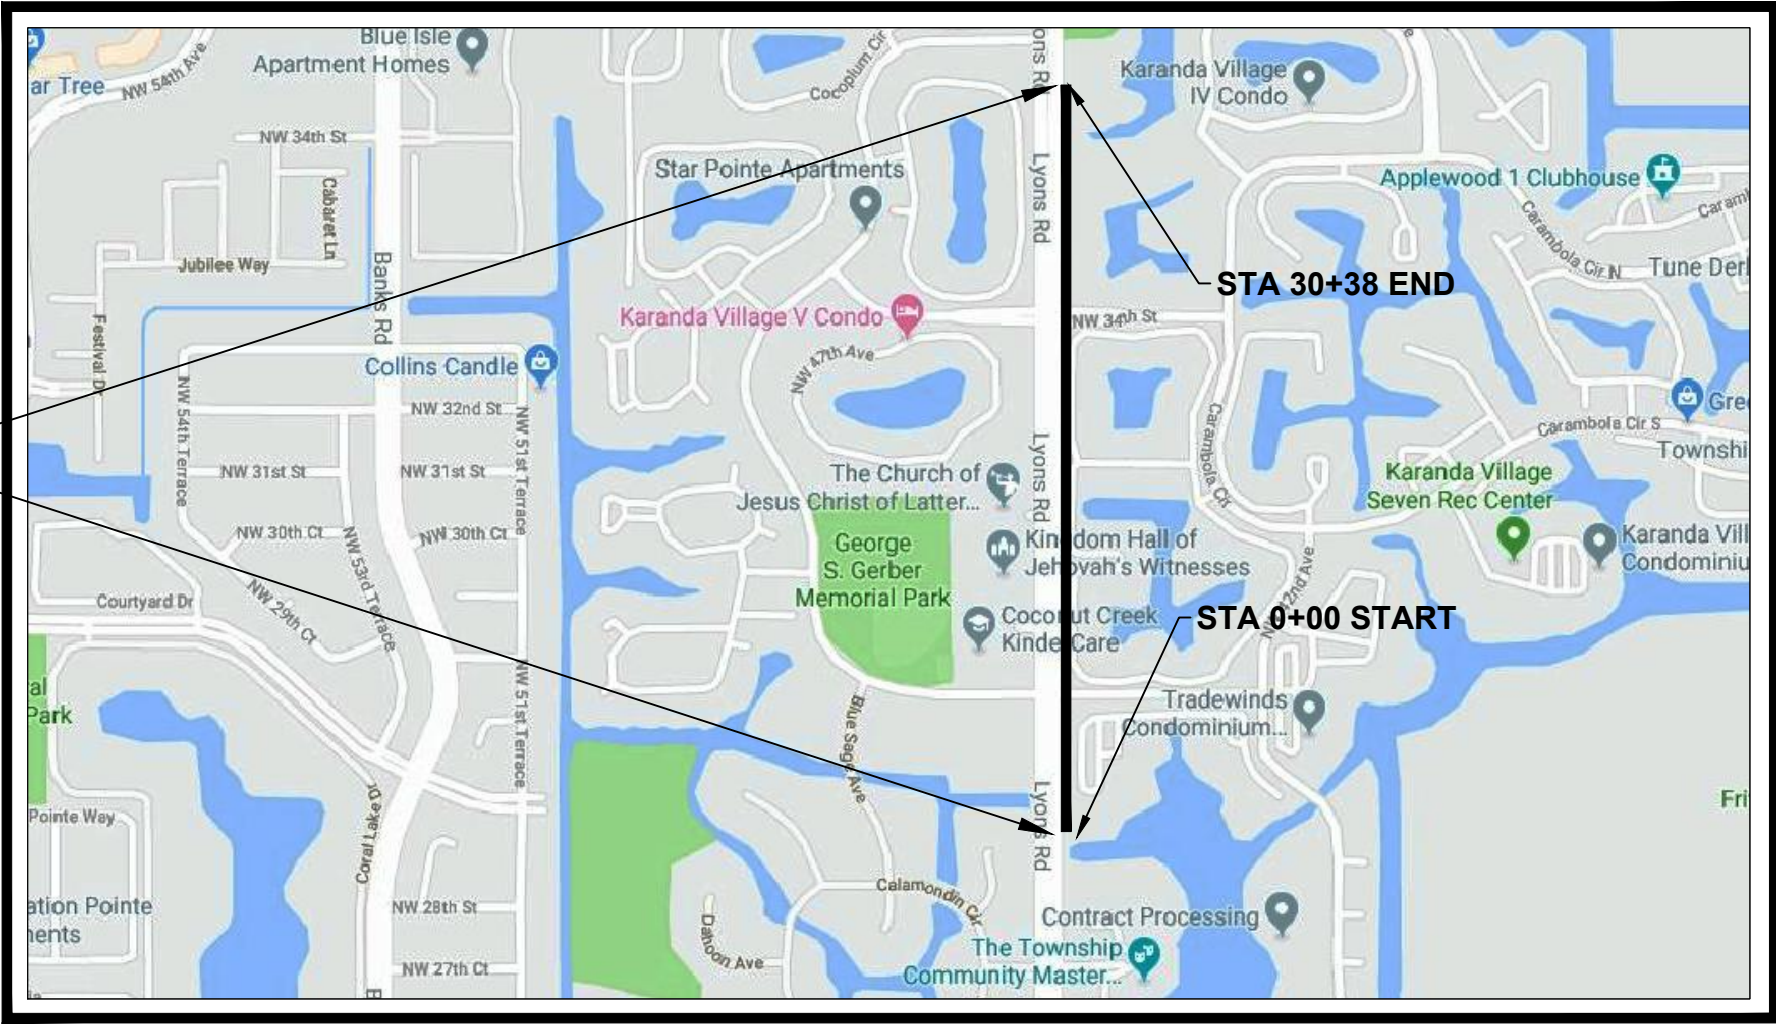

LOCATION MAP




DIRECTION OF ENGINEERING

REV.	DATE	DESCRIPTION	PROJECT:	COUNTY:		SHEET NUMBER
	080519	FIRST SUBMITTAL	FORCED RELOCATION LYONS RD - NORTH AS BUILT	BROWARD		001 OF 011
	111319	AS BUILT		CITY: COCONUT CREEK		
			SCALE : 1"=50'	LOCATION: LYONS RD		TRACKING # :
			FILE NAME : FR:LYONS RD - NORTH - AB.DWG			ASK-SE-1553
			DATE : 11/13/19	TOWNSHIP : 50S	RANGE : 42E	
			DRAWING : CADDERRCOMM	SECTION : 5		



1. ALL MEASUREMENTS TAKEN FROM
EXISTING EDGE OF PAVEMENT
2. ALL PROPOSED HANDHOLES TO BE
ADJUSTED TO FINAL GRADE LEVEL
ONCE THE NEW SIDEWALK IS IN PLACE

MATCH TO SHEET 003 - STA 11+65

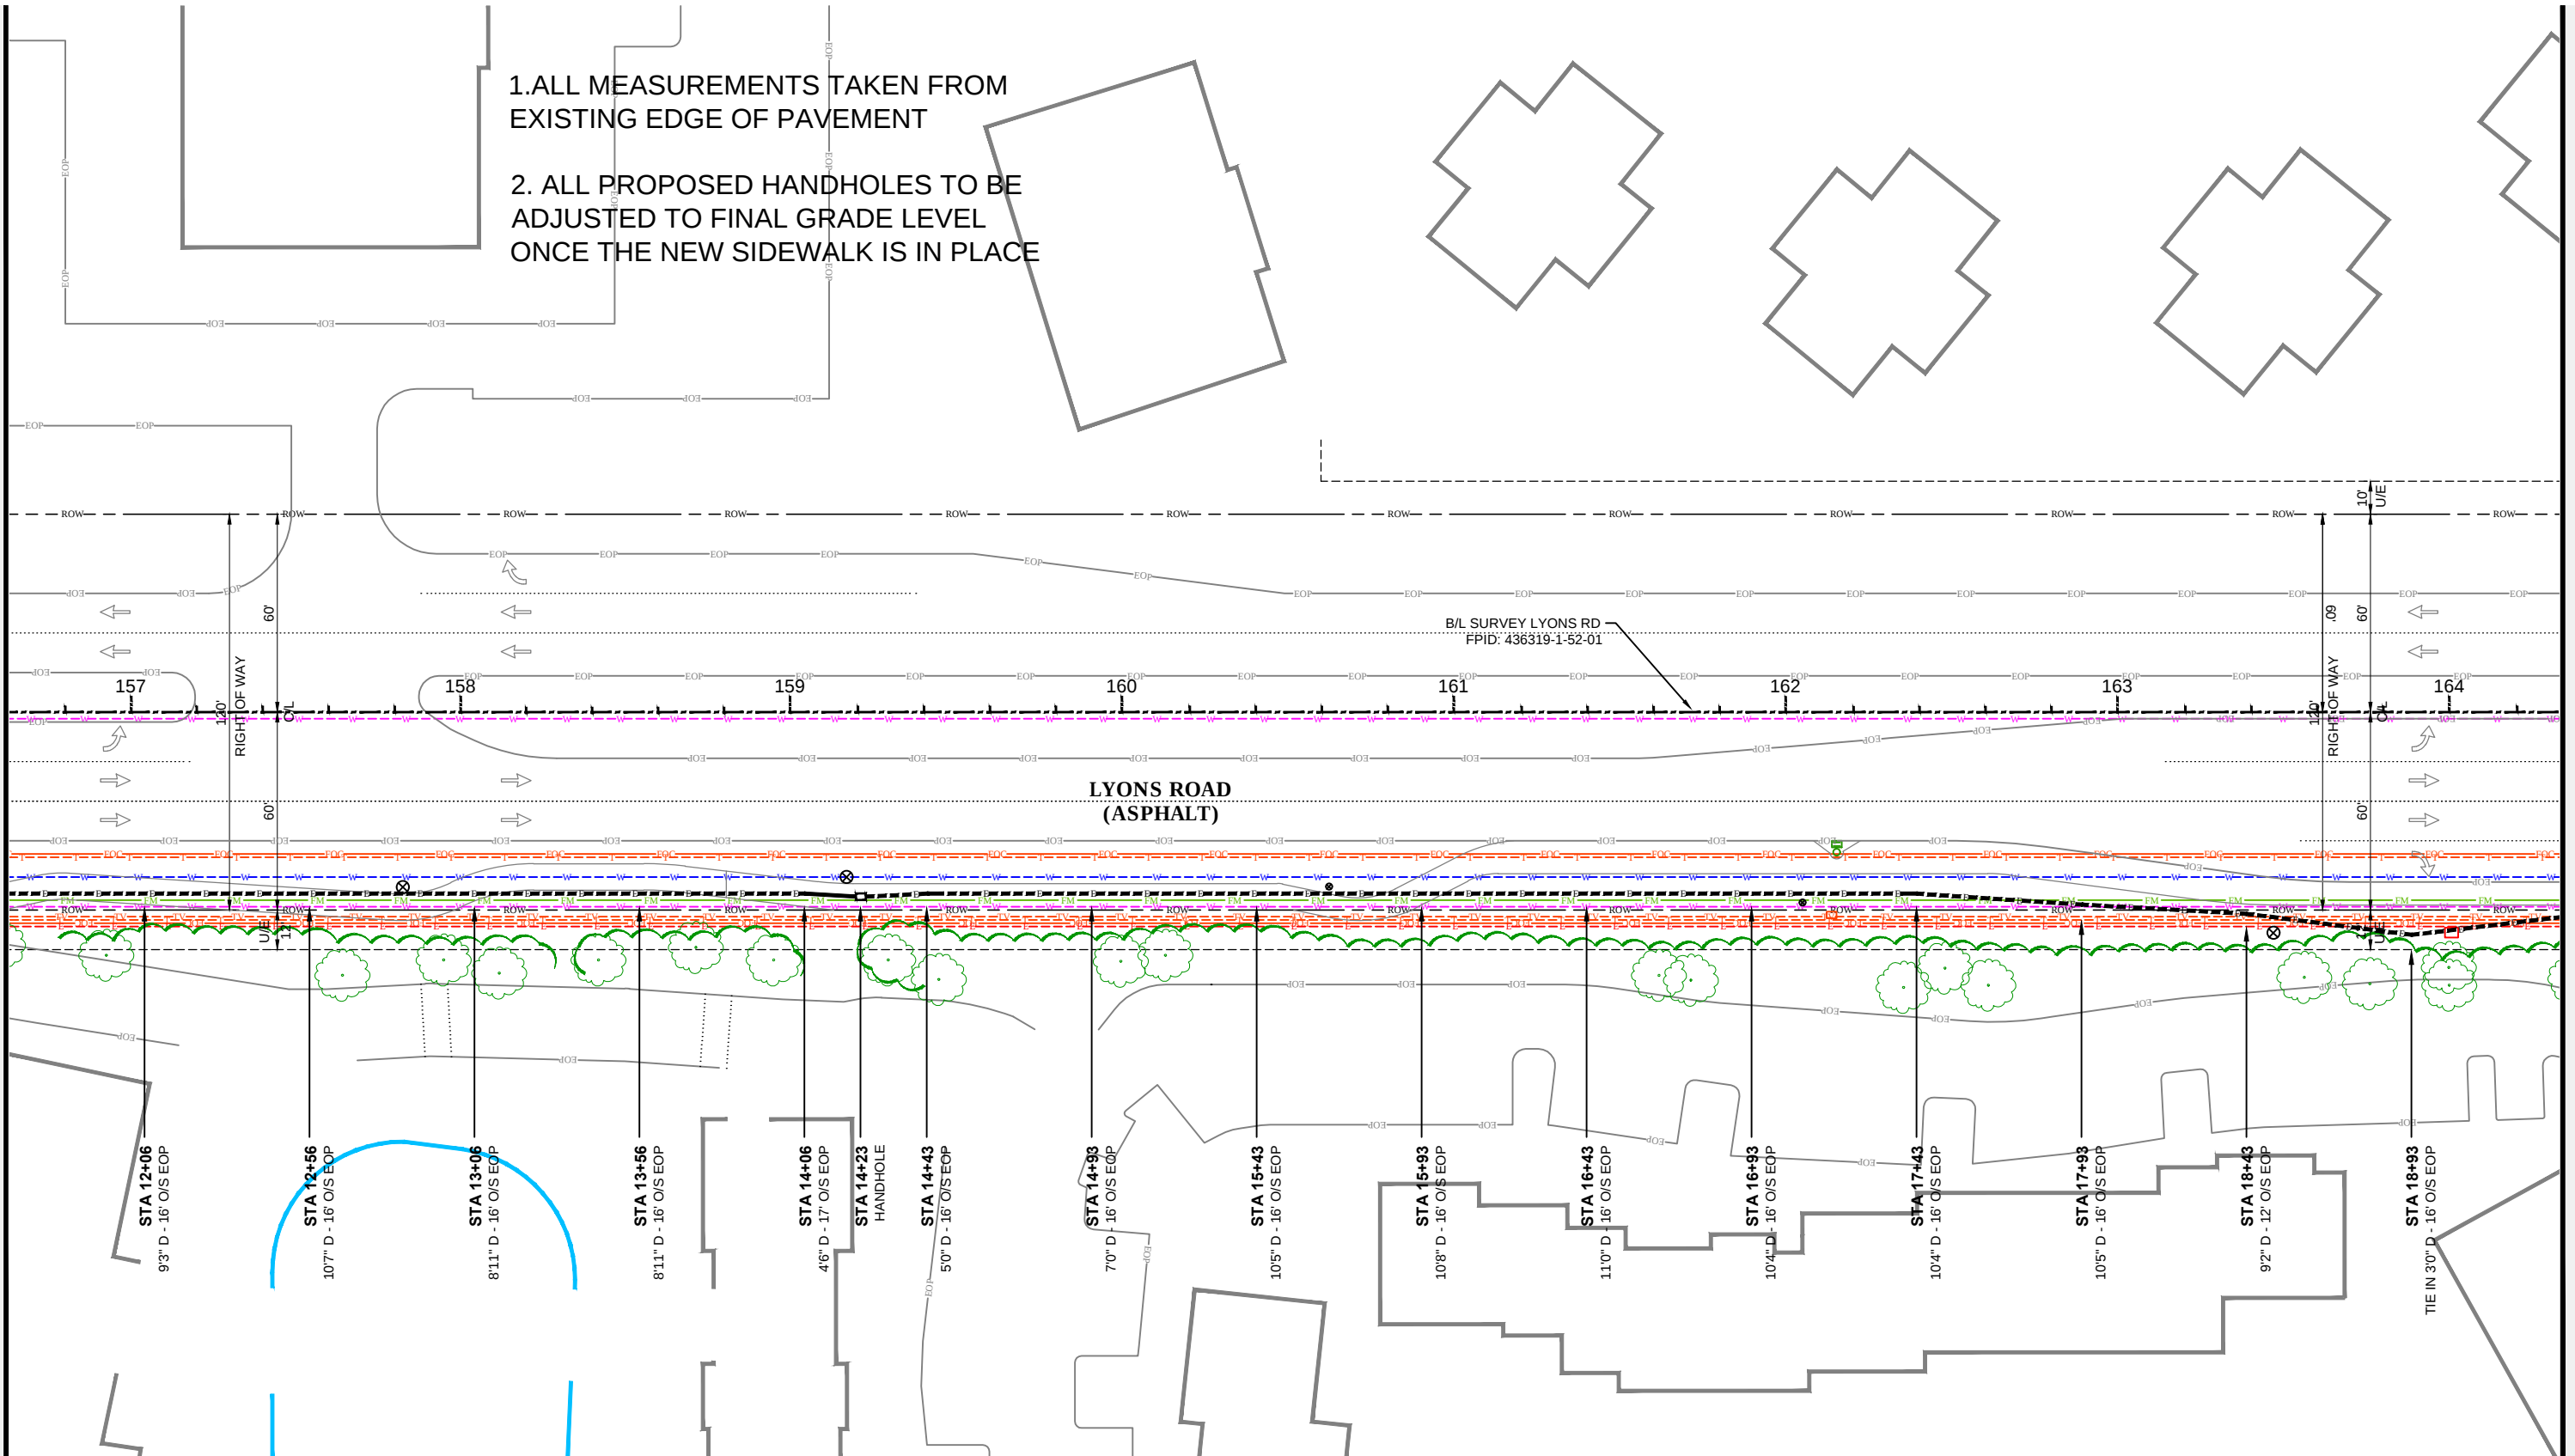

MATCH TO SHEET 005 - STA 19+40




REV.	DATE	DESCRIPTION
	080519	FIRST SUBMITTAL
	111319	AS BUILT

PROJECT:	FORCED RELOCATION LYONS RD - NORTH AS BUILT
SCALE :	1"=50'
FILE NAME :	FR-LYONS RD - NORTH - AB.DWG
DATE :	11/13/19
DRAWING :	CADDERCOMM


COUNTY:	BROWARD		
CITY:	COCONUT CREEK		
LOCATION:	LYONS RD		
TOWNSHIP :	RANGE :	SECTION :	
50S	42E	5	

SHEET NUMBER
004 OF 011
TRACKING # :
ASK-SE-1553

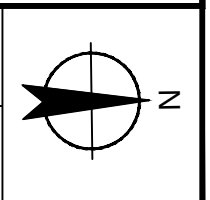

MATCH TO SHEET 004 - STA 19+40

MATCH TO SHEET 006 - STA 27+15

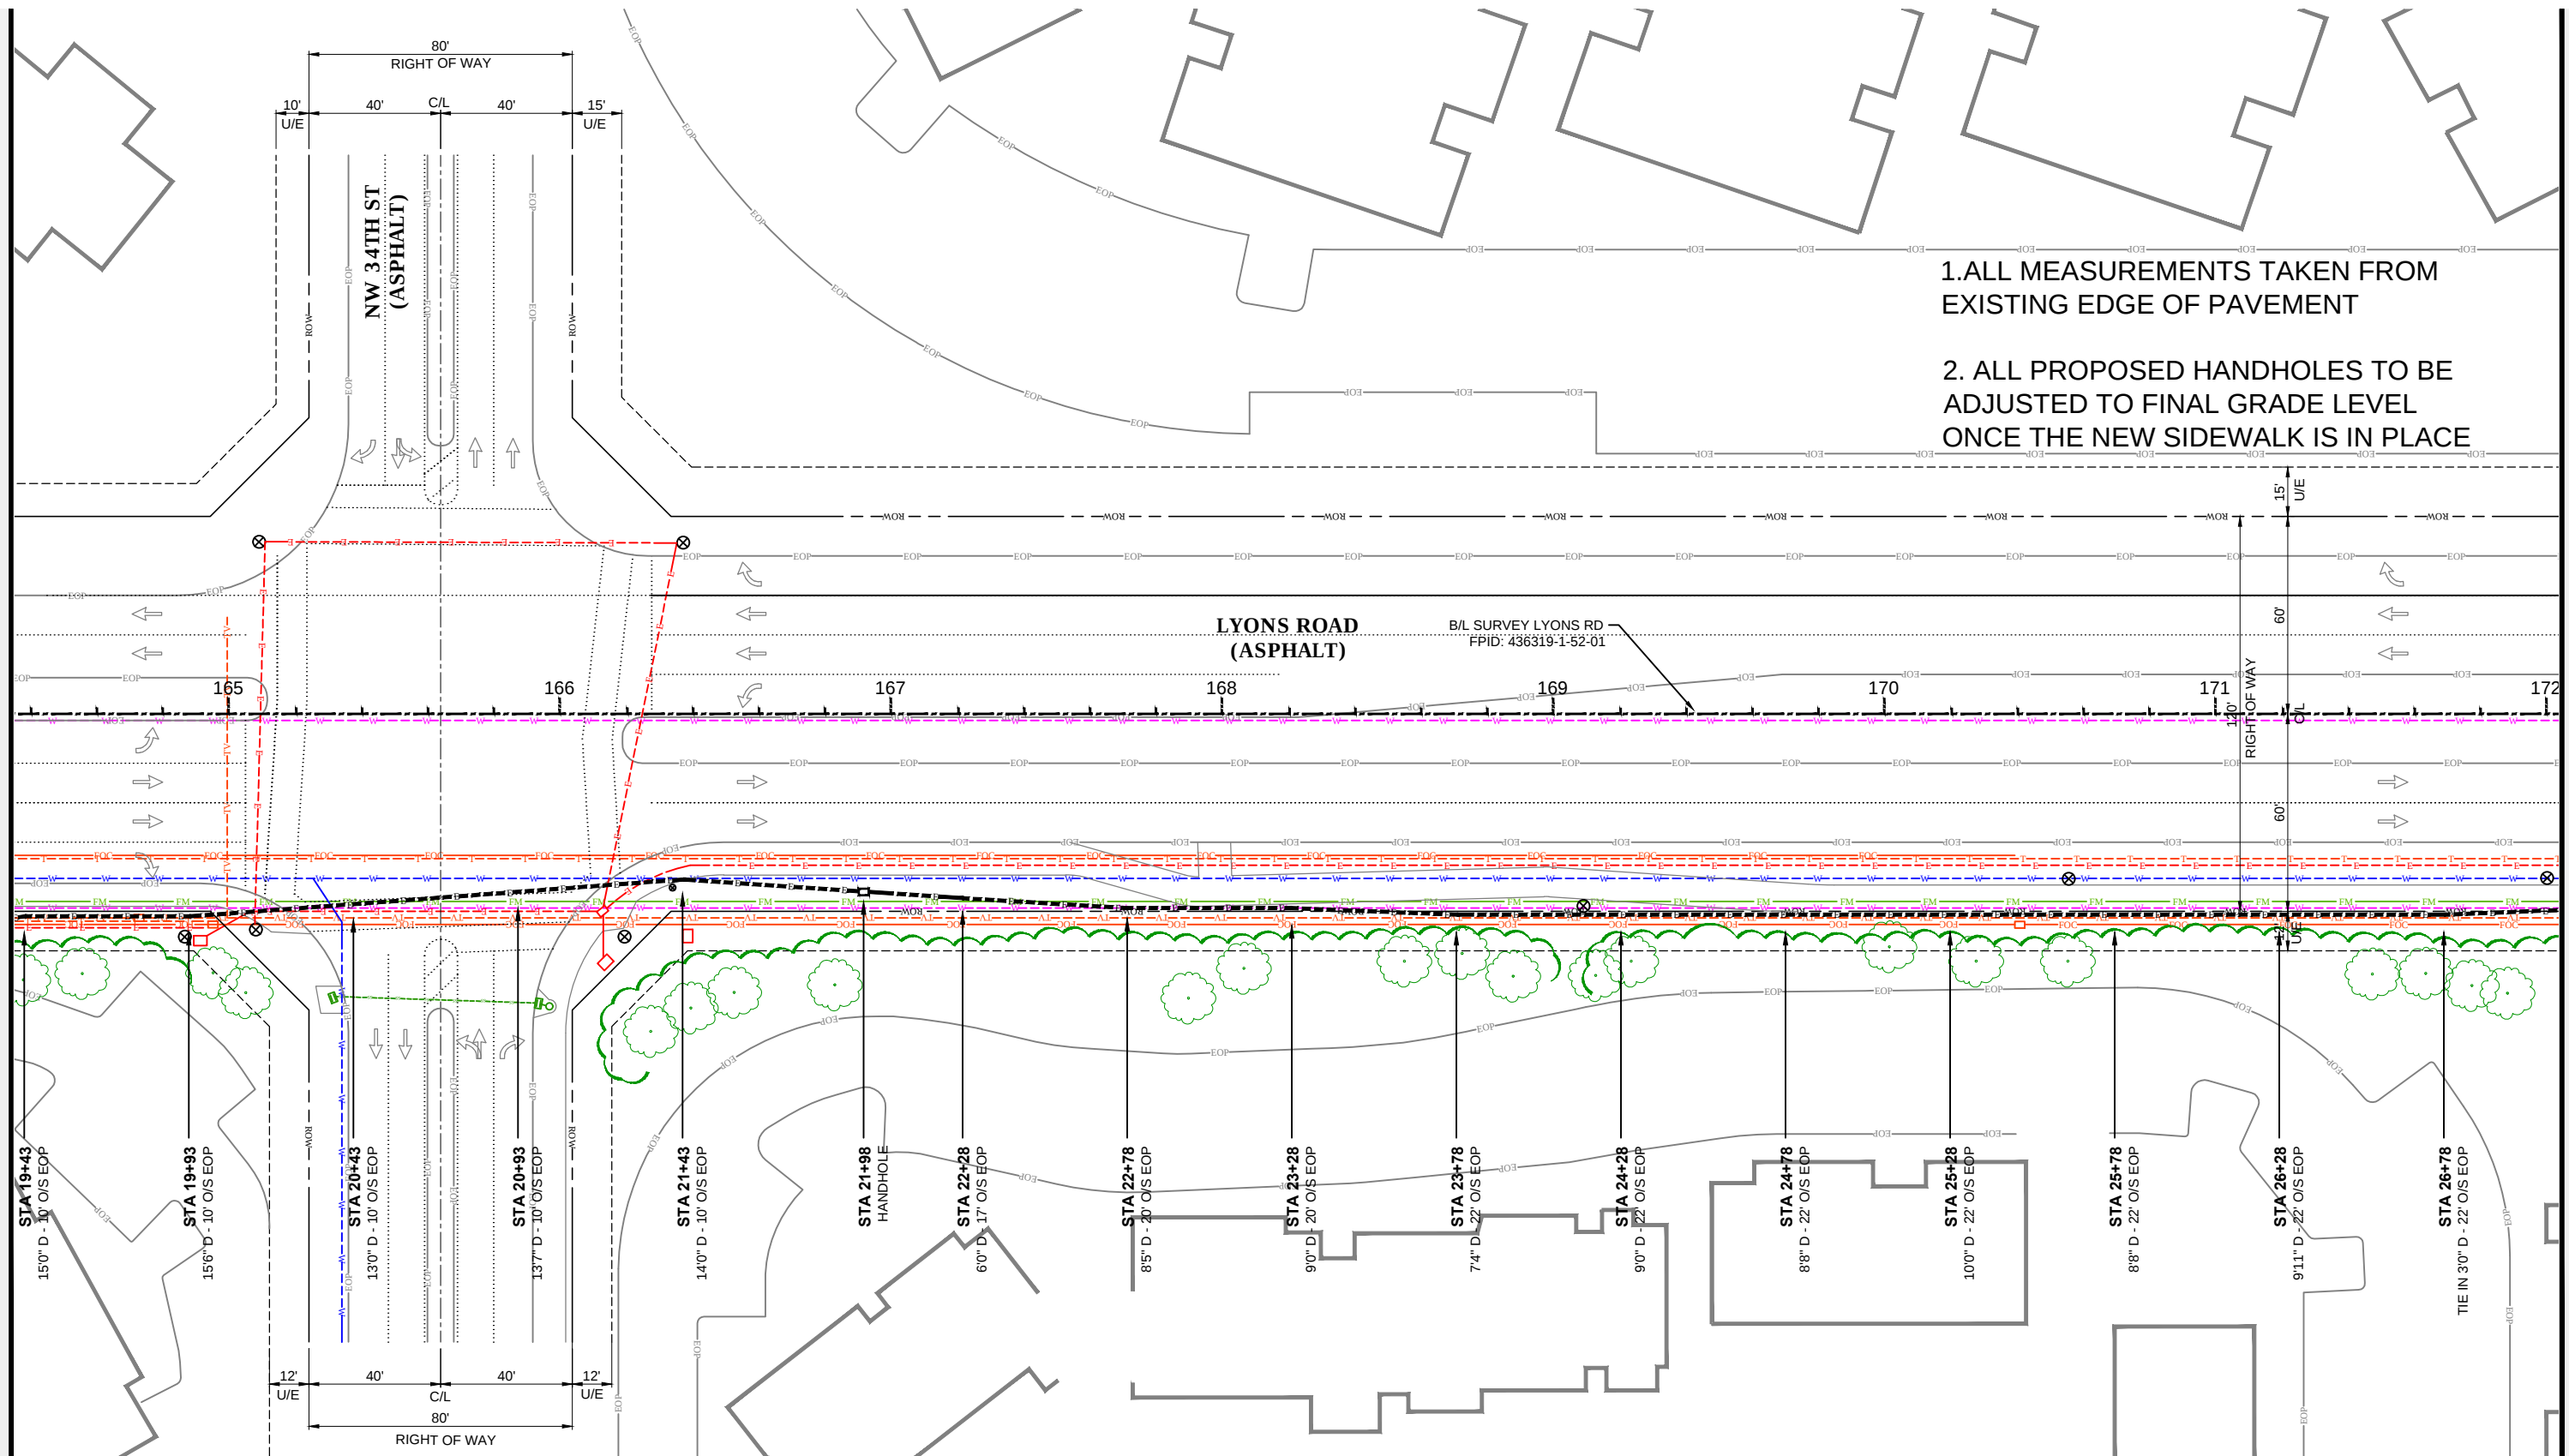


REV.	DATE	DESCRIPTION
	080519	FIRST SUBMITTAL
	111319	AS BUILT


PROJECT:	FORCED RELOCATION LYONS RD - NORTH AS BUILT
SCALE:	1"=50'
FILE NAME:	FR-LYONS RD - NORTH - AB.DWG
DATE:	11/13/19
DRAWING:	CADDERCOMM

COUNTY:	BROWARD
CITY:	COCONUT CREEK
LOCATION:	LYONS RD
TOWNSHIP:	50S
RANGE:	42E
SECTION:	5

SHEET NUMBER	005 OF 011
TRACKING #:	ASK-SE-1553

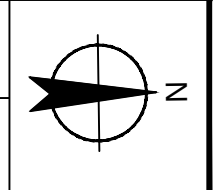

MATCH TO SHEET 005 - STA 27+15

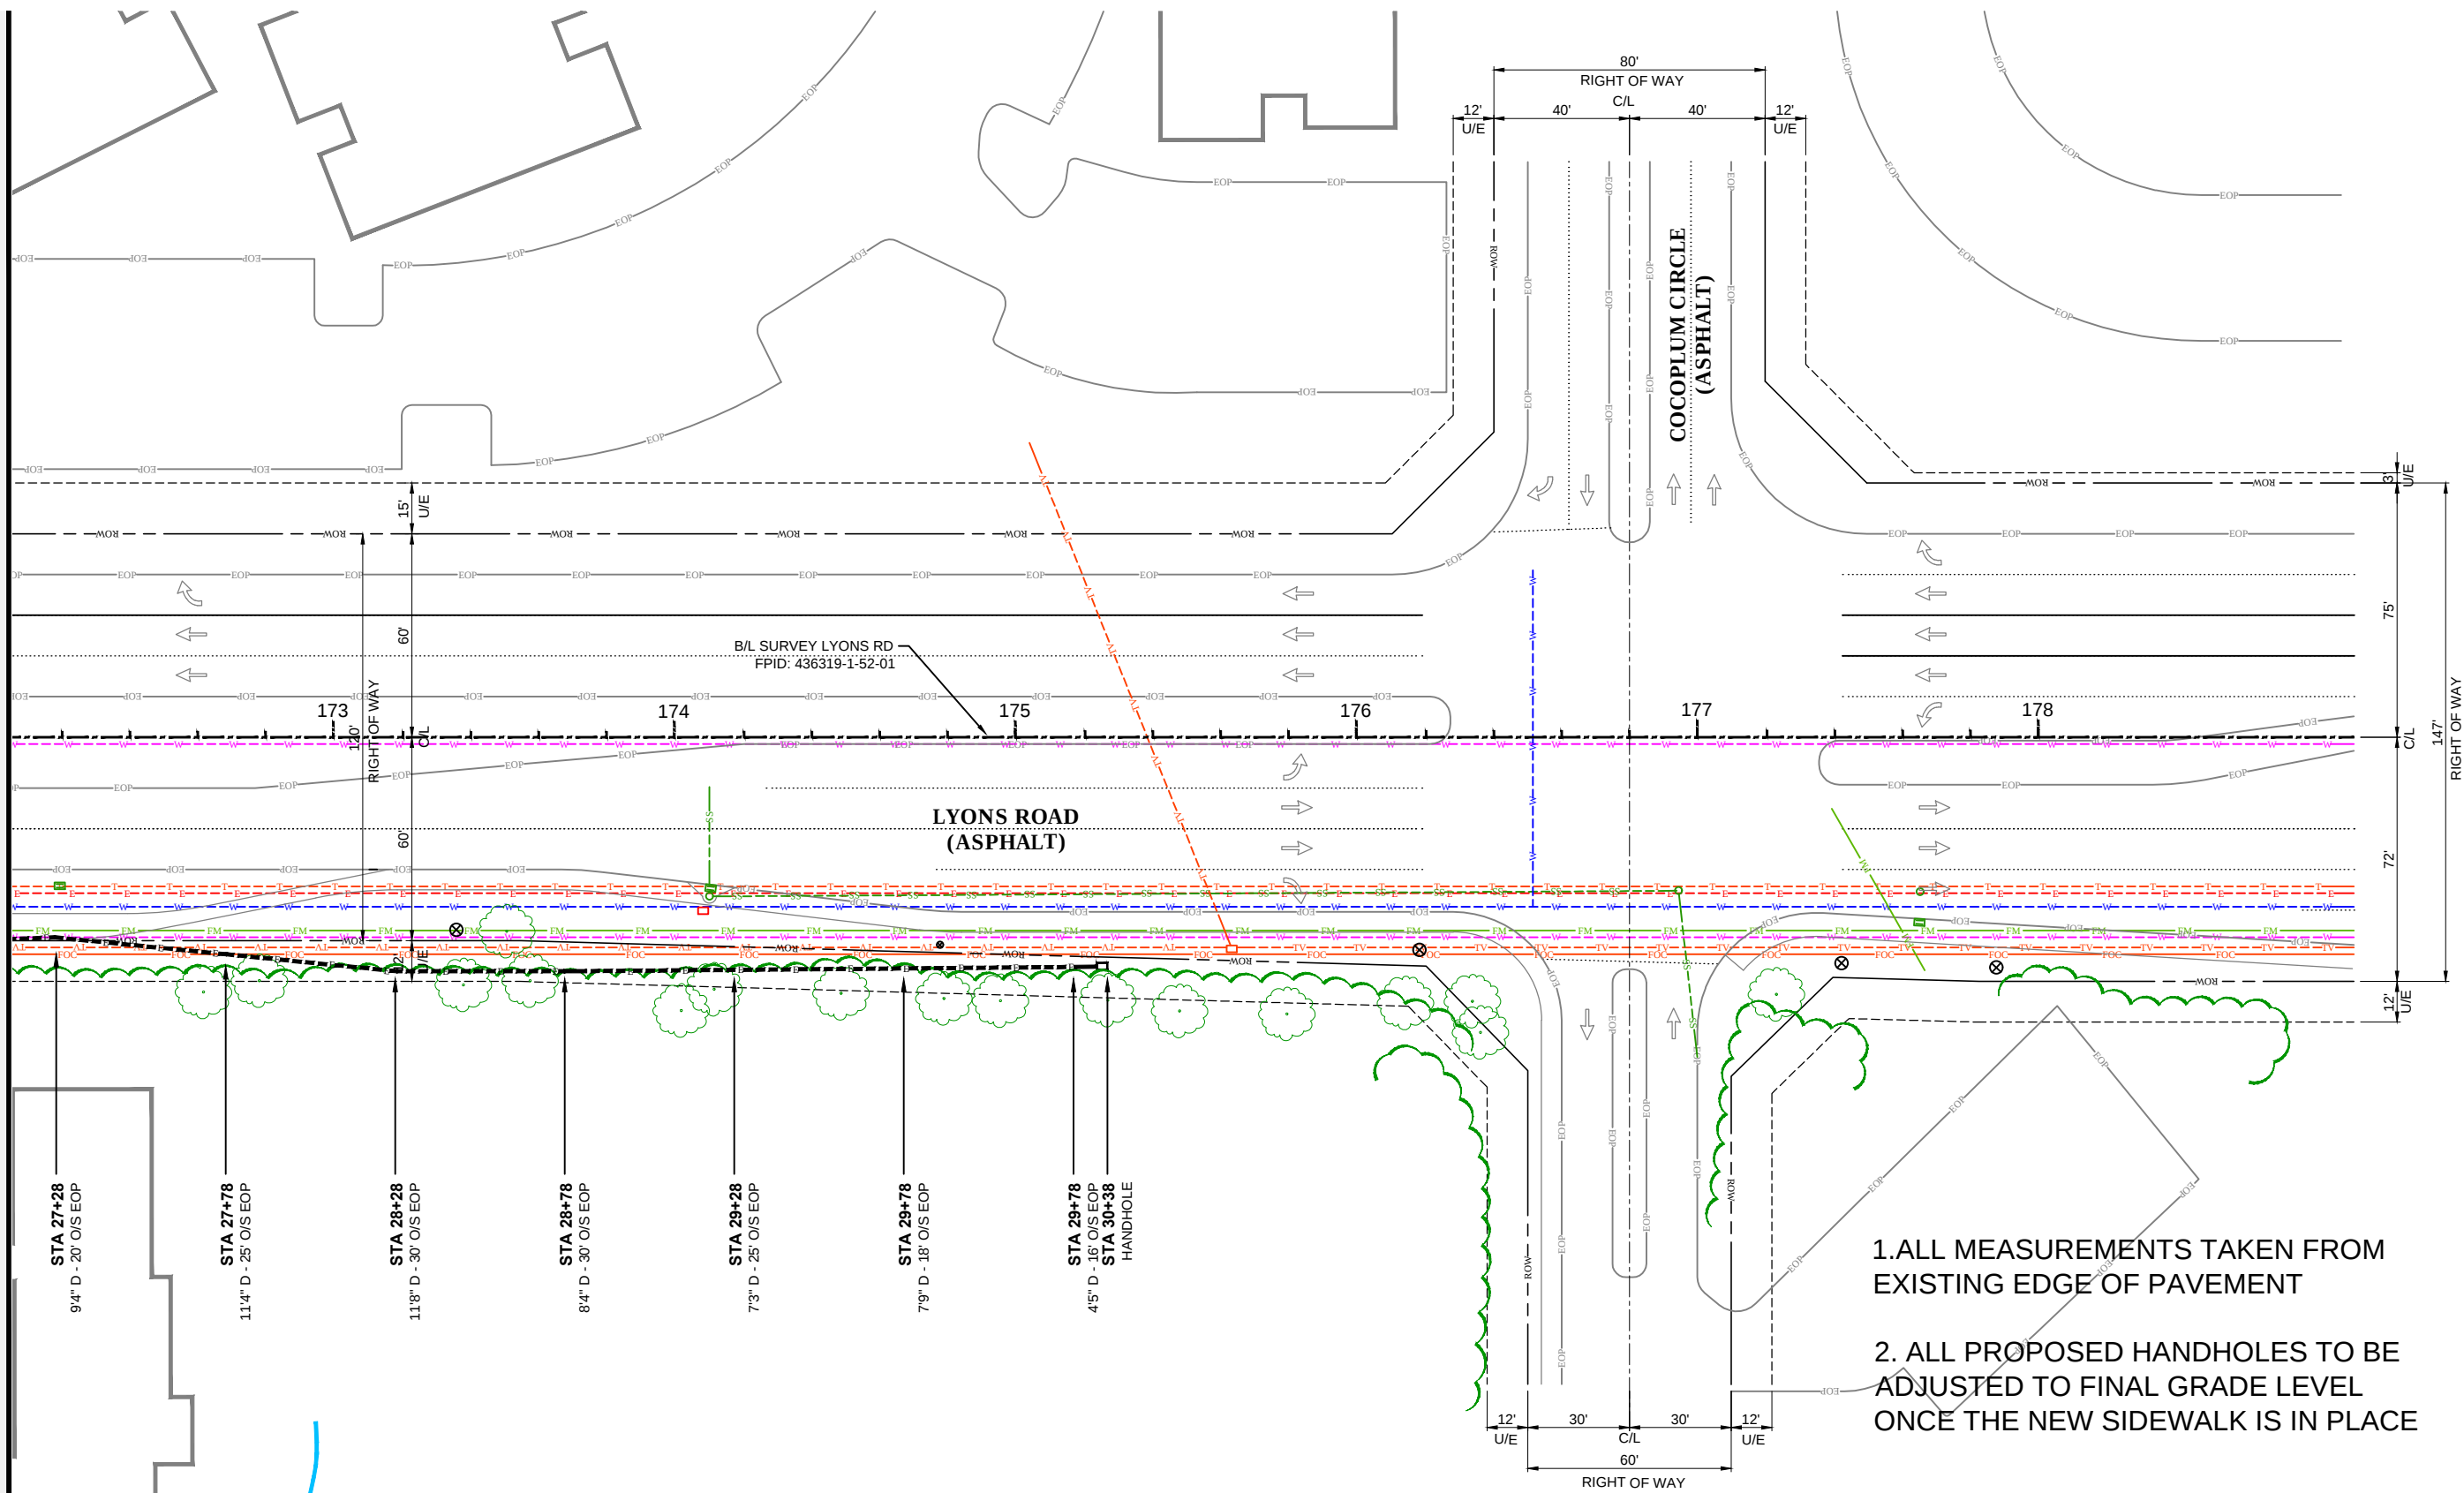

1. ALL MEASUREMENTS TAKEN FROM EXISTING EDGE OF PAVEMENT
2. ALL PROPOSED HANDHOLES TO BE ADJUSTED TO FINAL GRADE LEVEL ONCE THE NEW SIDEWALK IS IN PLACE




Know what's **below**.
Call before you dig.



► DIRECTION OF ENGINEERING

REV.	DATE	DESCRIPTION	PROJECT:	COUNTY:	SHEET NUMBER			
	080519	FIRST SUBMITTAL	FORCED RELOCATION LYONS RD - NORTH AS BUILT	BROWARD		006 OF 011		
	111319	AS BUILT		CITY: COCONUT CREEK				
				SCALE : 1"=50'	LOCATION: LYONS RD		TRACKING # :	
			FILE NAME : FR-LYONS RD - NORTH - AB.DWG			ASK-SE-1553		
			DATE : 11/13/19	TOWNSHIP : 50S	RANGE : 42E			
			DRAWING : CADDERCOMM					

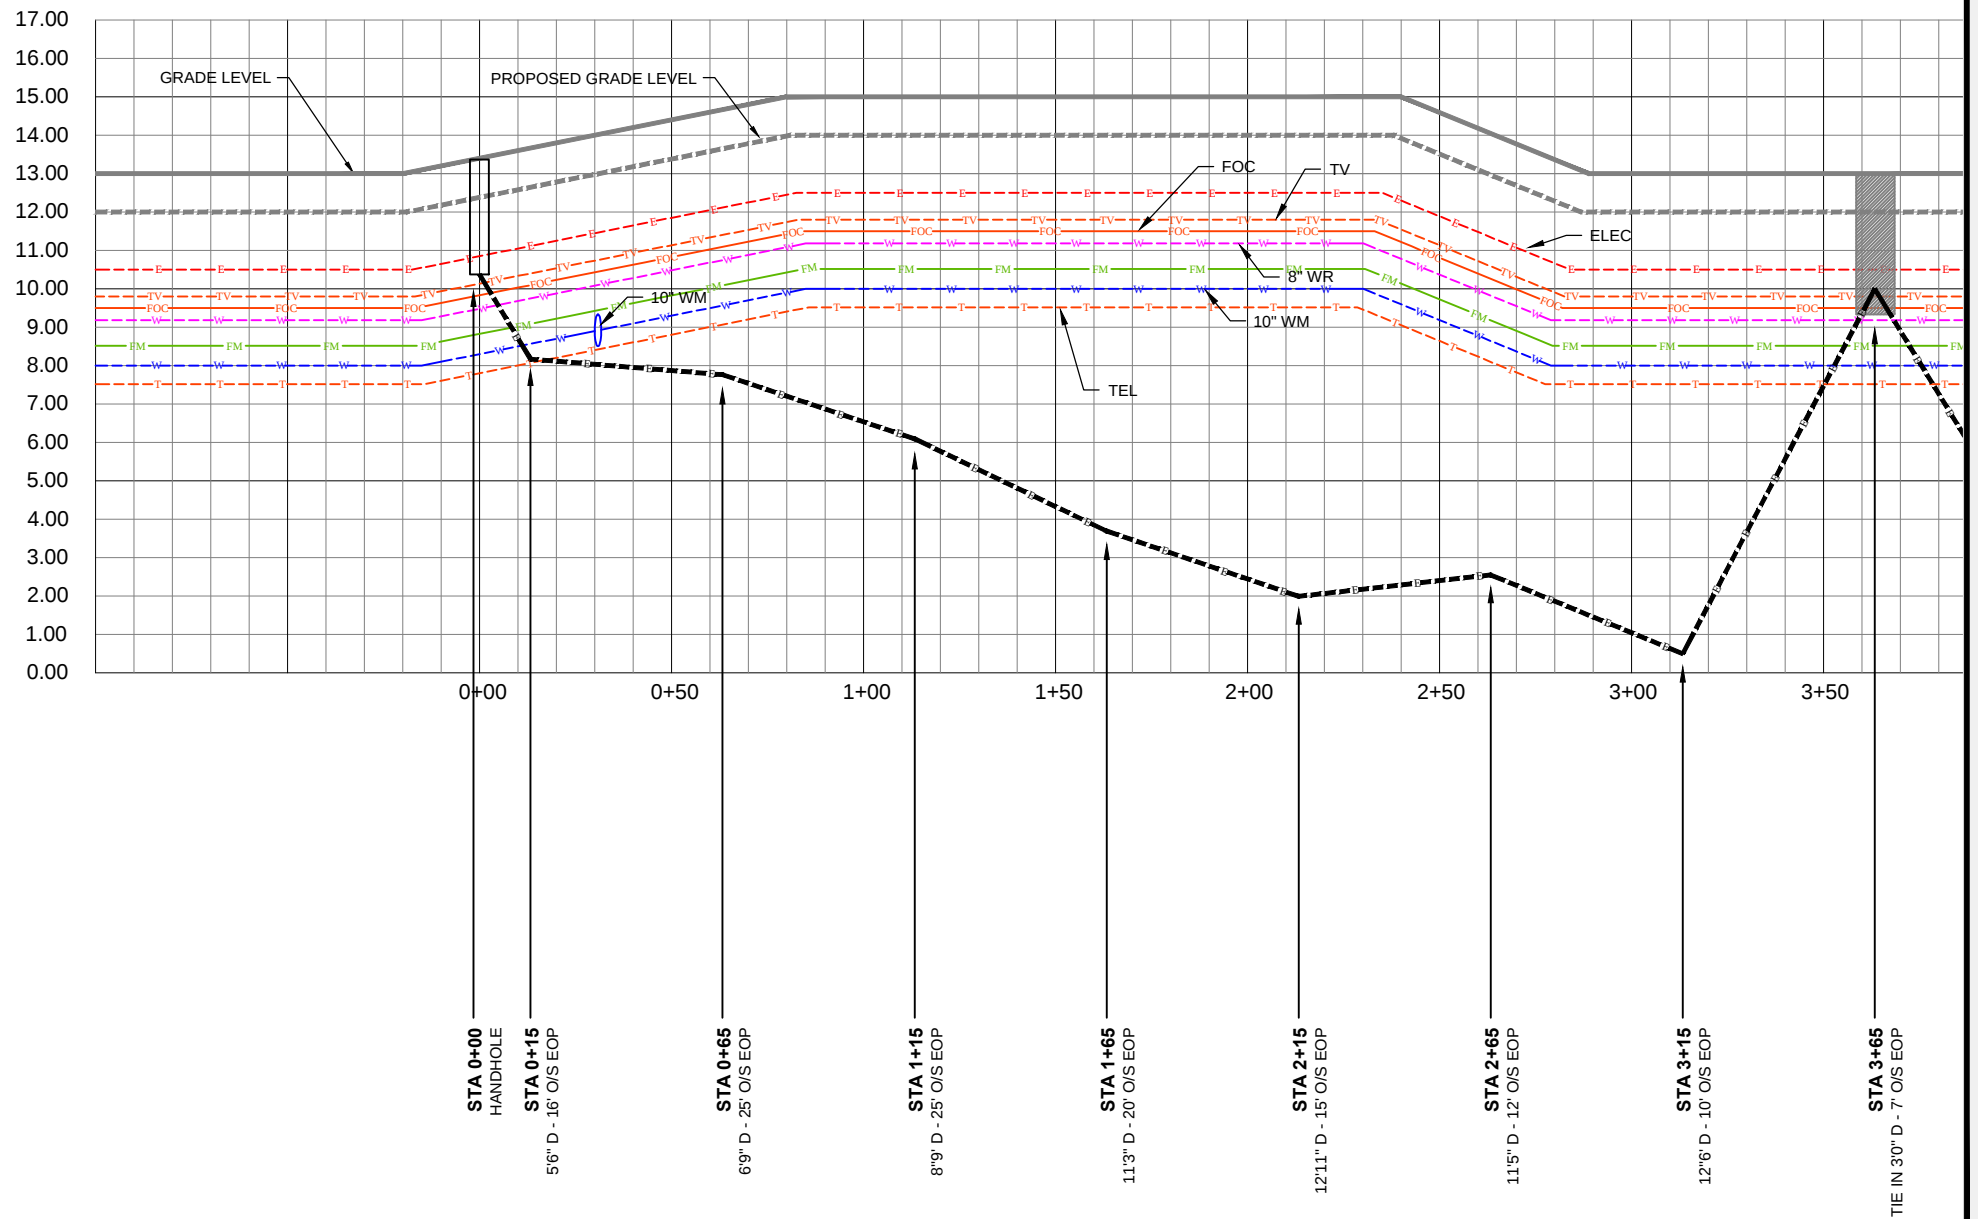

MATCH TO SHEET 008 - STA .3+90

PROFILE - LYONS RD

HORIZONTAL SCALE: 1"=50'
VERTICAL SCALE: 1"=5'




REV.	DATE	DESCRIPTION
	080519	FIRST SUBMITTAL
	111319	AS BUILT

PROJECT:	
FORCED RELOCATION	
LYONS RD - NORTH	
AS BUILT	
SCALE :	1"=50'
FILE NAME :	FR-LYONS RD - NORTH - AB.DWG
DATE :	11/13/19
DRAWING :	CADDERCOMM

COUNTY:	BROWARD	
CITY:	COCONUT CREEK	
LOCATION:	LYONS RD	
TOWNSHIP :	RANGE :	SECTION :
50S	42E	5

SHEET NUMBER
007 OF 011
TRACKING # :
ASK-SE-1553

MATCH TO SHEET 008 - STA 11+65

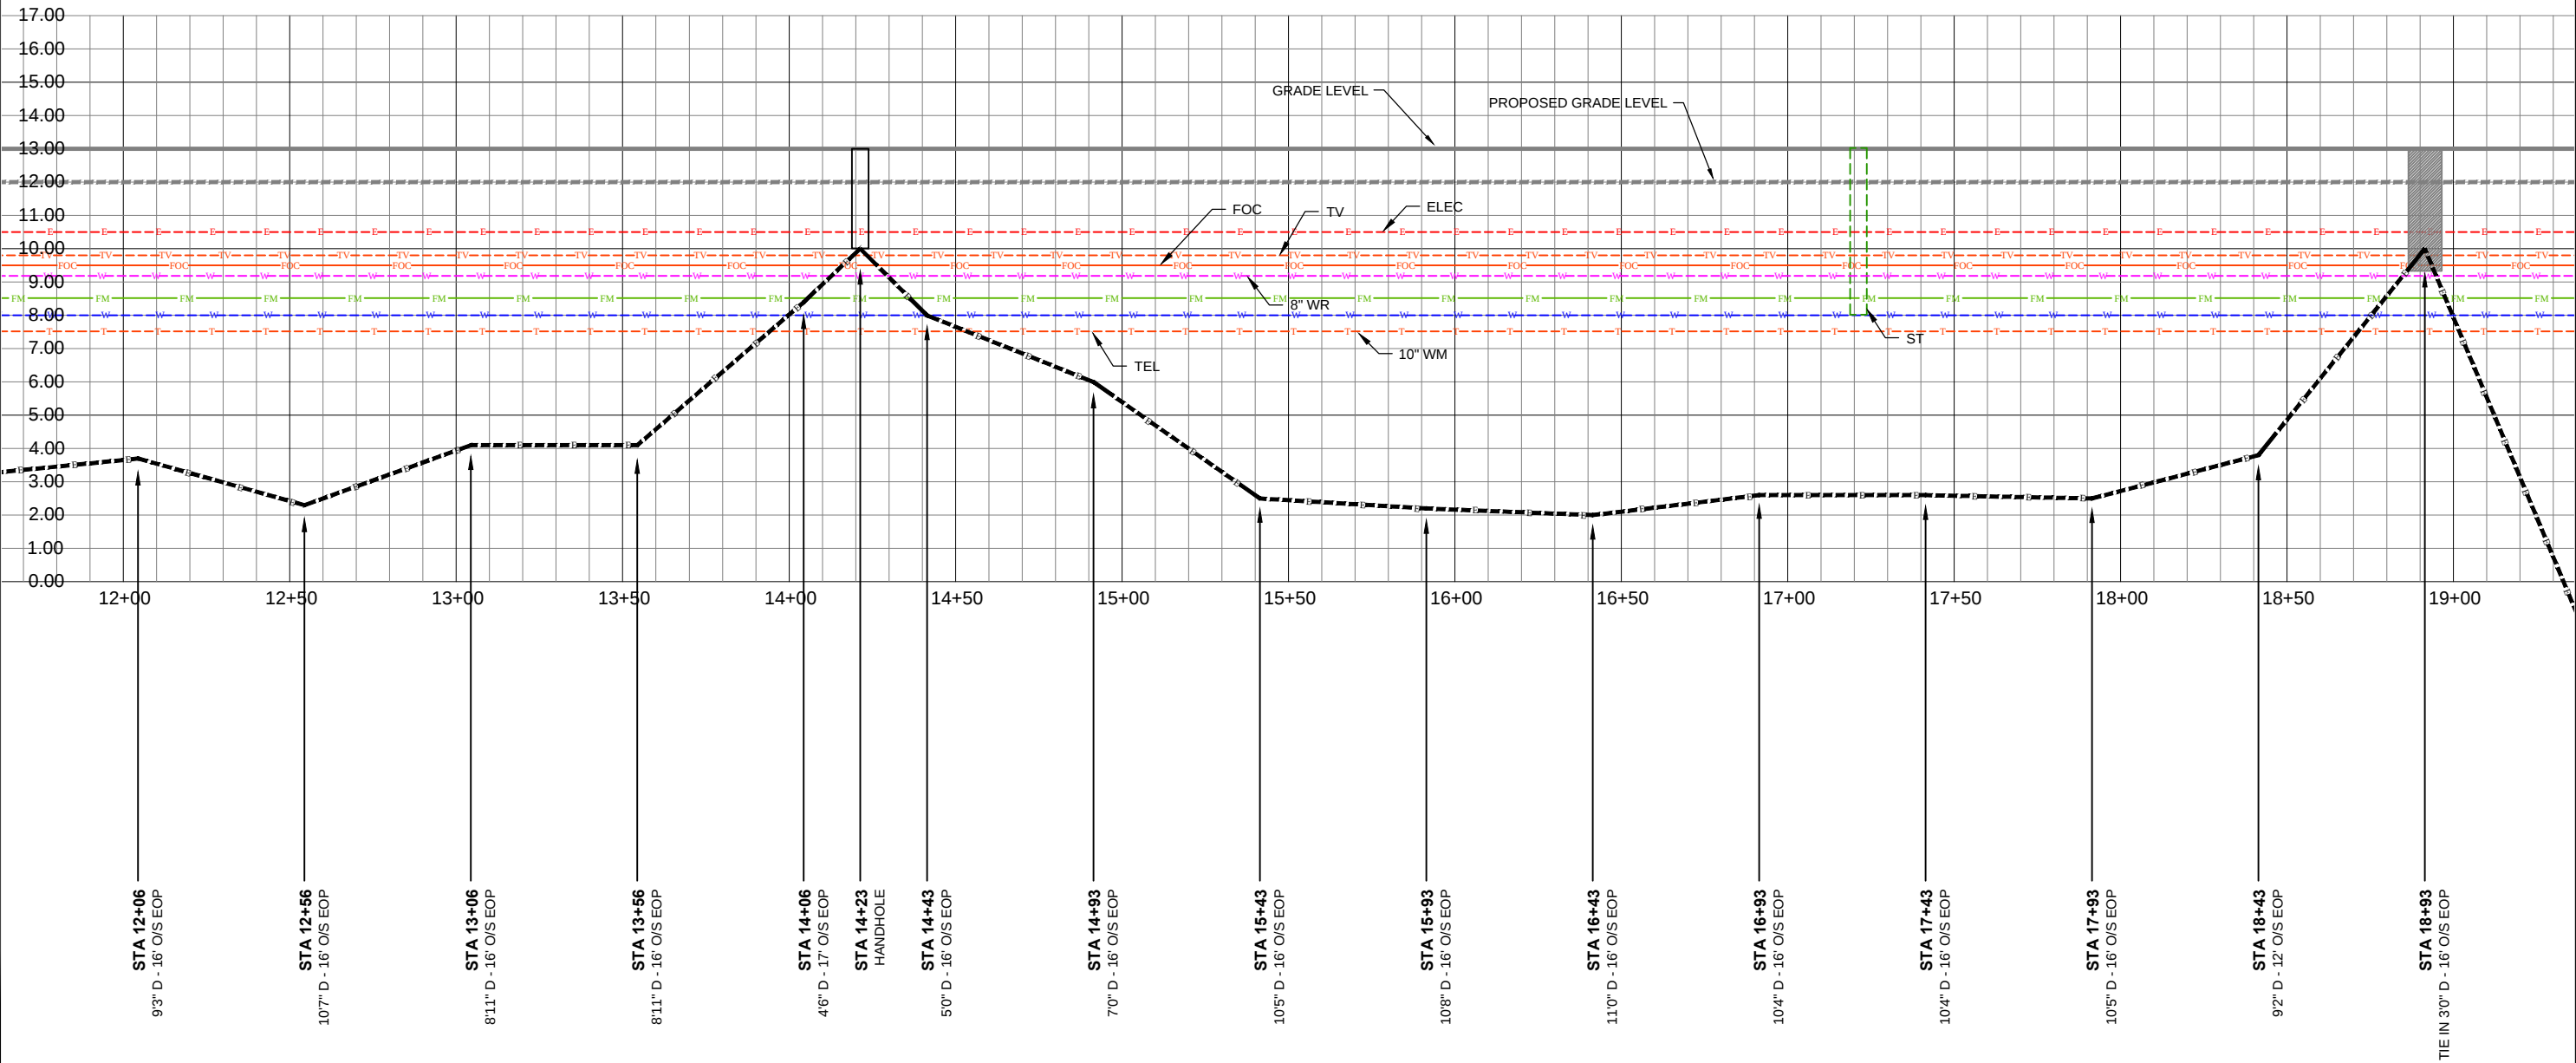

MATCH TO SHEET 010 - STA 19+40

PROFILE - LYONS RD

HORIZONTAL SCALE: 1"=50'
VERTICAL SCALE: 1"=5'




REV.	DATE	DESCRIPTION
	080519	FIRST SUBMITTAL
	111319	AS BUILT

PROJECT:	FORCED RELOCATION LYONS RD - NORTH AS BUILT
SCALE :	1"=50'
FILE NAME :	FR-LYONS RD - NORTH - AB.DWG
DATE :	11/13/19
DRAWING :	CADDERCOMM

COUNTY:	BROWARD
CITY:	COCONUT CREEK
LOCATION:	LYONS RD
TOWNSHIP :	50S
RANGE :	42E
SECTION :	5

SHEET NUMBER	009 OF 011
TRACKING # :	ASK-SE-1553

MATCH TO SHEET 009 - STA 19+40

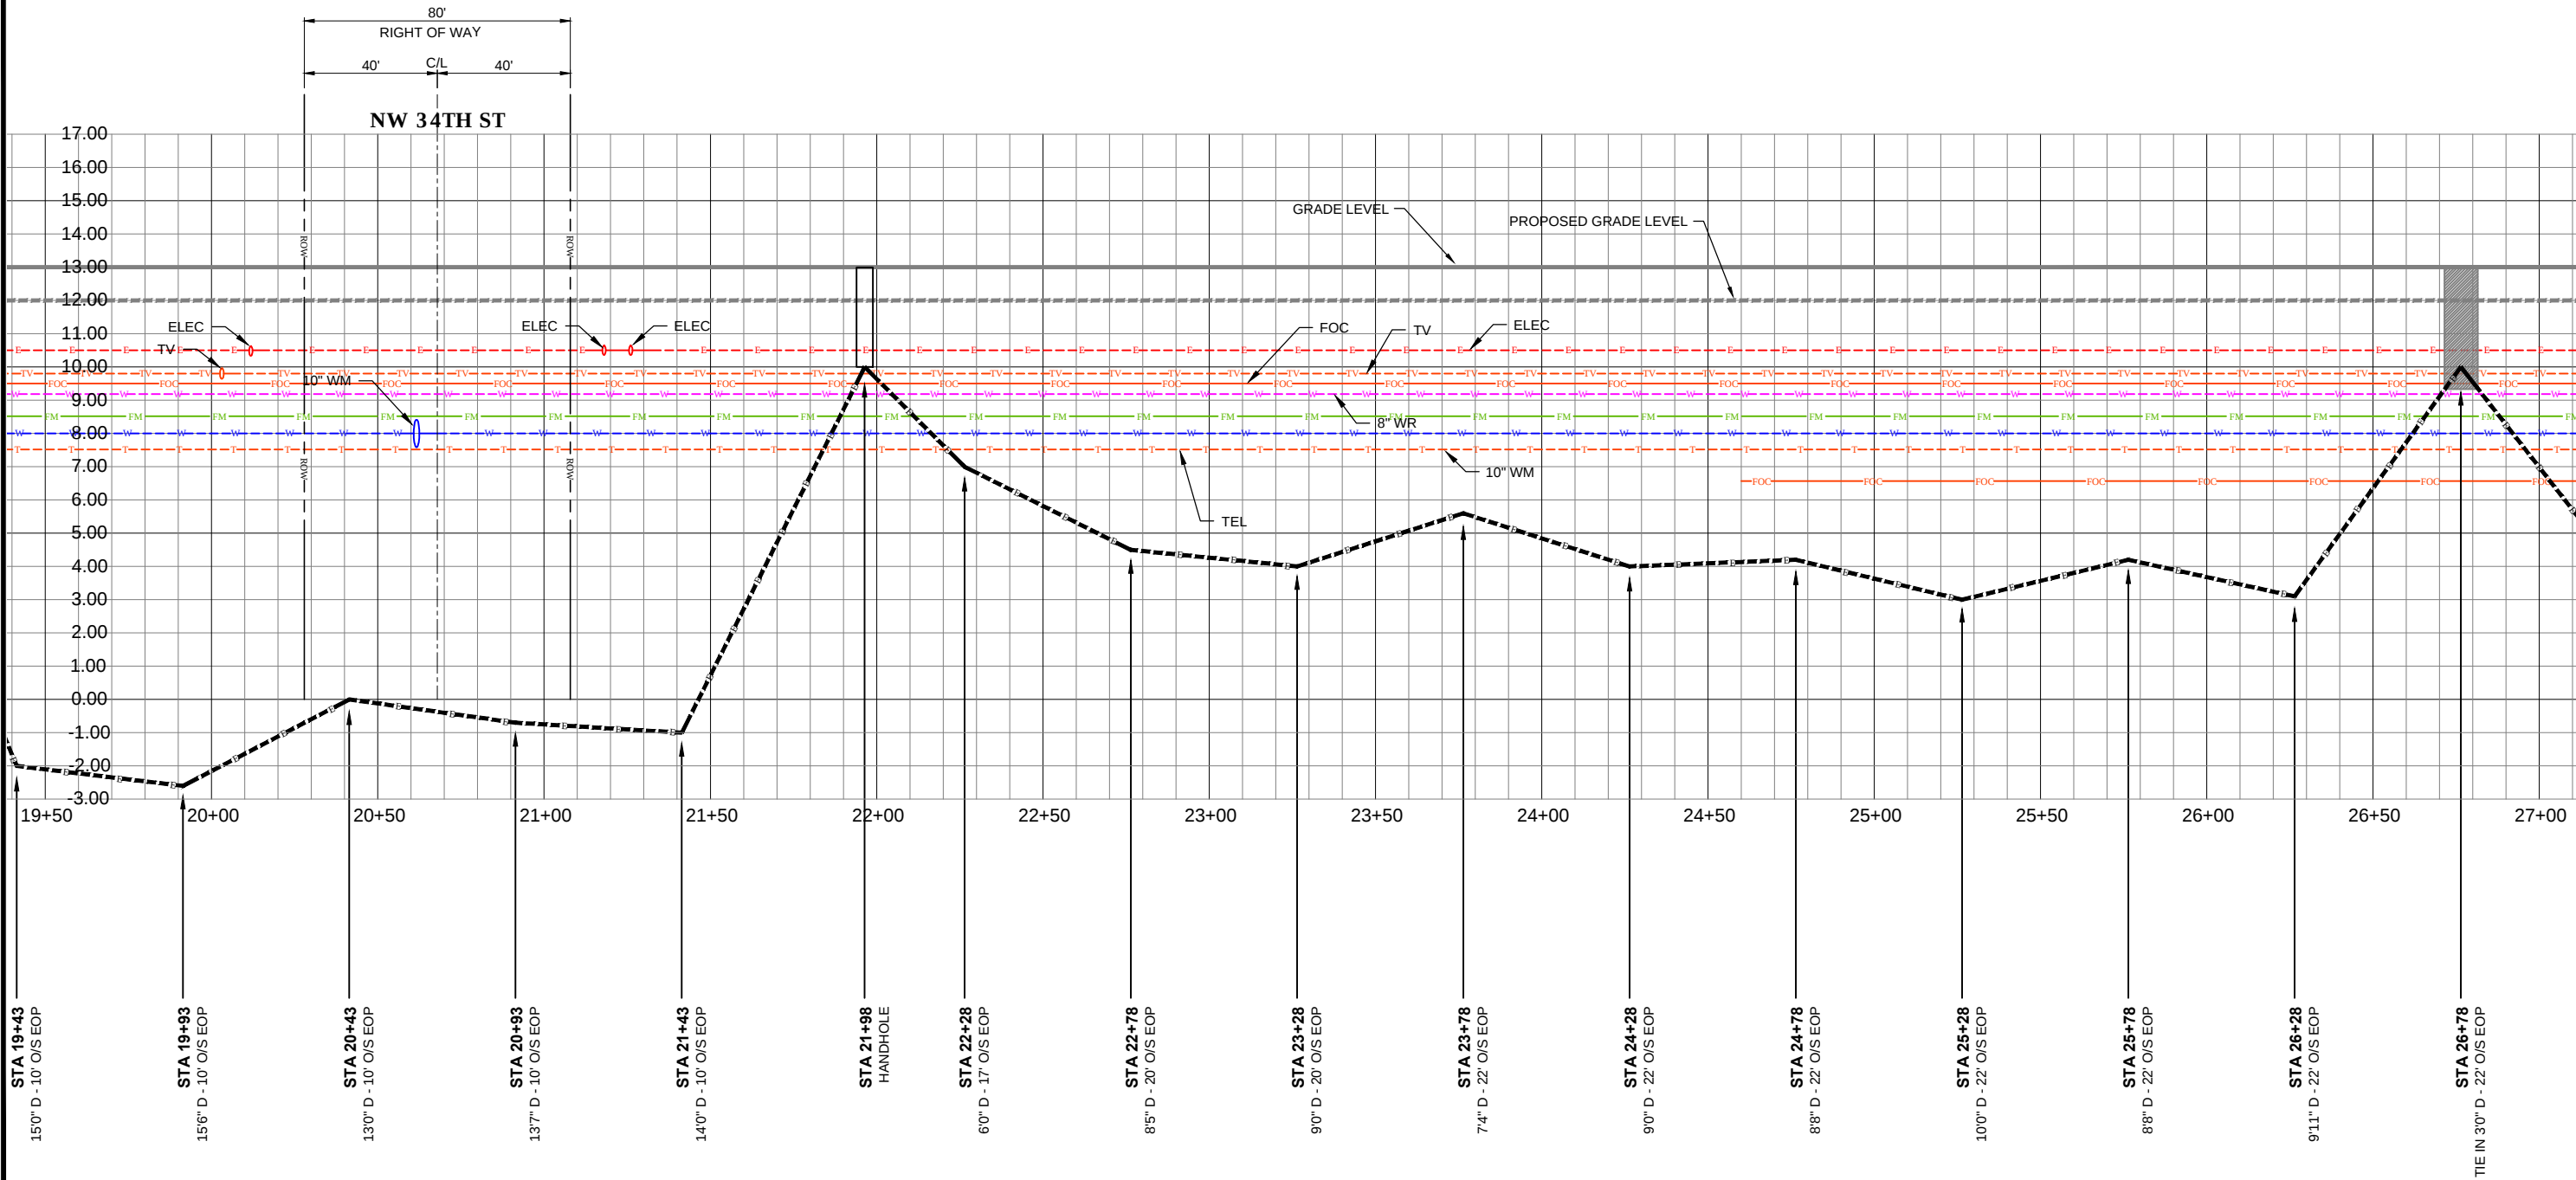

MATCH TO SHEET 011 - STA 27+15

PROFILE - LYONS RD

HORIZONTAL SCALE: 1"=50'
VERTICAL SCALE: 1"=5'




REV.	DATE	DESCRIPTION
	080519	FIRST SUBMITTAL
	111319	AS BUILT

PROJECT:	FORCED RELOCATION LYONS RD - NORTH AS BUILT
SCALE:	1"=50'
FILE NAME:	FR-LYONS RD - NORTH - AB.DWG
DATE:	11/13/19
DRAWING:	CADDERCOMM

COUNTY:	BROWARD
CITY:	COCONUT CREEK
LOCATION:	LYONS RD
TOWNSHIP:	50S
RANGE:	42E
SECTION:	5

SHEET NUMBER	010 OF 011
TRACKING #:	ASK-SE-1553

MATCH TO SHEET 010 - STA 27+15

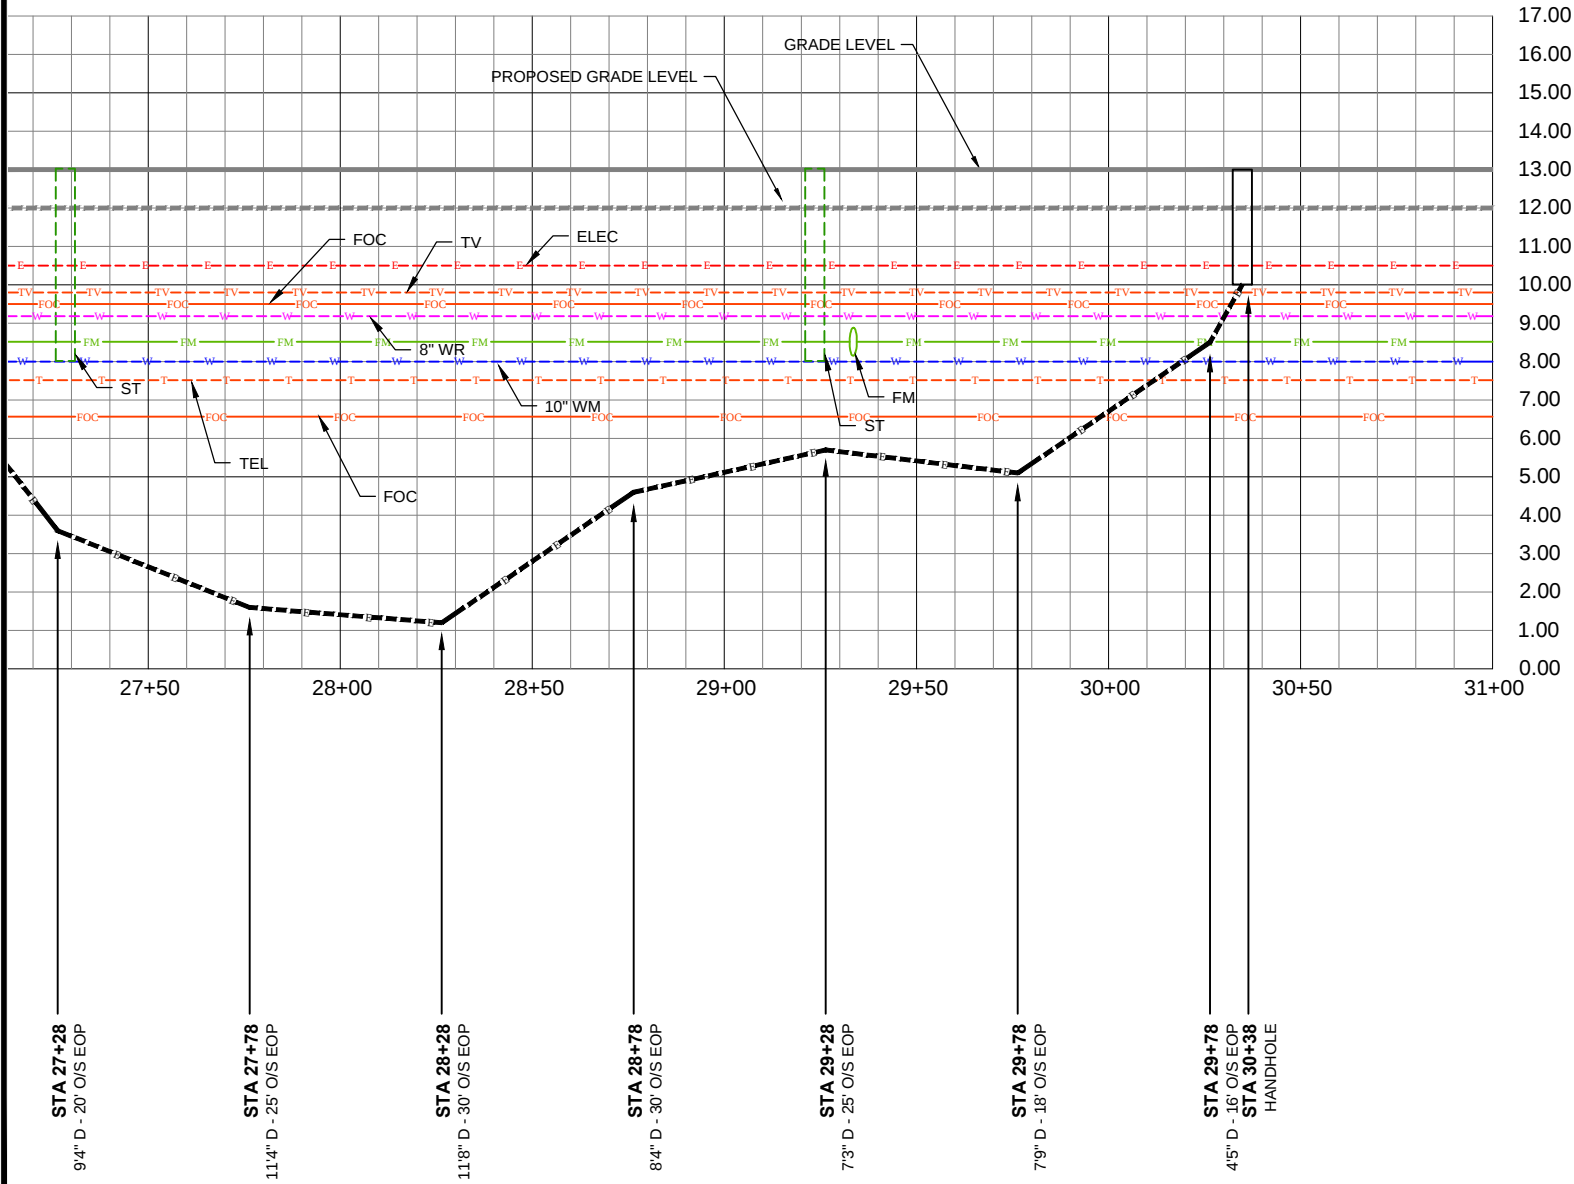

PROFILE - LYONS RD

HORIZONTAL SCALE: 1"=50'
VERTICAL SCALE: 1"=5'



REV.	DATE	DESCRIPTION
	080519	FIRST SUBMITTAL
	111319	AS BUILT

PROJECT:	FORCED RELOCATION LYONS RD - NORTH AS BUILT
SCALE :	1"=50'
FILE NAME :	FR-LYONS RD - NORTH - AB.DWG
DATE :	11/13/19
DRAWING :	CADDERCOMM

COUNTY:	BROWARD
CITY:	COCONUT CREEK
LOCATION:	LYONS RD
TOWNSHIP :	50S
RANGE :	42E
SECTION :	5

SHEET NUMBER	011 OF 011
TRACKING # :	ASK-SE-1553