

SPECIFIC PURPOSE SURVEY

AS BUILT DRAWING

TRADEWINDS PARK UTILITIES IMPROVEMENT

BROWARD COUNTY PARKS AND RECREATION


PROJECT No. R1423108P1

H.D.P.E FORCE MAIN



AS BUILT PLANS
SHEET C-2


LOCATION MAP

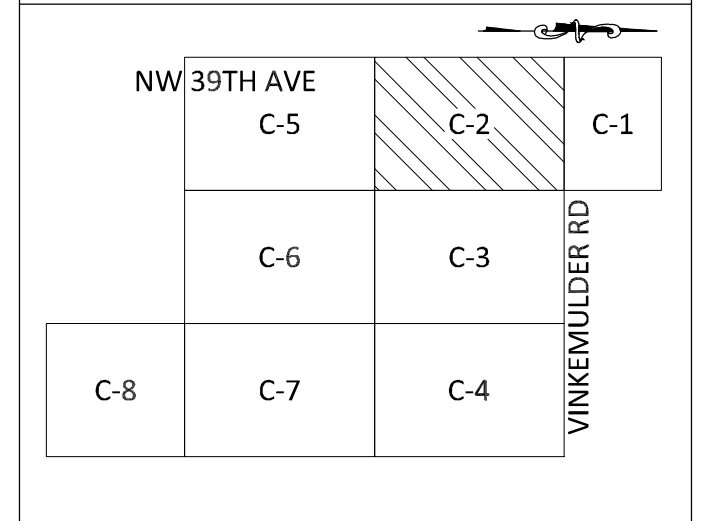

LEGEND

BOP	BOTTOM OF PIPE
BOT	BOTTOM
BSP	BACTERIAL SAMPLING POINT
BU	BUBBLE UP STRUCTURE
CB	CATCH BASIN
CE	CONTROL ELEVATION
CLEAR	CLEARANCE
CMH	CONFLICT MANHOLE
CMP	CORRUGATED METAL PIPE
CONC	CONCRETE
CS	CONTROL STRUCTURE
DDCV	DOUBLE DETECTOR CHECK VALVE
DIP	DUCTILE IRON PIPE
DR	DRAINAGE
ELEV	ELEVATION
EXIST	EXISTING
FDC	FIRE DEPARTMENT CONNECTION
FFE	FINISHED FLOOR ELEVATION
FH	FIRE HYDRANT
FT	FEET
GV	GATE VALVE
GRD	FINISH GRADE
HDPE	HIGH DENSITY POLYETHYLENE
HW	HEADWALL
IE	INVERT ELEVATION
INV	INVERT OF PIPE
LF	LINEAR FEET
MAS	MAINTENANCE ACCESS STRUCTURE
NAVD	NORTH AMERICAN VERTICAL DATUM
OUT	OUTFALL
PL	PROPERTY LINE
PVC	POLYVINYL CHLORIDE PIPE
PROP	PROPOSED
RE	RIM ELEVATION
RIM	RIM OF STRUCTURE
RCP	REINFORCED CONCRETE PIPE
RPZ	REDUCED PRESSURE ZONE BACKFLOW PREVENTER
R/W	RIGHT OF WAY
STR	STRUCTURE
TOP	TOP OF PIPE
TYP	TYPICAL
WM	WATER MAIN
W/	WITH
YD	YARD DRAIN

	EXIST GRADE (FT-NAVD)
	PROP GRADE (FT-NAVD)
	ASPHALT PAVEMENT
	TO BE REMOVED CONFLICT MARKER
	TO BE REMOVED
	CHAIN LINK FENCE
	DECORATIVE FENCE
	PROPERTY LINE
	EASEMENT LINE
	R/W LINE

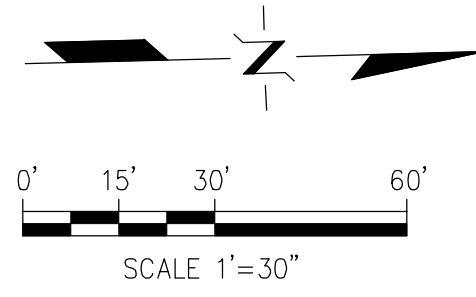


MATCHLINE SHEET C-5

MATCHLINE SHEET C-1

SURVEYOR'S REPORT:


1. THIS IS NOT A BOUNDARY SURVEY.
2. THE SPECIFIC PURPOSE OF THIS SURVEY IS TO SHOW THE LOCATION OF THE FORCED MAIN AND TOP OF PIPE ELEVATIONS OF THE FITTINGS AS WELL AS THE CROSSING WITH OTHER UTILITIES LINES.
3. AS BUILT FEATURES IN BOLD.
4. BUILDING AND/OR OTHER FEATURES IF SHOWN ARE FOR REFERENCE PURPOSES ONLY.
5. ASPHALT PAVEMENT AND PARK TRAILS BASED ON ORIGINAL UNDERLAID SURVEY PROVIDED BY CONTRACTOR.
6. EXAMINATION OF THE ABSTRACT OF TITLE WILL HAVE TO BE MADE TO DETERMINE RECORDED INSTRUMENTS, IF ANY, AFFECTING THE PROPERTY.
7. THIS SURVEY IS SUBJECT TO DEDICATIONS, LIMITATIONS, RESTRICTIONS, RESERVATIONS OR EASEMENTS OF RECORD.
8. THIS FIRM HAS NOT ATTEMPTED TO LOCATE FOOTING AND/OR FOUNDATIONS AND/OR UNDERGROUND IMPROVEMENTS OF ANY NATURE UNLESS RELATED TO THE SUBJECT AS BUILT.
9. COORDINATES SYSTEM BASED ON FLORIDA STATE PLANE COORDINATES N.A.D. 83 FLORIDA EAST, 1990 ADJUSTMENT.
10. ELEVATIONS SHOWN ARE BASED ON N.A.V.D. 88 VERTICAL DATUM.
11. LAST DATE OF THE FIELDWORK 12/22/2023

CERTIFY TO: WEEKLEY ASPHALT PAVING, INC.

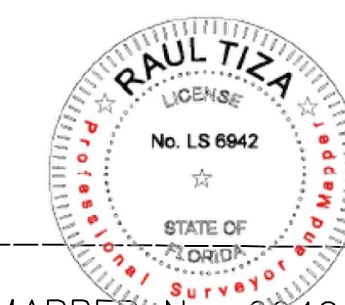

RAUL TIZA
LAND SURVEYOR AND MAPPER No. 6842, LB 8029.
STATE OF FLORIDA
18761 SW 291st TERRACE MIAMI FLORIDA 33030
PHONE: 786-975-8588

NOT VALID WITHOUT THE SIGNATURE AND THE ELECTRONIC SEAL OF A FLORIDA LICENSED SURVEYOR AND MAPPER

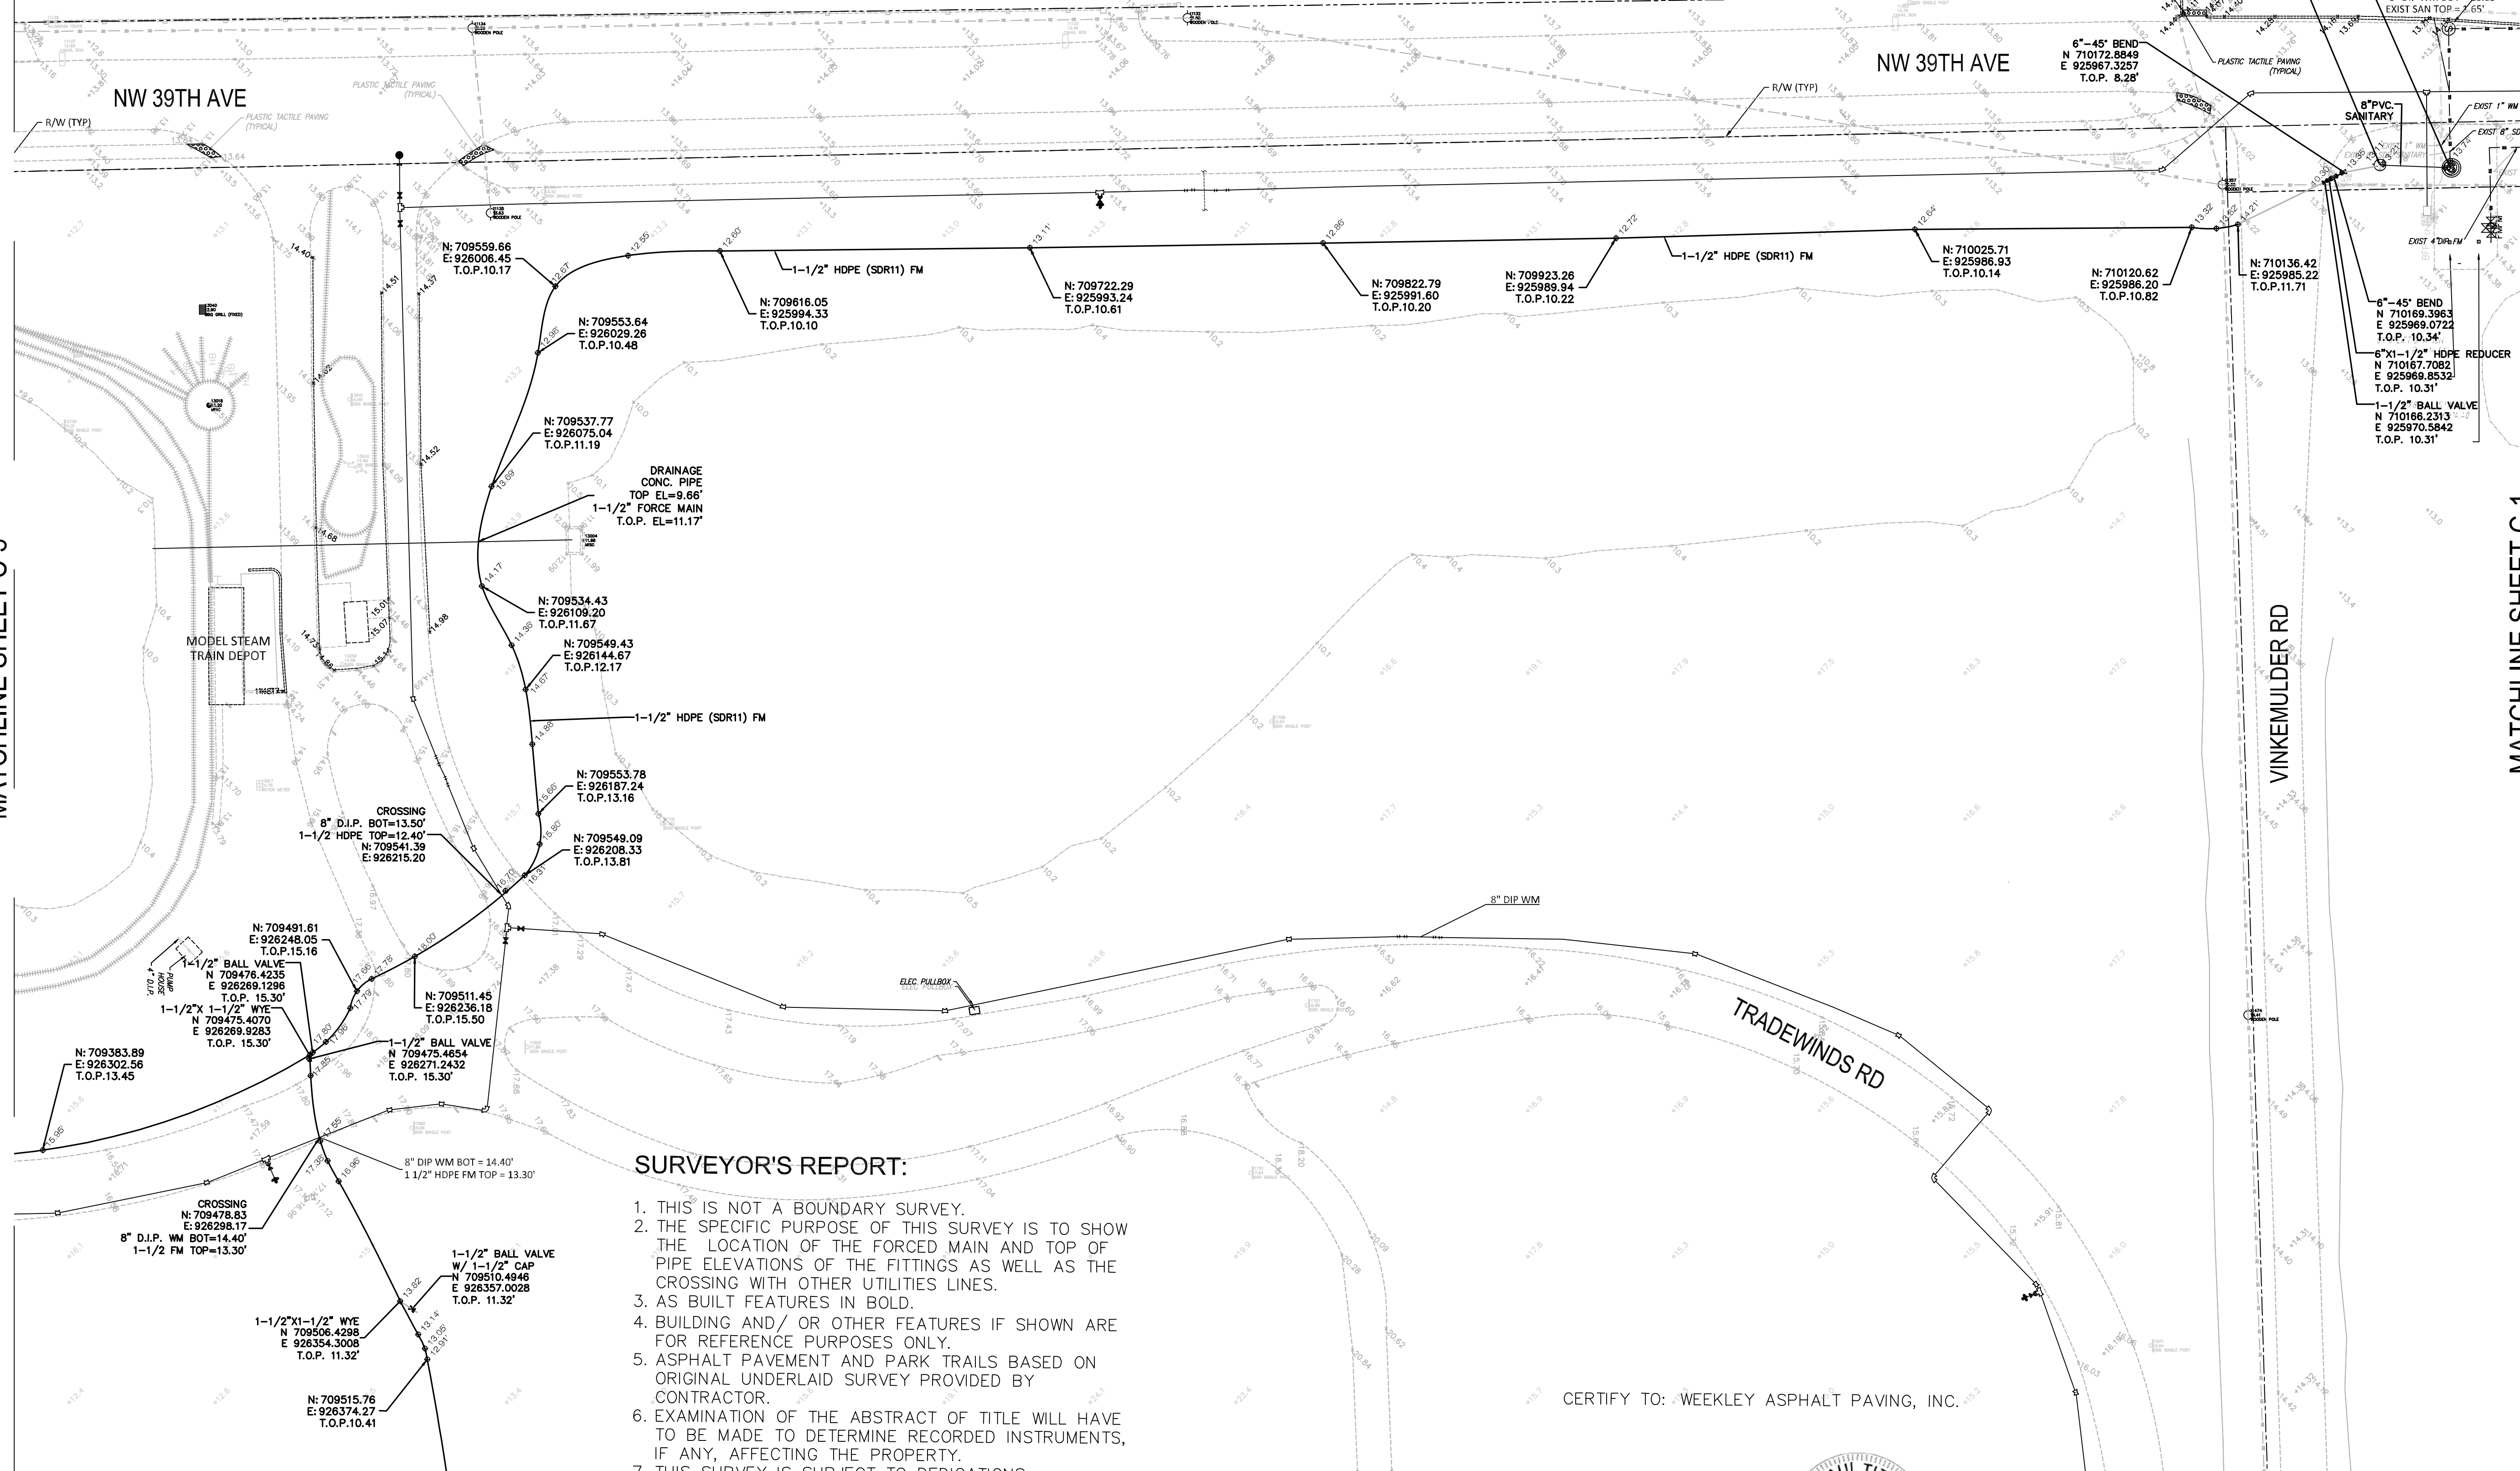

SPECIFIC PURPOSE SURVEY


AS BUILT DRAWING

TRADEWINDS PARK UTILITIES IMPROVEMENT


BROWARD COUNTY PARKS AND RECREATION

MATCHLINE SHEET C-2

PROJECT No. R1423108P1
H.D.P.E FORCE MAIN

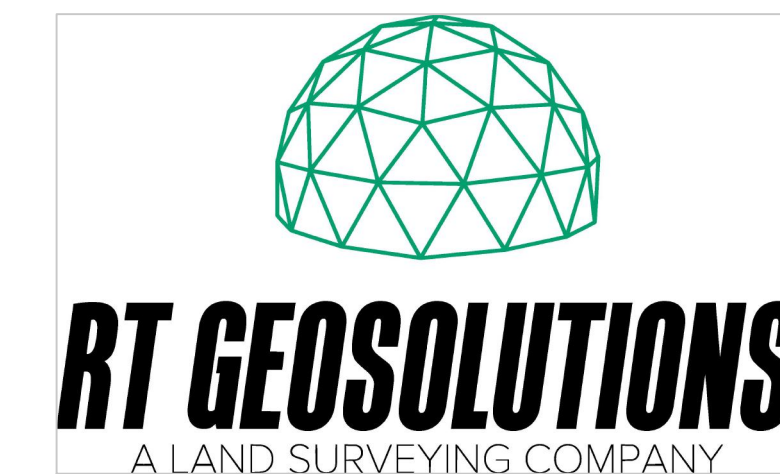


AS BUILT PLANS
SHEET C-3

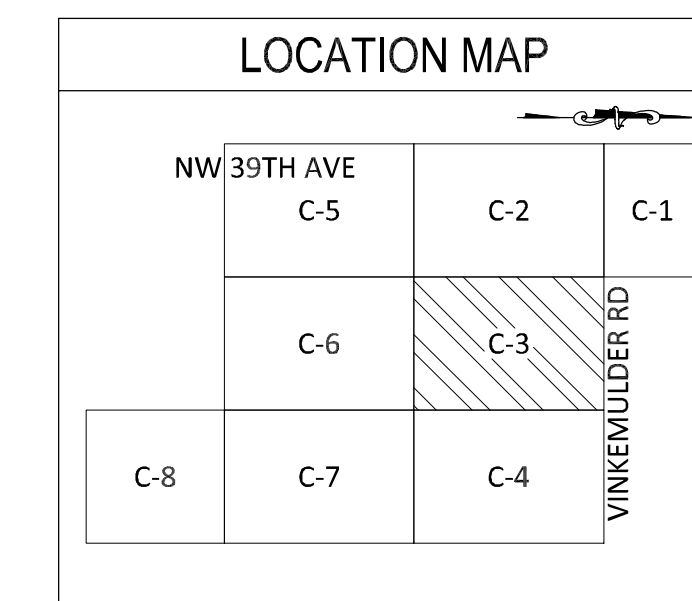

SURVEYOR'S REPORT:


1. THIS IS NOT A BOUNDARY SURVEY.
2. THE SPECIFIC PURPOSE OF THIS SURVEY IS TO SHOW THE LOCATION OF THE FORCED MAIN AND TOP OF PIPE ELEVATIONS OF THE FITTINGS AS WELL AS THE CROSSING WITH OTHER UTILITIES LINES.
3. AS BUILT FEATURES IN BOLD.
4. BUILDING AND/ OR OTHER FEATURES IF SHOWN ARE FOR REFERENCE PURPOSES ONLY.
5. ASPHALT PAVEMENT AND PARK TRAILS BASED ON ORIGINAL UNDERLAID SURVEY PROVIDED BY CONTRACTOR.
6. EXAMINATION OF THE ABSTRACT OF TITLE WILL HAVE TO BE MADE TO DETERMINE RECORDED INSTRUMENTS, IF ANY, AFFECTING THE PROPERTY.
7. THIS SURVEY IS SUBJECT TO DEDICATIONS, LIMITATIONS, RESTRICTIONS, RESERVATIONS OR EASEMENTS OF RECORD.
8. THIS FIRM HAS NOT ATTEMPTED TO LOCATE FOOTING AND/OR FOUNDATIONS AND/OR UNDERGROUND IMPROVEMENTS OF ANY NATURE UNLESS RELATED TO THE SUBJECT AS BUILT.
9. COORDINATES SYSTEM BASED ON FLORIDA STATE PLANE COORDINATES N.A.D. 83 FLORIDA EAST, 1990 ADJUSTMENT.
10. ELEVATIONS SHOWN ARE BASED ON N.A.V.D. 88 VERTICAL DATUM.
11. LAST DATE OF THE FIELDWORK 12/22/2023

MATCHLINE SHEET C-6

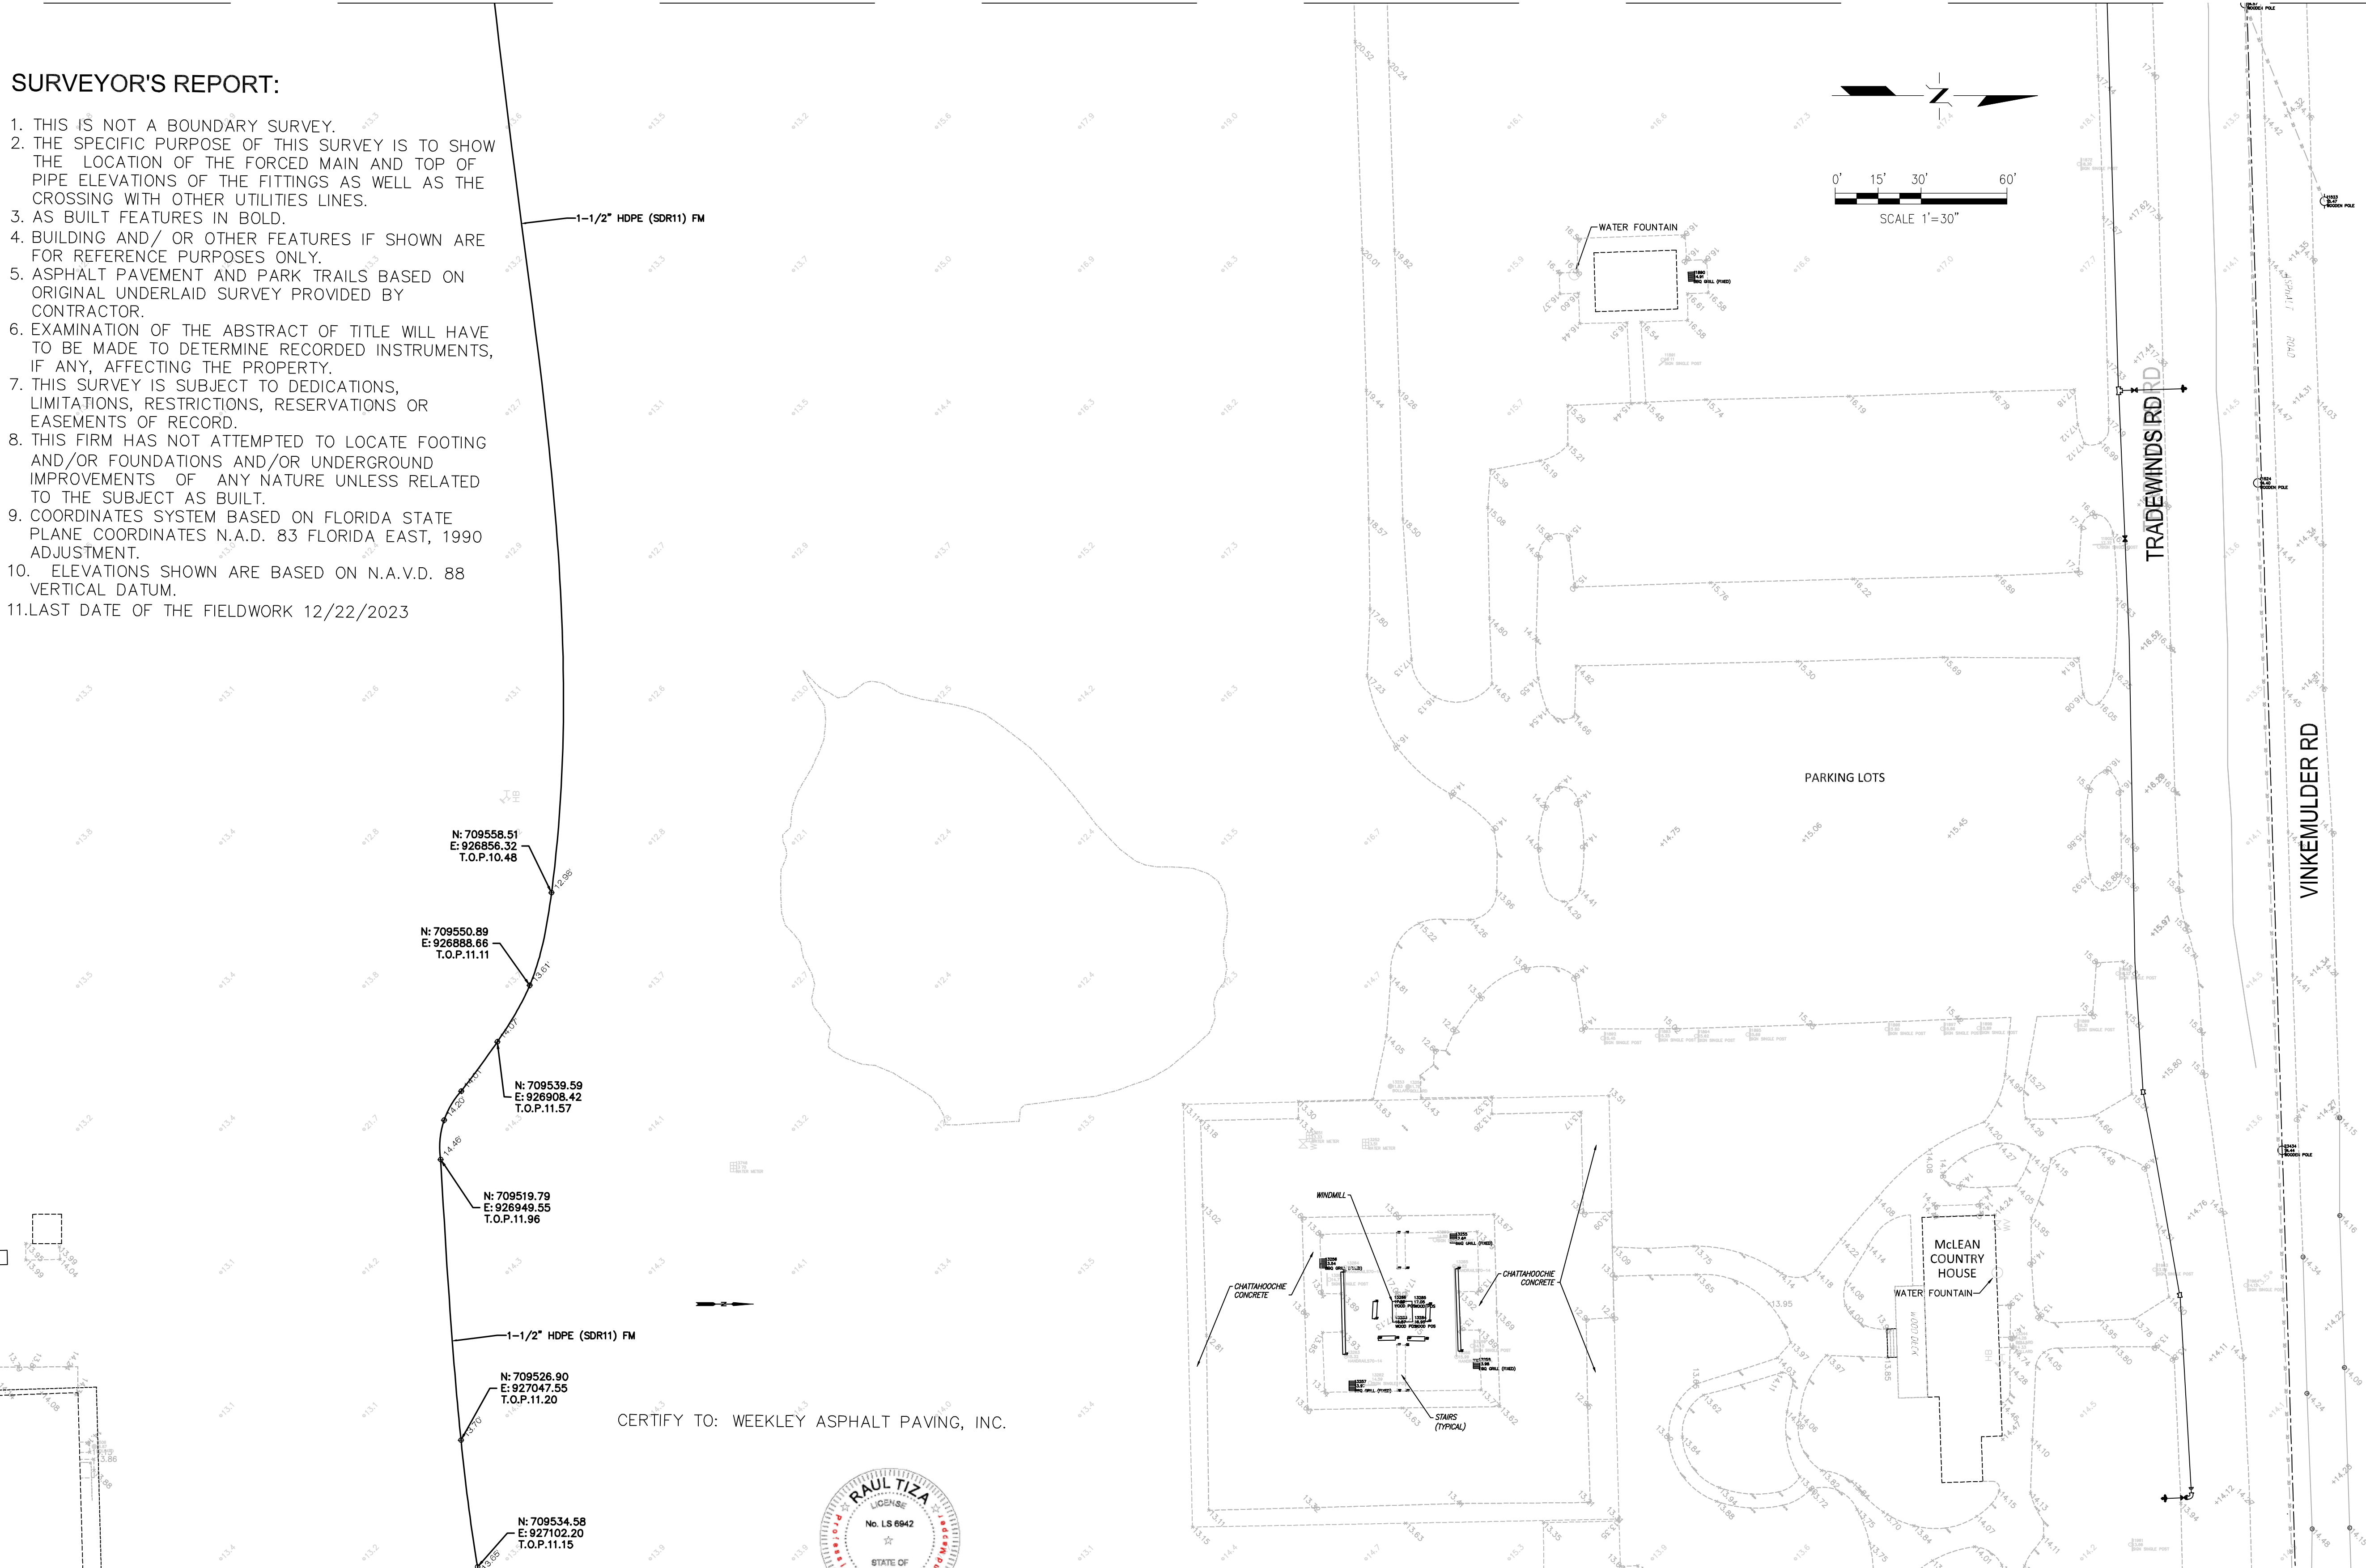

- N: 709558.51
E: 926856.32
T.O.P. 10.48
- N: 709550.89
E: 926888.66
T.O.P. 11.11
- N: 709539.59
E: 926908.42
T.O.P. 11.57
- N: 709519.79
E: 926948.55
T.O.P. 11.96
- N: 709526.90
E: 927047.55
T.O.P. 11.20
- N: 709534.58
E: 927102.20
T.O.P. 11.15

CERTIFY TO: WEEKLEY ASPHALT PAVING, INC.

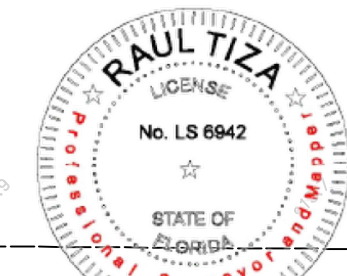

RAUL TIZA
LAND SURVEYOR AND MAPPER No. 6942, LB 8029.
STATE OF FLORIDA
18761 SW 29th TERRACE MIAMI FLORIDA 33030
PHONE: 786-975-8588

NOT VALID WITHOUT THE SIGNATURE AND THE ELECTRONIC SEAL OF A FLORIDA LICENSED SURVEYOR AND MAPPER

LEGEND

BOP	BOTTOM OF PIPE
BOT	BOTTOM
BSP	BACTERIAL SAMPLING POINT
BU	BUBBLE UP STRUCTURE
CB	CATCH BASIN
CE	CONTROL ELEVATION
CLEAR	CLEARANCE
CMH	CONFLICT MANHOLE
CMP	CORRUGATED METAL PIPE
CONC	CONCRETE
CS	CONTROL STRUCTURE
DDCV	DOUBLE DETECTOR CHECK VALVE
DIP	DUCTILE IRON PIPE
DR	DRAINAGE
ELEV	ELEVATION
EXIST	EXISTING
FDC	FIRE DEPARTMENT CONNECTION
FFE	FINISHED FLOOR ELEVATION
FH	FIRE HYDRANT
FT	FEET
GV	GATE VALVE
GRD	FINISH GRADE
HDPE	HIGH DENSITY POLYETHYLENE
HW	HEADWALL
IE	INVERT ELEVATION
INV	INVERT OF PIPE
LF	LINEAR FEET
MAS	MAINTENANCE ACCESS STRUCTURE
NAVD	NORTH AMERICAN VERTICAL DATUM
OUT	OUTFALL
P	PROPERTY LINE
PVC	POLYVINYL CHLORIDE PIPE
PROP	PROPOSED
RE	RIM ELEVATION
RIM	RIM OF STRUCTURE
RCP	REINFORCED CONCRETE PIPE
RPZ	REDUCED PRESSURE ZONE BACKFLOW PREVENTER
R/W	RIGHT OF WAY
STR	STRUCTURE
TOP	TOP OF PIPE
TYP	TYPICAL
WM	WATER MAIN
W/	WITH
YD	YARD DRAIN

	EXIST GRADE (FT-NAVD)
	PROP GRADE (FT-NAVD)
	ASPHALT PAVEMENT
	TO BE REMOVED CONFLICT MARKER
	TO BE REMOVED CHAIN LINK FENCE
	DECORATIVE FENCE
	PROPERTY LINE
	EASEMENT LINE
	R/W LINE


SPECIFIC PURPOSE SURVEY

PROJECT No. R1423108P1
H.D.P.E FORCE MAIN





AS BUILT DRAWING TRADEWINDS PARK UTILITIES IMPROVEMENT BROWARD COUNTY PARKS AND RECREATION

MATCHLINE SHEET C-3

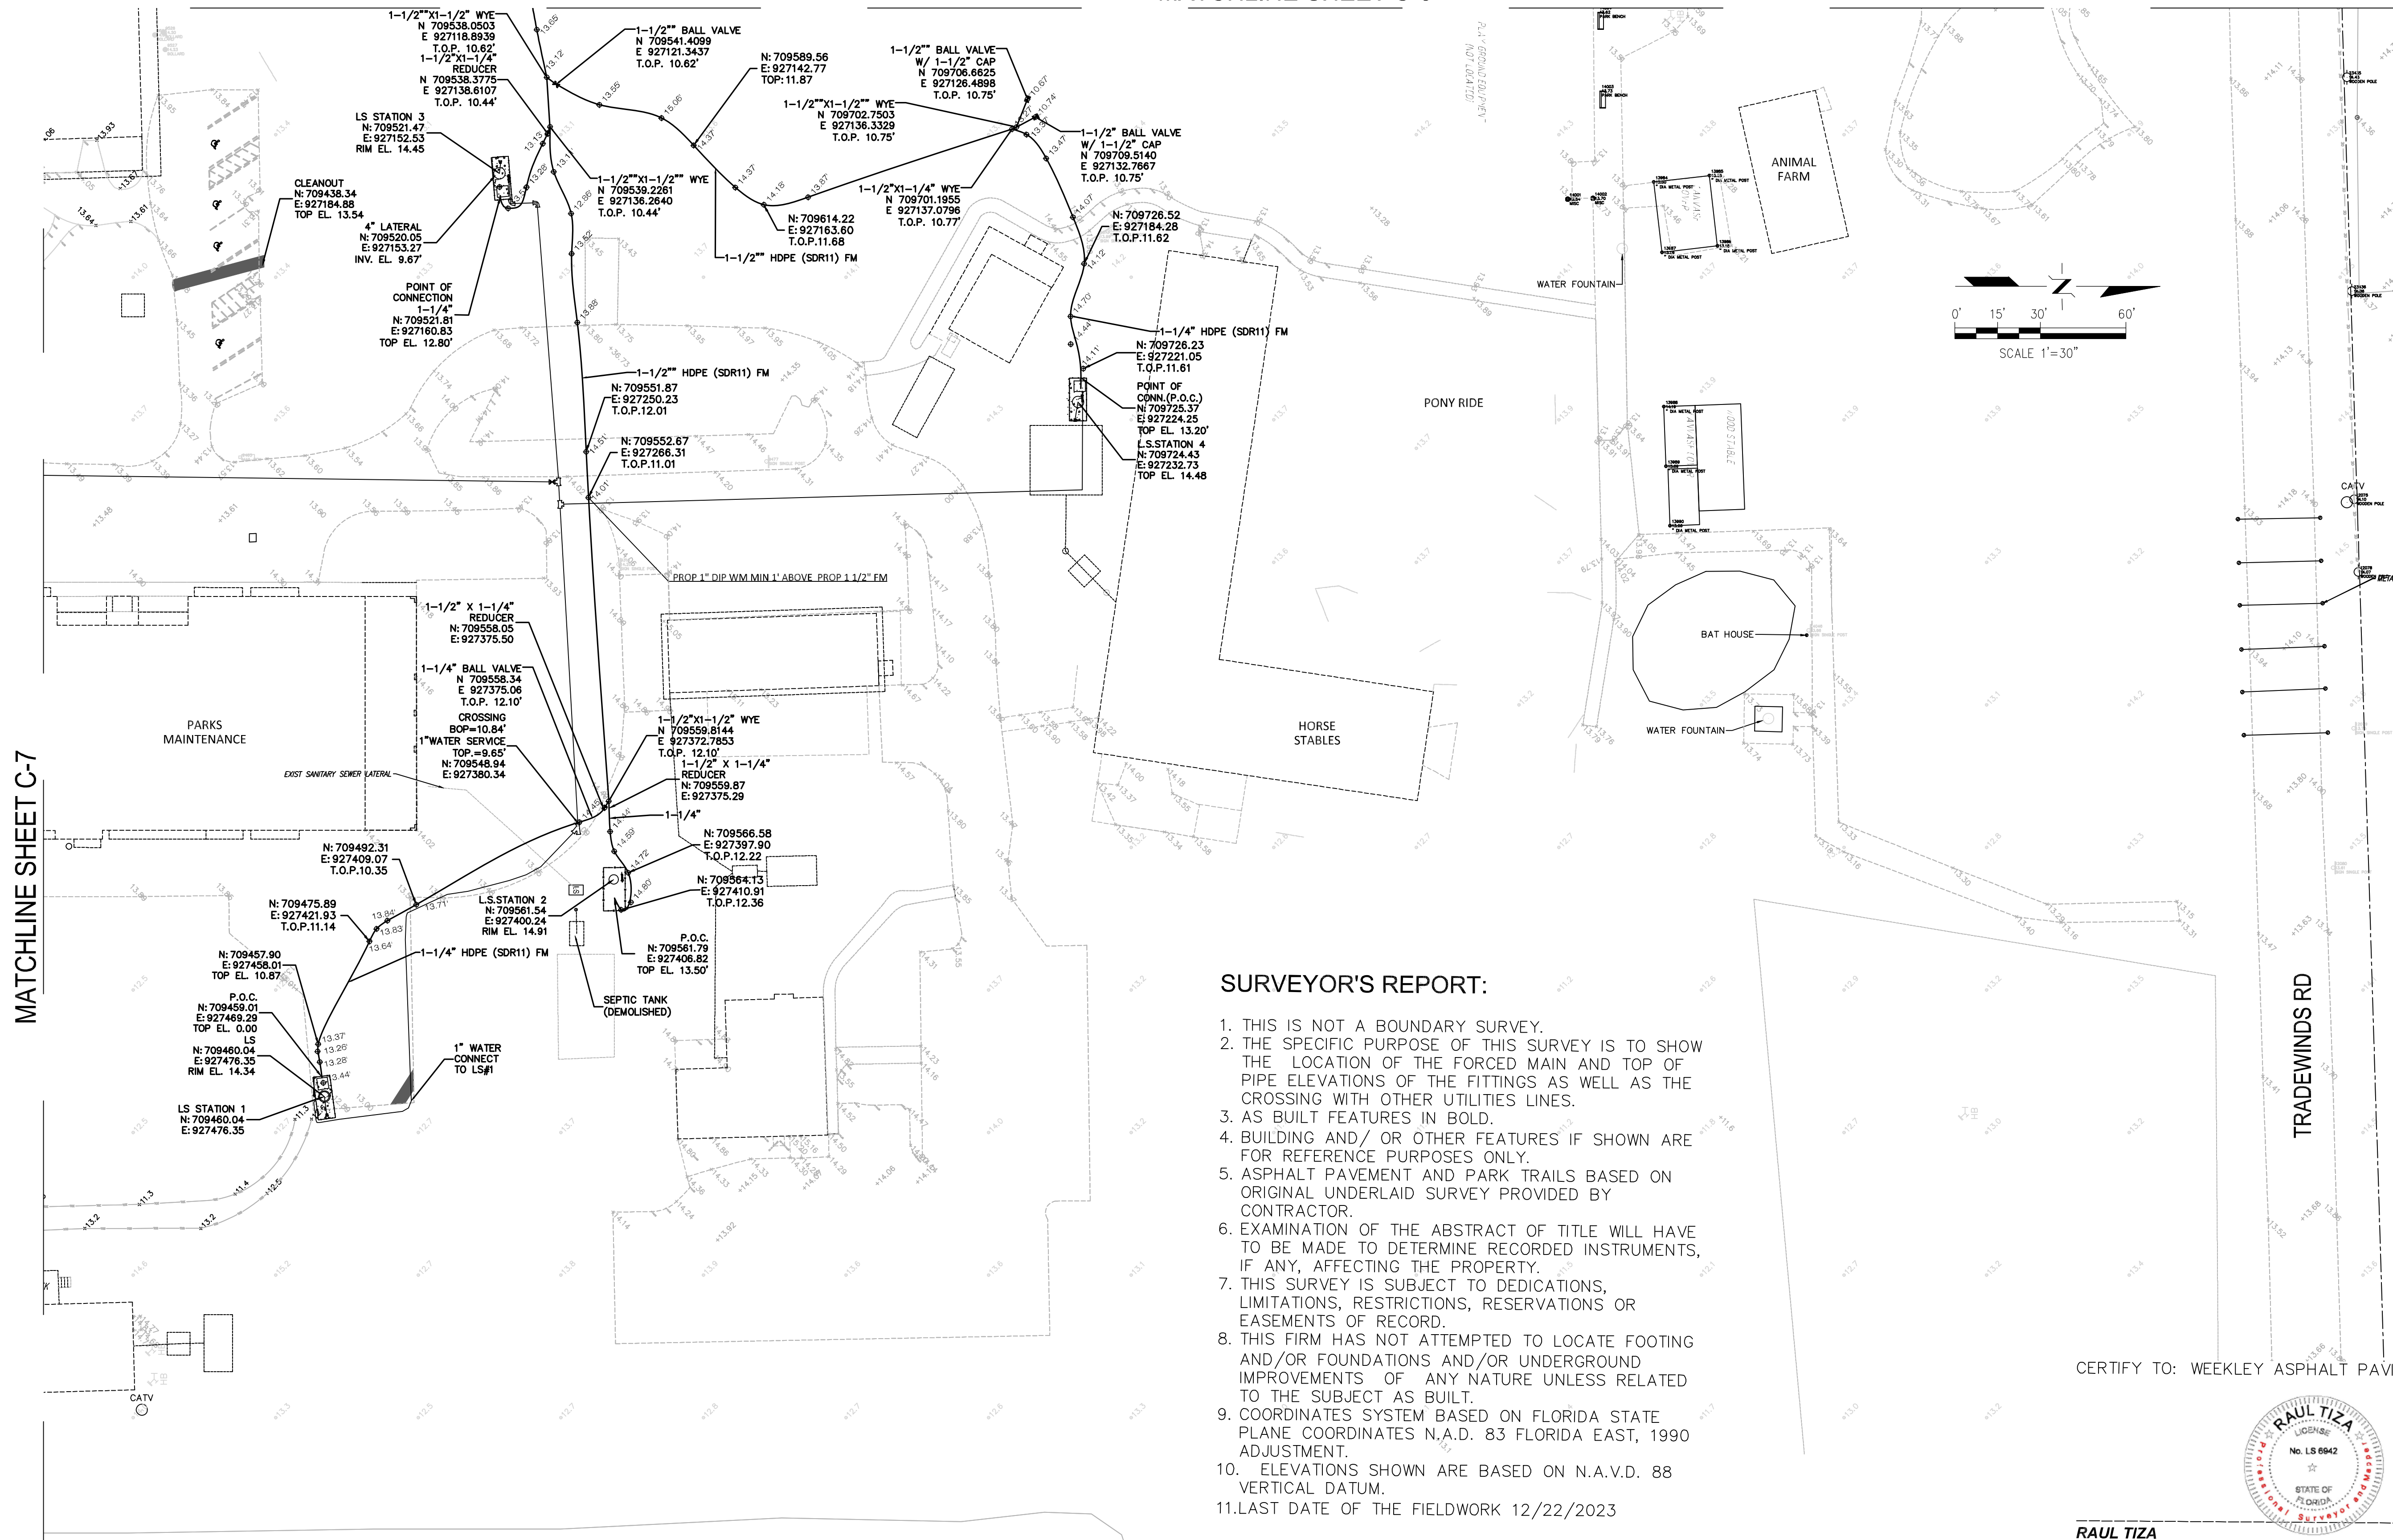

AS BUILT PLANS
SHEET C-4

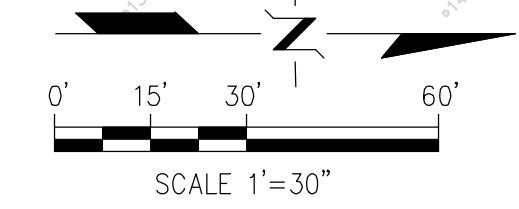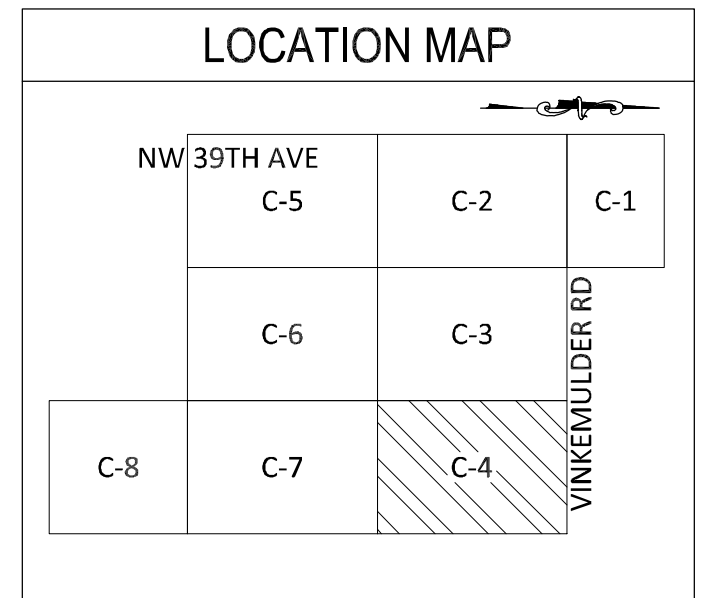


MATCHLINE SHEET C-7

SURVEYOR'S REPORT:

1. THIS IS NOT A BOUNDARY SURVEY.
2. THE SPECIFIC PURPOSE OF THIS SURVEY IS TO SHOW THE LOCATION OF THE FORCED MAIN AND TOP OF PIPE ELEVATIONS OF THE FITTINGS AS WELL AS THE CROSSING WITH OTHER UTILITIES LINES.
3. AS BUILT FEATURES IN BOLD.
4. BUILDING AND/ OR OTHER FEATURES IF SHOWN ARE FOR REFERENCE PURPOSES ONLY.
5. ASPHALT PAVEMENT AND PARK TRAILS BASED ON ORIGINAL UNDERLAID SURVEY PROVIDED BY CONTRACTOR.
6. EXAMINATION OF THE ABSTRACT OF TITLE WILL HAVE TO BE MADE TO DETERMINE RECORDED INSTRUMENTS, IF ANY, AFFECTING THE PROPERTY.
7. THIS SURVEY IS SUBJECT TO DEDICATIONS, LIMITATIONS, RESTRICTIONS, RESERVATIONS OR EASEMENTS OF RECORD.
8. THIS FIRM HAS NOT ATTEMPTED TO LOCATE FOOTING AND/OR FOUNDATIONS AND/OR UNDERGROUND IMPROVEMENTS OF ANY NATURE UNLESS RELATED TO THE SUBJECT AS BUILT.
9. COORDINATES SYSTEM BASED ON FLORIDA STATE PLANE COORDINATES N.A.D. 83 FLORIDA EAST, 1990 ADJUSTMENT.
10. ELEVATIONS SHOWN ARE BASED ON N.A.V.D. 88 VERTICAL DATUM.
11. LAST DATE OF THE FIELDWORK 12/22/2023

CERTIFY TO: WEEKLEY ASPHALT PAVING, INC.

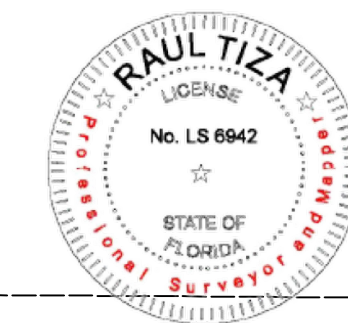

RAUL TIZA
LAND SURVEYOR AND MAPPER No. 6942, LB 8029.
STATE OF FLORIDA
18761 SW 291st TERRACE MIAMI FLORIDA 33030
PHONE: 786-975-8588


NOT VALID WITHOUT THE SIGNATURE AND THE ELECTRONIC SEAL OF A FLORIDA LICENSED SURVEYOR AND MAPPER

LEGEND	
BOP	BOTTOM OF PIPE
BOT	BOTTOM
BSP	BACTERIAL SAMPLING POINT
BU	BUBBLE UP STRUCTURE
CB	CATCH BASIN
CE	CONTROL ELEVATION
CLEAR	CLEARANCE
CMH	CONFLICT MANHOLE
CMF	CORRUGATED METAL PIPE
CONC	CONCRETE
CS	CONTROL STRUCTURE
DDCV	DOUBLE DETECTOR CHECK VALVE
DIP	DUCTILE IRON PIPE
DR	DRAINAGE
ELEV	ELEVATION
EXIST	EXISTING
FDC	FIRE DEPARTMENT CONNECTION
FFE	FINISHED FLOOR ELEVATION
FH	FIRE HYDRANT
FT	FEET
GV	GATE VALVE
GRD	FINISH GRADE
HDPE	HIGH DENSITY POLYETHYLENE
HW	HEADWALL
IE	INVERT ELEVATION
INV	INVERT OF PIPE
LF	LINEAR FEET
MAS	MAINTENANCE ACCESS STRUCTURE
NAVD	NORTH AMERICAN VERTICAL DATUM
OUT	OUTFALL
±	PROPERTY LINE
PVC	POLYVINYL CHLORIDE PIPE
PROP	PROPOSED
RE	RIM ELEVATION
RIM	RIM OF STRUCTURE
RCP	REINFORCED CONCRETE PIPE
RPZ	REDUCED PRESSURE ZONE BACKFLOW PREVENTER
R/W	RIGHT OF WAY
STR	STRUCTURE
TOP	TOP OF PIPE
TYP	TYPICAL
WM	WATER MAIN
W/	WITH
YD	YARD DRAIN
	EXIST GRADE (FT-NAVD)
	PROP GRADE (FT-NAVD)
	ASPHALT PAVEMENT
	TO BE REMOVED CONFLICT MARKER
	TO BE REMOVED CHAIN LINK FENCE
	DECORATIVE FENCE
	PROPERTY LINE
	EASEMENT LINE
	R/W LINE



SPECIFIC PURPOSE SURVEY

PROJECT No. R1423108P1
H.D.P.E FORCE MAIN

AS BUILT DRAWING TRADEWINDS PARK UTILITIES IMPROVEMENT BROWARD COUNTY PARKS AND RECREATION

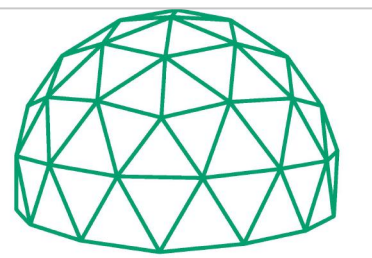

RT GEOSOLUTIONS
A LAND SURVEYING COMPANY

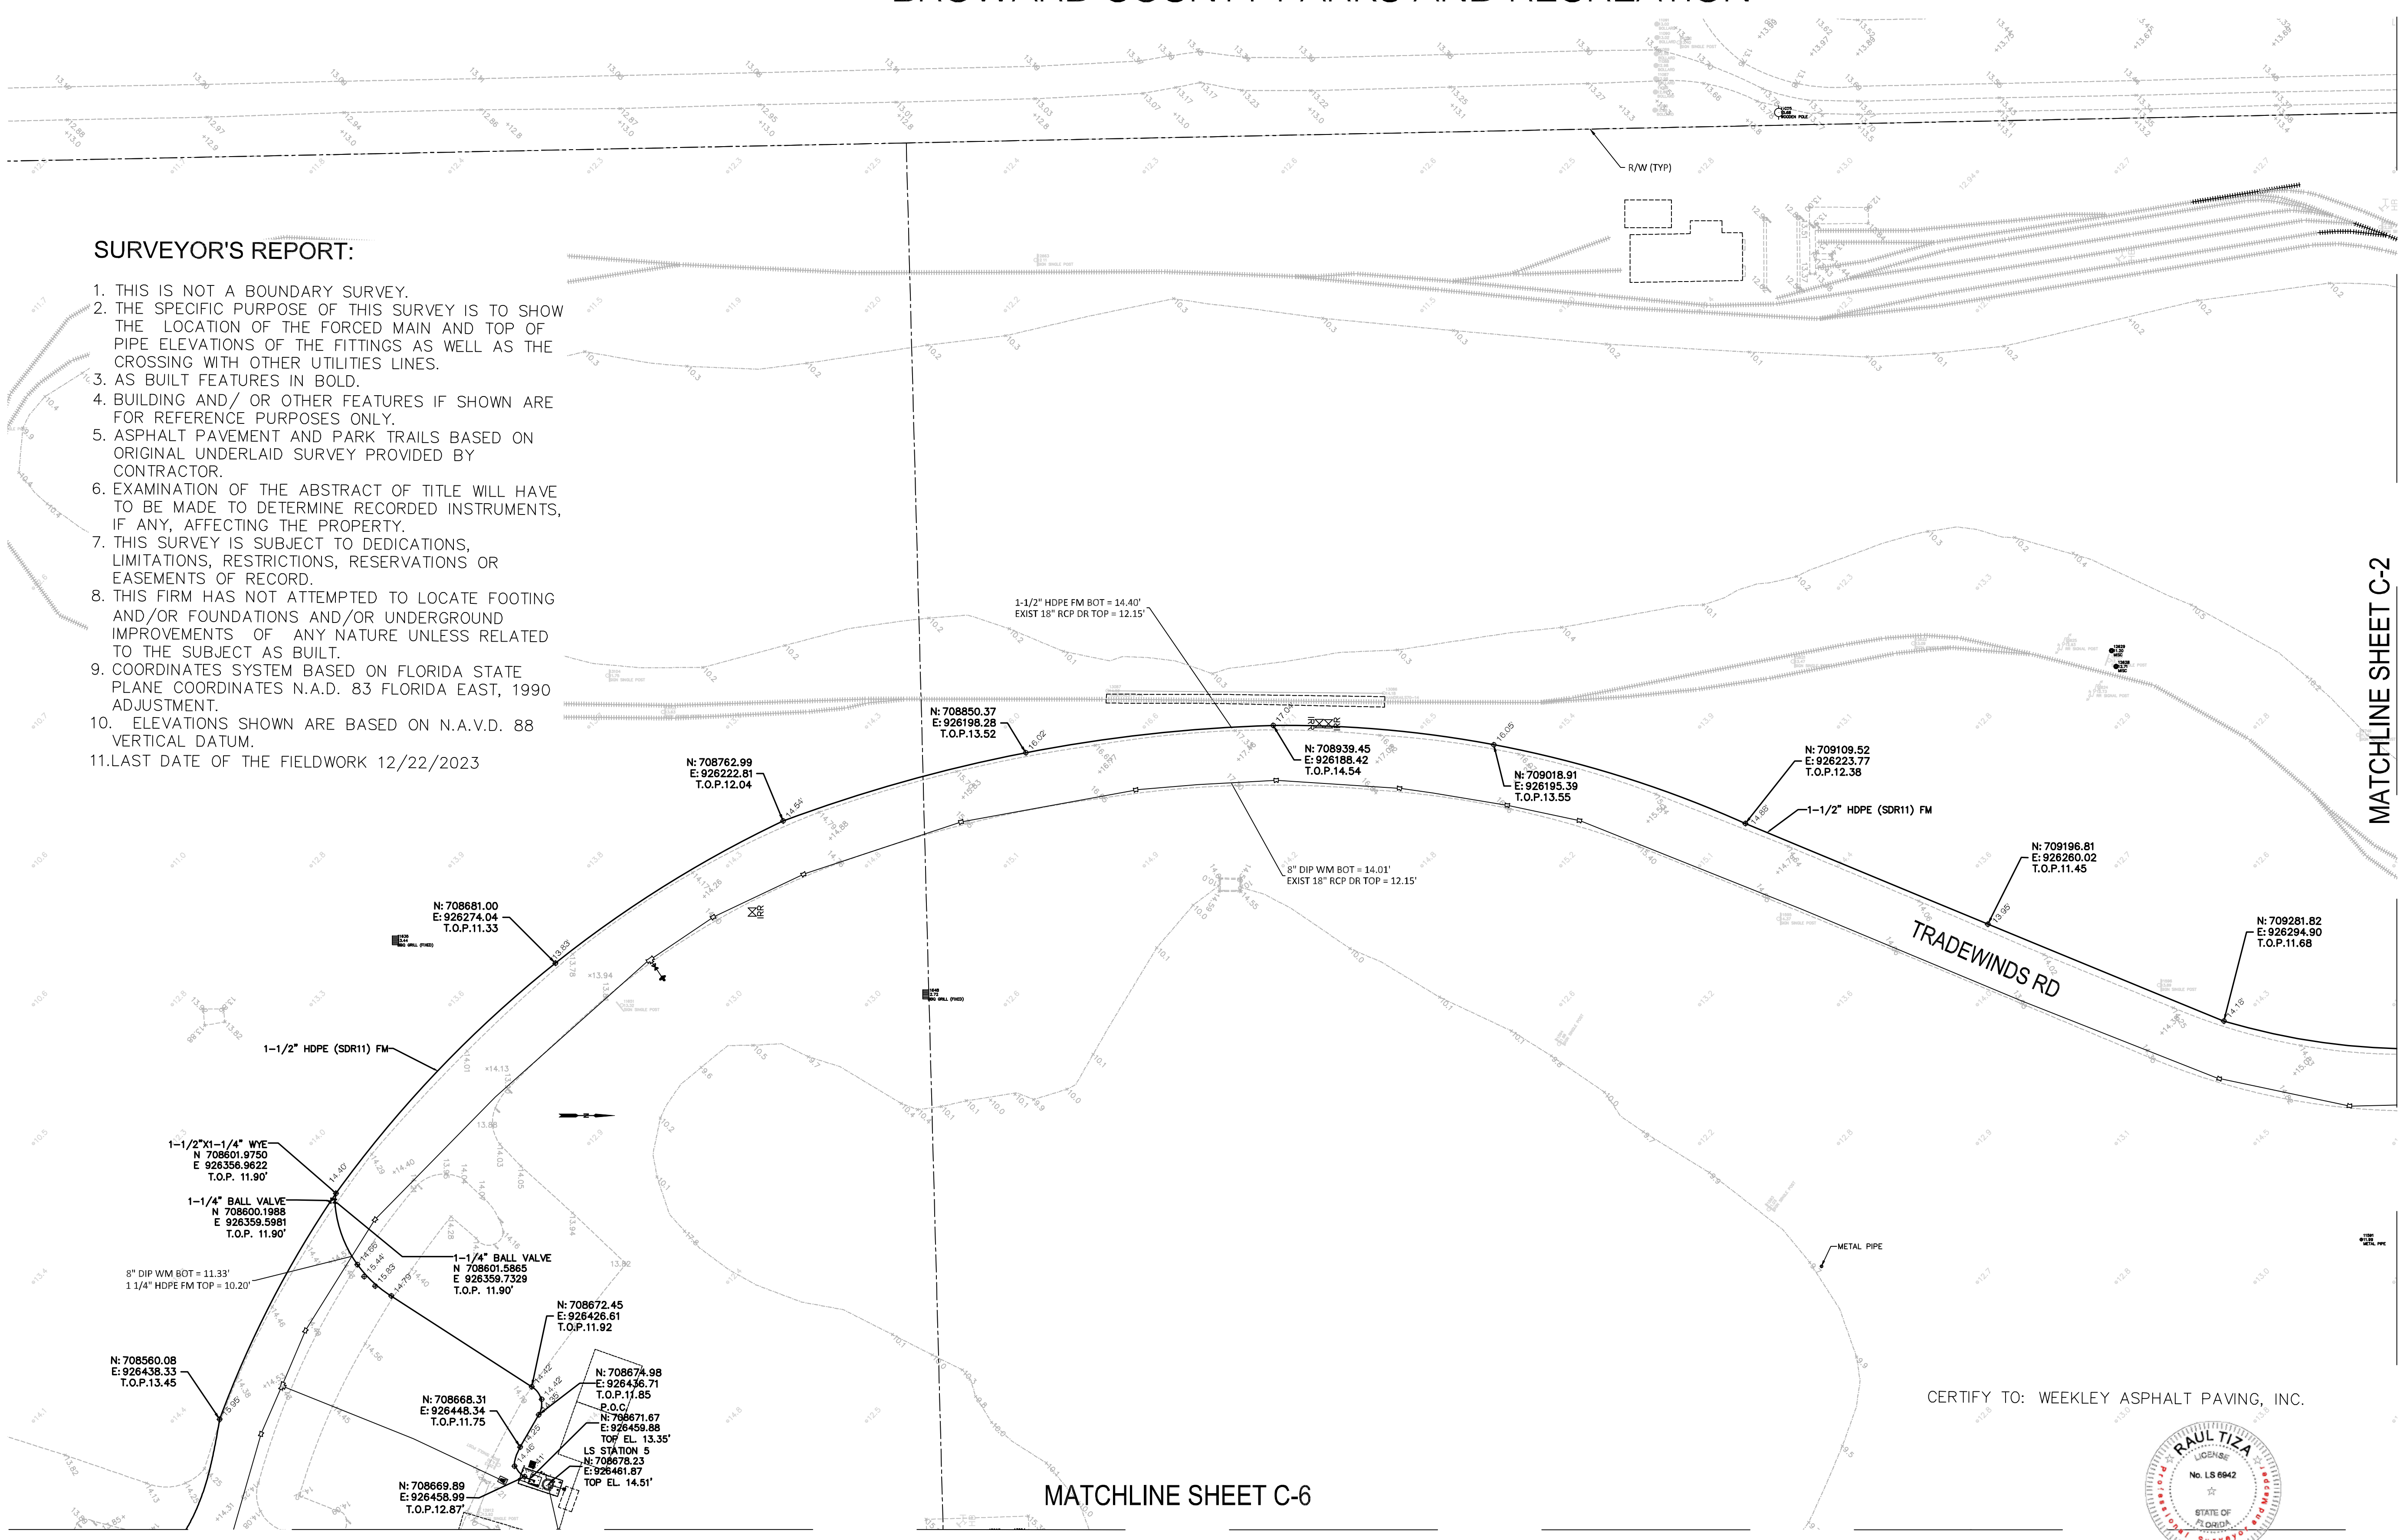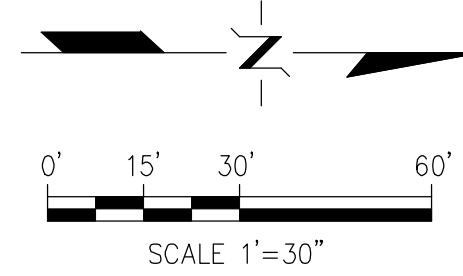


SURVEYOR'S REPORT:

1. THIS IS NOT A BOUNDARY SURVEY.
2. THE SPECIFIC PURPOSE OF THIS SURVEY IS TO SHOW THE LOCATION OF THE FORCED MAIN AND TOP OF PIPE ELEVATIONS OF THE FITTINGS AS WELL AS THE CROSSING WITH OTHER UTILITIES LINES.
3. AS BUILT FEATURES IN BOLD.
4. BUILDING AND/ OR OTHER FEATURES IF SHOWN ARE FOR REFERENCE PURPOSES ONLY.
5. ASPHALT PAVEMENT AND PARK TRAILS BASED ON ORIGINAL UNDERLAID SURVEY PROVIDED BY CONTRACTOR.
6. EXAMINATION OF THE ABSTRACT OF TITLE WILL HAVE TO BE MADE TO DETERMINE RECORDED INSTRUMENTS, IF ANY, AFFECTING THE PROPERTY.
7. THIS SURVEY IS SUBJECT TO DEDICATIONS, LIMITATIONS, RESTRICTIONS, RESERVATIONS OR EASEMENTS OF RECORD.
8. THIS FIRM HAS NOT ATTEMPTED TO LOCATE FOOTING AND/OR FOUNDATIONS AND/OR UNDERGROUND IMPROVEMENTS OF ANY NATURE UNLESS RELATED TO THE SUBJECT AS BUILT.
9. COORDINATES SYSTEM BASED ON FLORIDA STATE PLANE COORDINATES N.A.D. 83 FLORIDA EAST, 1990 ADJUSTMENT.
10. ELEVATIONS SHOWN ARE BASED ON N.A.V.D. 88 VERTICAL DATUM.
11. LAST DATE OF THE FIELDWORK 12/22/2023

AS BUILT PLANS
SHEET C-5

LOCATION MAP

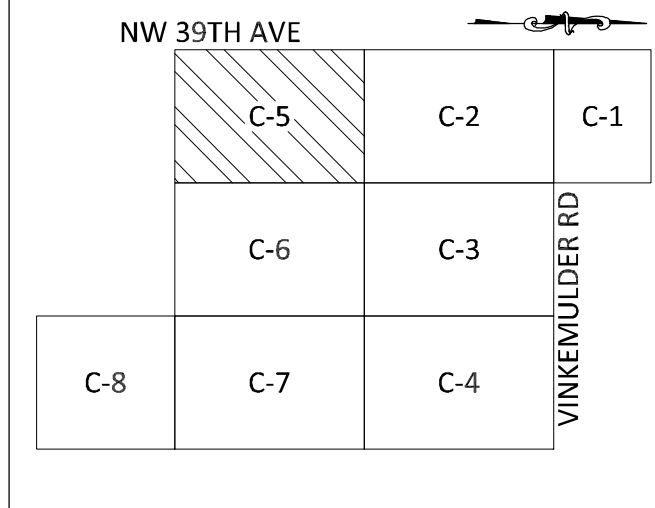


LEGEND

BOP	BOTTOM OF PIPE
BSP	BACTERIAL SAMPLING POINT
BU	BUBBLE UP STRUCTURE
CB	CATCH BASIN
CE	CONTROL ELEVATION
CLEAR	CLEARANCE
CMH	CONFLICT MANHOLE
CMF	CORRUGATED METAL PIPE
CONC	CONCRETE
CS	CONTROL STRUCTURE
DDCV	DOUBLE DETECTOR CHECK VALVE
DIP	DUCTILE IRON PIPE
DR	DRAINAGE
ELEV	ELEVATION
EXIST	EXISTING
FOC	FIRE DEPARTMENT CONNECTION
FFE	FINISHED FLOOR ELEVATION
FH	FIRE HYDRANT
FT	FEET
GV	GATE VALVE
GRD	FINISH GRADE
HDPE	HIGH DENSITY POLYETHYLENE
HW	HEADWALL
IE	INVERT ELEVATION
INV	INVERT OF PIPE
LF	LINEAR FEET
MAS	MAINTENANCE ACCESS STRUCTURE
NAVD	NORTH AMERICAN VERTICAL DATUM
OUT	OUTFALL
PL	PROPERTY LINE
PVC	POLYVINYL CHLORIDE PIPE
PROP	PROPOSED
RE	RIM ELEVATION
RIM	RIM OF STRUCTURE
RCP	REINFORCED CONCRETE PIPE
RPZ	REDUCED PRESSURE ZONE BACKFLOW PREVENTER
R/W	RIGHT OF WAY
STR	STRUCTURE
TOP	TOP OF PIPE
TYP	TYPICAL
WM	WATER MAIN
W/	WITH
YD	YARD DRAIN

	EXIST GRADE (FT-NAVD)
	PROP GRADE (FT-NAVD)
	ASPHALT PAVEMENT
	TO BE REMOVED CONFLICT MARKER
	TO BE REMOVED CHAIN LINK FENCE
	TO BE REMOVED DECORATIVE FENCE
	PROPERTY LINE
	EASEMENT LINE
	R/W LINE

CERTIFY TO: WEEKLEY ASPHALT PAVING, INC.

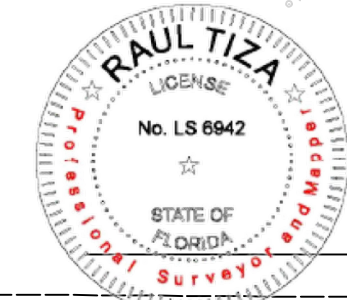


RAUL TIZA
LAND SURVEYOR AND MAPPER No. 6942, LB 8029.
STATE OF FLORIDA
18761 SW 291st TERRACE MIAMI FLORIDA 33030
PHONE: 786-975-8588

NOT VALID WITHOUT THE SIGNATURE AND THE ELECTRONIC SEAL OF A FLORIDA LICENSED SURVEYOR AND MAPPER

SPECIFIC PURPOSE SURVEY


AS BUILT DRAWING TRADEWINDS PARK UTILITIES IMPROVEMENT BROWARD COUNTY PARKS AND RECREATION PROJECT No. R1423108P1 H.D.P.E FORCE MAIN

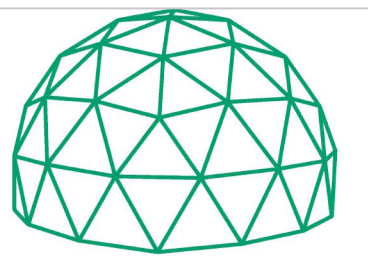

RT GEOSOLUTIONS
A LAND SURVEYING COMPANY

AS BUILT PLANS
SHEET C-6

LOCATION MAP

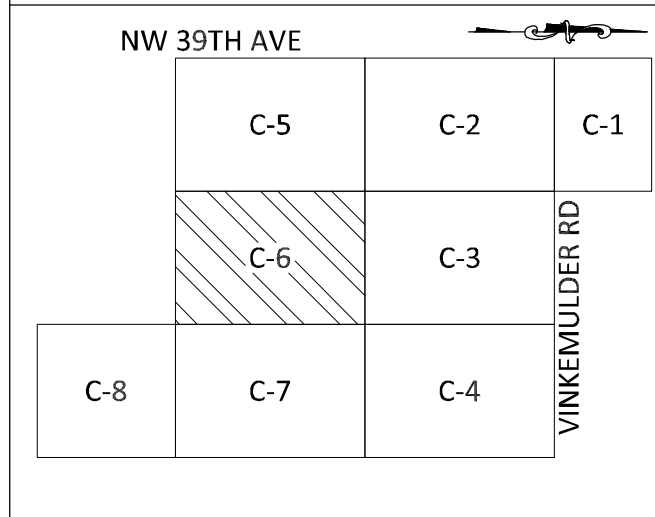

MATCHLINE SHEET C-3

SURVEYOR'S REPORT:


1. THIS IS NOT A BOUNDARY SURVEY.
2. THE SPECIFIC PURPOSE OF THIS SURVEY IS TO SHOW THE LOCATION OF THE FORCED MAIN AND TOP OF PIPE ELEVATIONS OF THE FITTINGS AS WELL AS THE CROSSING WITH OTHER UTILITIES LINES.
3. AS BUILT FEATURES IN BOLD.
4. BUILDING AND/ OR OTHER FEATURES IF SHOWN ARE FOR REFERENCE PURPOSES ONLY.
5. ASPHALT PAVEMENT AND PARK TRAILS BASED ON ORIGINAL UNDERLAID SURVEY PROVIDED BY CONTRACTOR.
6. EXAMINATION OF THE ABSTRACT OF TITLE WILL HAVE TO BE MADE TO DETERMINE RECORDED INSTRUMENTS, IF ANY, AFFECTING THE PROPERTY.
7. THIS SURVEY IS SUBJECT TO DEDICATIONS, LIMITATIONS, RESTRICTIONS, RESERVATIONS OR EASEMENTS OF RECORD.
8. THIS FIRM HAS NOT ATTEMPTED TO LOCATE FOOTING AND/OR FOUNDATIONS AND/OR UNDERGROUND IMPROVEMENTS OF ANY NATURE UNLESS RELATED TO THE SUBJECT AS BUILT.
9. COORDINATES SYSTEM BASED ON FLORIDA STATE PLANE COORDINATES N.A.D. 83 FLORIDA EAST, 1990 ADJUSTMENT.
10. ELEVATIONS SHOWN ARE BASED ON N.A.V.D. 88 VERTICAL DATUM.
11. LAST DATE OF THE FIELDWORK 12/22/2023

LEGEND

BOP	BOTTOM OF PIPE
BOT	BOTTOM
BSP	BACTERIAL SAMPLING POINT
BU	BUBBLE UP STRUCTURE
CB	CATCH BASIN
CE	CONTROL ELEVATION
CLEAR	CLEARANCE
CMH	CONFLICT MANHOLE
CMF	CORRUGATED METAL PIPE
CMC	CONCRETE
CS	CONTROL STRUCTURE
DDCV	DOUBLE DETECTOR CHECK VALVE
DIP	DUCTILE IRON PIPE
DR	DRAINAGE
ELEV	ELEVATION
EXIST	EXISTING
FDC	FIRE DEPARTMENT CONNECTION
FFE	FINISHED FLOOR ELEVATION
FH	FIRE HYDRANT
FT	FEET
GV	GATE VALVE
GRD	FINISH GRADE
HDPE	HIGH DENSITY POLYETHYLENE
HW	HEADWALL
IE	INVERT ELEVATION
INV	INVERT OF PIPE
LF	LINEAR FEET
MAS	MAINTENANCE ACCESS STRUCTURE
NAVD	NORTH AMERICAN VERTICAL DATUM
OUT	OUTFALL
PL	PROPERTY LINE
PVC	POLYVINYL CHLORIDE PIPE
PROP	PROPOSED
RE	RIM ELEVATION
RIM	RIM OF STRUCTURE
RCP	REINFORCED CONCRETE PIPE
RPZ	REDUCED PRESSURE ZONE BACKFLOW PREVENTER
R/W	RIGHT OF WAY
STR	STRUCTURE
TOP	TOP OF PIPE
TYP	TYPICAL
WM	WATER MAIN
W/	WITH
YD	YARD DRAIN
	EXIST GRADE (FT-NAVD)
	PROP GRADE (FT-NAVD)
	ASPHALT PAVEMENT
	TO BE REMOVED CONFLICT MARKER
	TO BE REMOVED
	CHAIN LINK FENCE
	DECORATIVE FENCE
	PROPERTY LINE
	EASEMENT LINE
	R/W LINE


CERTIFY TO: WEEKLEY ASPHALT PAVING, INC.

EQUINE-ASSISTED THERAPIES

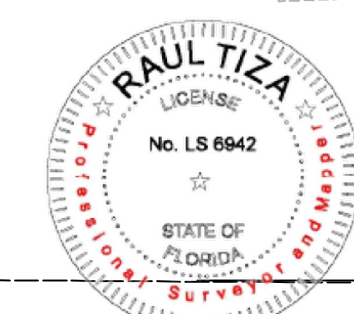



RAUL TIZA
LAND SURVEYOR AND MAPPER No. 6942, LB 8029.
STATE OF FLORIDA
18761 SW 291st TERRACE MIAMI FLORIDA 33030
PHONE: 786-975-8588

NOT VALID WITHOUT THE SIGNATURE AND THE ELECTRONIC SEAL OF A FLORIDA LICENSED SURVEYOR AND MAPPER

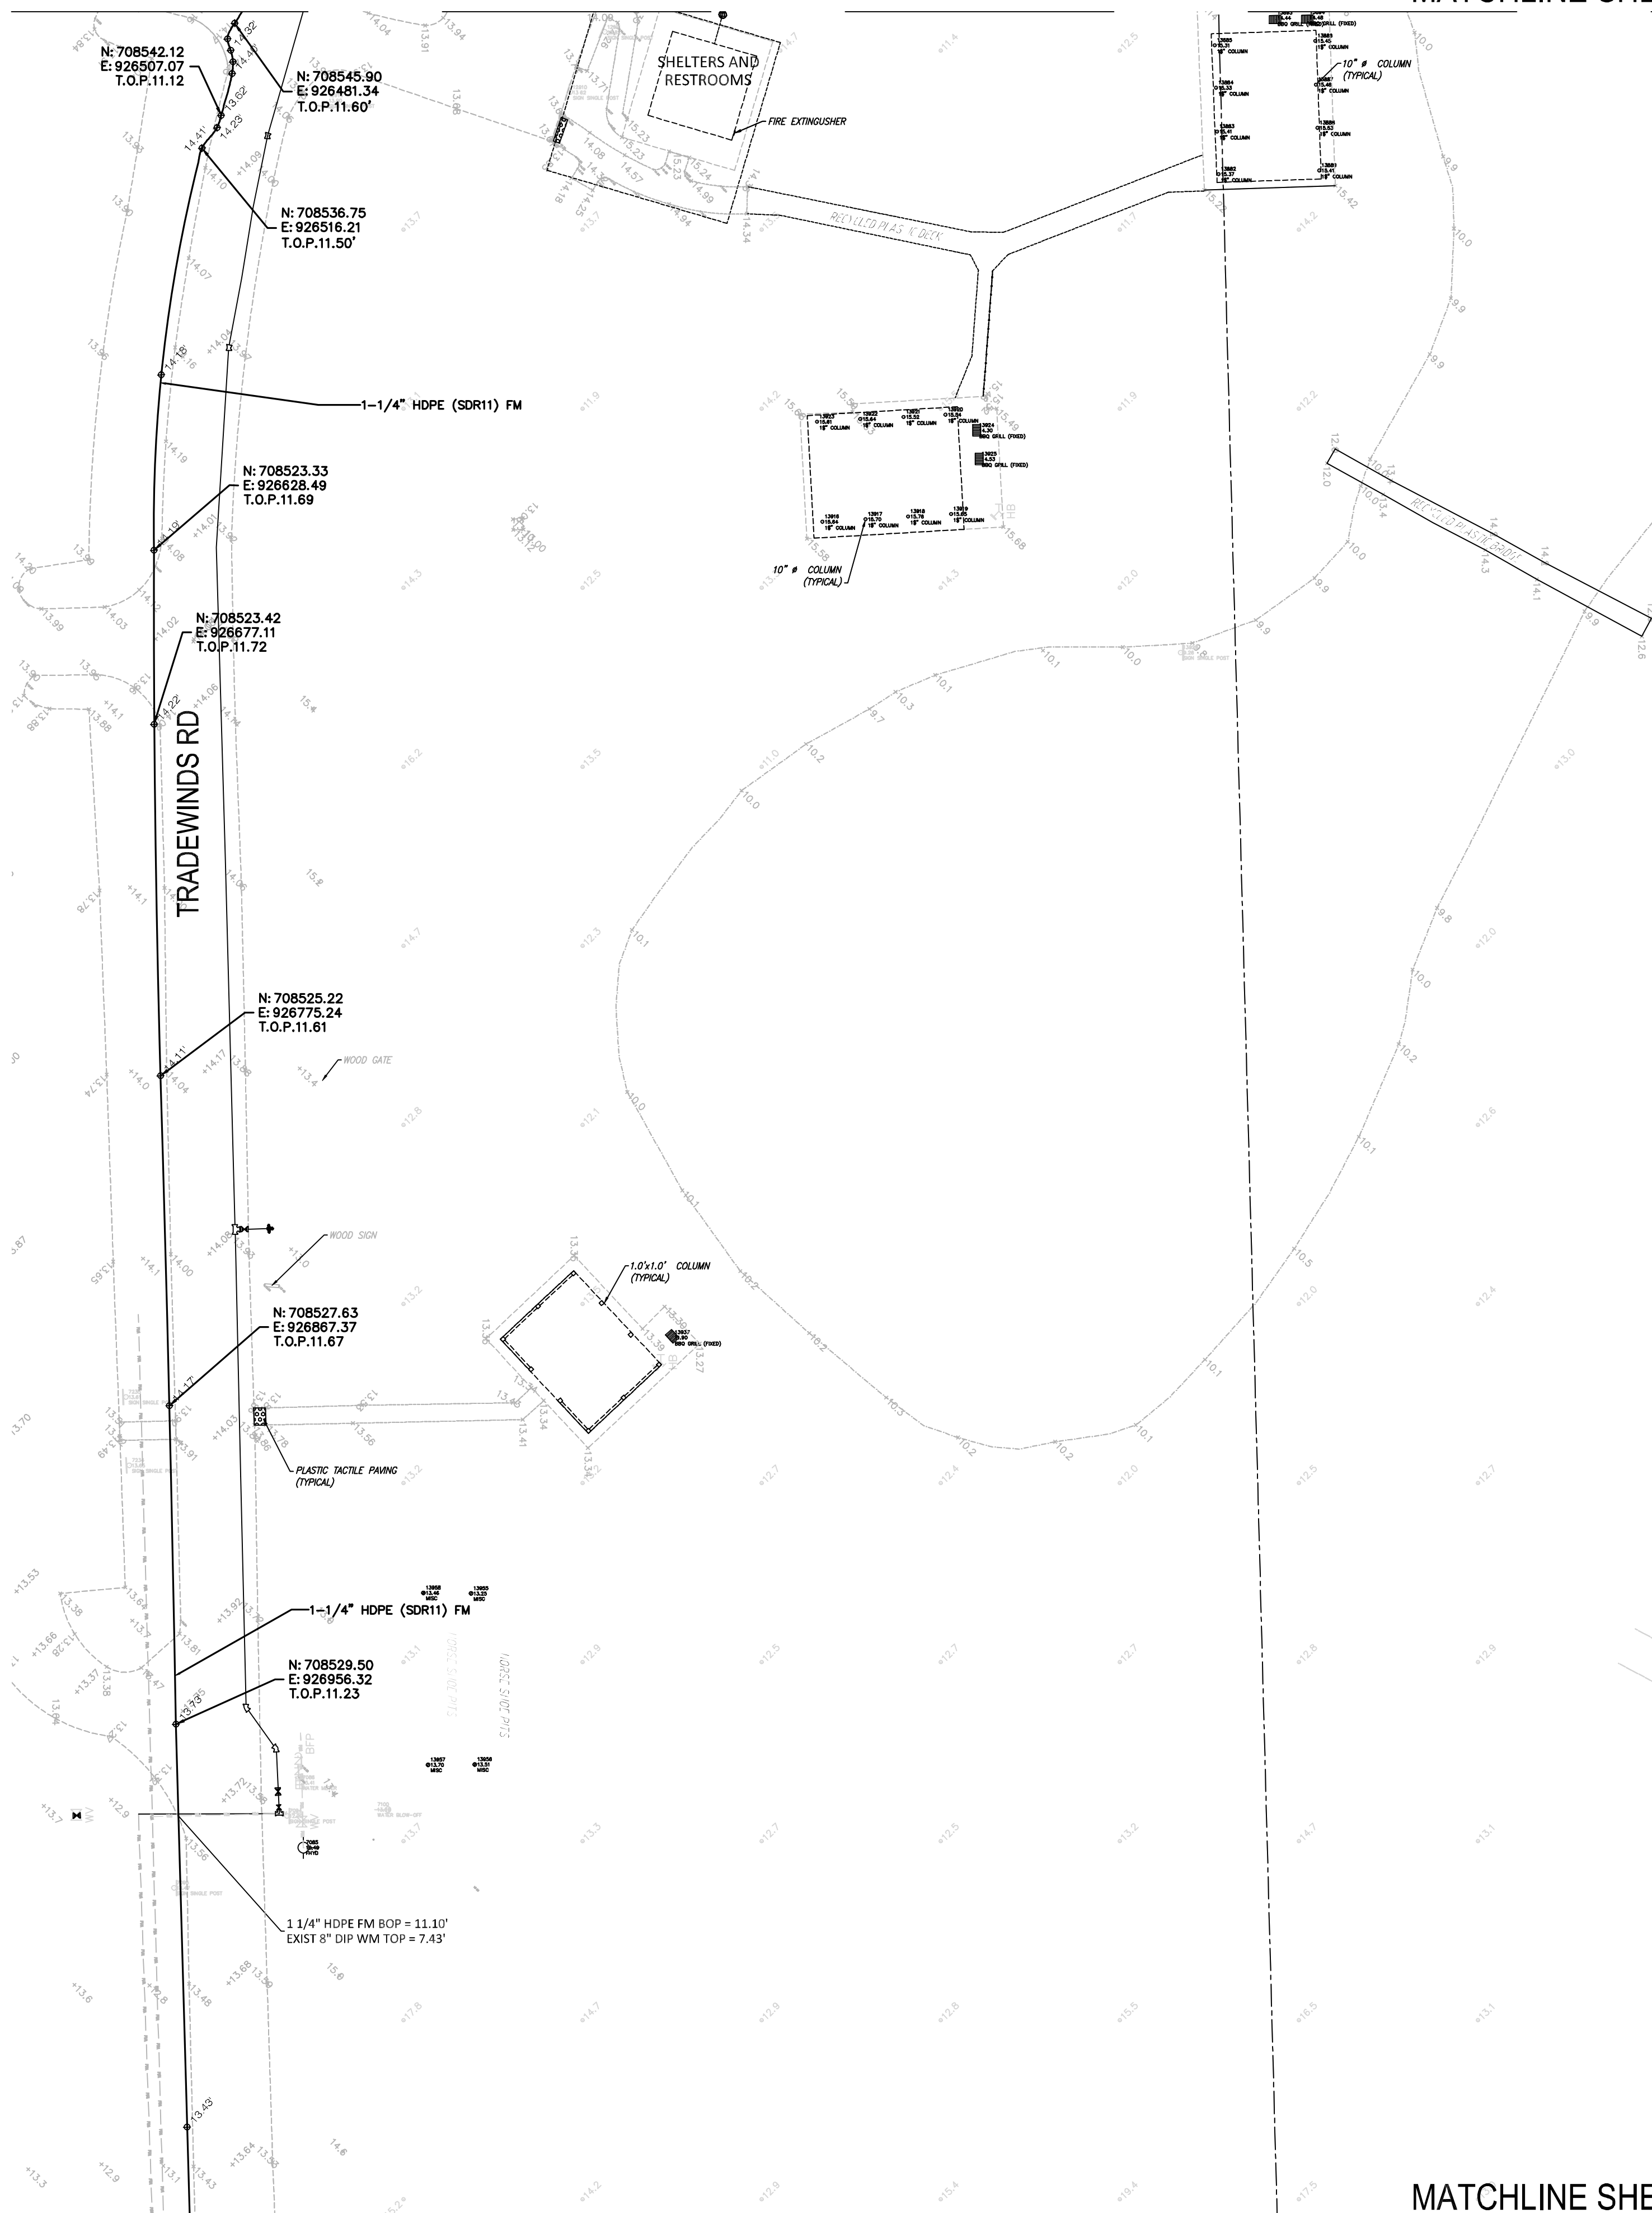

SPECIFIC PURPOSE SURVEY


AS BUILT DRAWING
 TRADEWINDS PARK UTILITIES IMPROVEMENT
 BROWARD COUNTY PARKS AND RECREATION
 PROJECT No. R1423108P1
 H.D.P.E FORCE MAIN

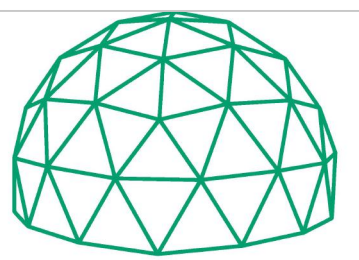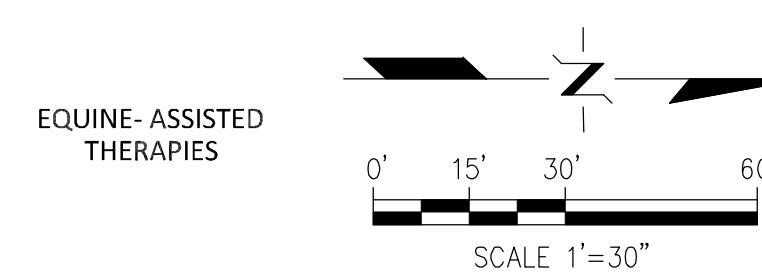

RT GEOSOLUTIONS
 A LAND SURVEYING COMPANY


AS BUILT PLANS
 SHEET C-7

LOCATION MAP

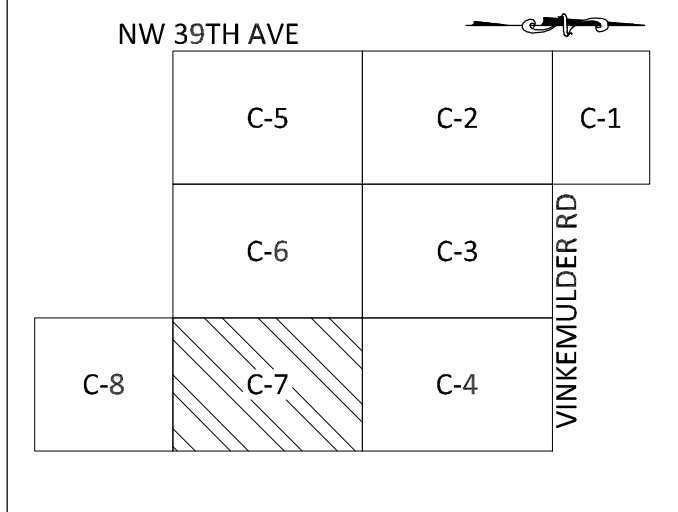


LEGEND

BOP	BOTTOM OF PIPE
BOT	BOTTOM
BSP	BACTERIAL SAMPLING POINT
BU	BUBBLE UP STRUCTURE
CB	CATCH BASIN
CE	CONTROL ELEVATION
CLEAR	CLEARANCE
CMH	CONFLICT MANHOLE
CMF	CORRUGATED METAL PIPE
CONC	CONCRETE
CS	CONTROL STRUCTURE
DDCV	DOUBLE DETECTOR CHECK VALVE
DIP	DUCTILE IRON PIPE
DR	DRAINAGE
ELEV	ELEVATION
EXIST	EXISTING
FDC	FIRE DEPARTMENT CONNECTION
FFE	FINISHED FLOOR ELEVATION
FH	FIRE HYDRANT
FT	FEET
GV	GATE VALVE
GRD	FINISH GRADE
HDPE	HIGH DENSITY POLYETHYLENE
HW	HEADWALL
IE	INVERT ELEVATION
INV	INVERT OF PIPE
LF	LINEAR FEET
MAS	MAINTENANCE ACCESS STRUCTURE
NAVD	NORTH AMERICAN VERTICAL DATUM
OUT	OUTFALL
±	PROPERTY LINE
PVC	POLYVINYL CHLORIDE PIPE
PROP	PROPOSED
RE	RIM ELEVATION
RIM	RIM OF STRUCTURE
RCP	REINFORCED CONCRETE PIPE
RPZ	REDUCED PRESSURE ZONE BACKFLOW PREVENTER
R/W	RIGHT OF WAY
STR	STRUCTURE
TOP	TOP OF PIPE
TYP	TYPICAL
WM	WATER MAIN
W/	WITH
YD	YARD DRAIN

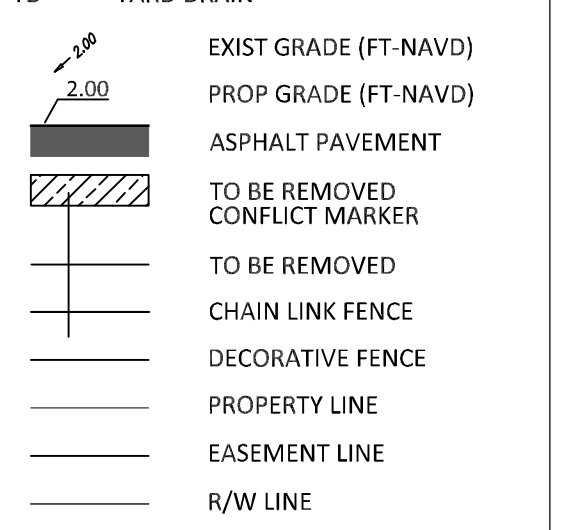

CERTIFY TO: WEEKLEY ASPHALT PAVING, INC.

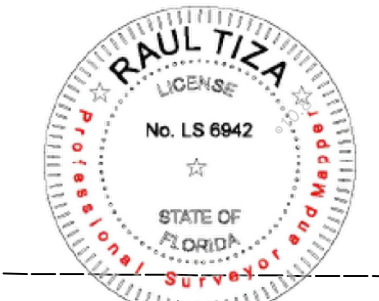

RAUL TIZA
 LAND SURVEYOR AND MAPPER No. 6942, LB 8029.
 STATE OF FLORIDA
 18761 SW 291st TERRACE MIAMI FLORIDA 33030
 PHONE: 786-975-8588


NOT VALID WITHOUT THE SIGNATURE AND THE ELECTRONIC SEAL OF A FLORIDA LICENSED SURVEYOR AND MAPPER

SURVEYOR'S REPORT:

1. THIS IS NOT A BOUNDARY SURVEY.
2. THE SPECIFIC PURPOSE OF THIS SURVEY IS TO SHOW THE LOCATION OF THE FORCED MAIN AND TOP OF PIPE ELEVATIONS OF THE FITTINGS AS WELL AS THE CROSSING WITH OTHER UTILITIES LINES.
3. AS BUILT FEATURES IN BOLD.
4. BUILDING AND/ OR OTHER FEATURES IF SHOWN ARE FOR REFERENCE PURPOSES ONLY.
5. ASPHALT PAVEMENT AND PARK TRAILS BASED ON ORIGINAL UNDERLAID SURVEY PROVIDED BY CONTRACTOR.
6. EXAMINATION OF THE ABSTRACT OF TITLE WILL HAVE TO BE MADE TO DETERMINE RECORDED INSTRUMENTS, IF ANY, AFFECTING THE PROPERTY.
7. THIS SURVEY IS SUBJECT TO DEDICATIONS, LIMITATIONS, RESTRICTIONS, RESERVATIONS OR EASEMENTS OF RECORD.
8. THIS FIRM HAS NOT ATTEMPTED TO LOCATE FOOTING AND/OR FOUNDATIONS AND/OR UNDERGROUND IMPROVEMENTS OF ANY NATURE UNLESS RELATED TO THE SUBJECT AS BUILT.
9. COORDINATES SYSTEM BASED ON FLORIDA STATE PLANE COORDINATES N.A.D. 83 FLORIDA EAST, 1990 ADJUSTMENT.
10. ELEVATIONS SHOWN ARE BASED ON N.A.V.D. 88 VERTICAL DATUM.
11. LAST DATE OF THE FIELDWORK 12/22/2023

MATCHLINE SHEET C-8


MATCHLINE SHEET C-7

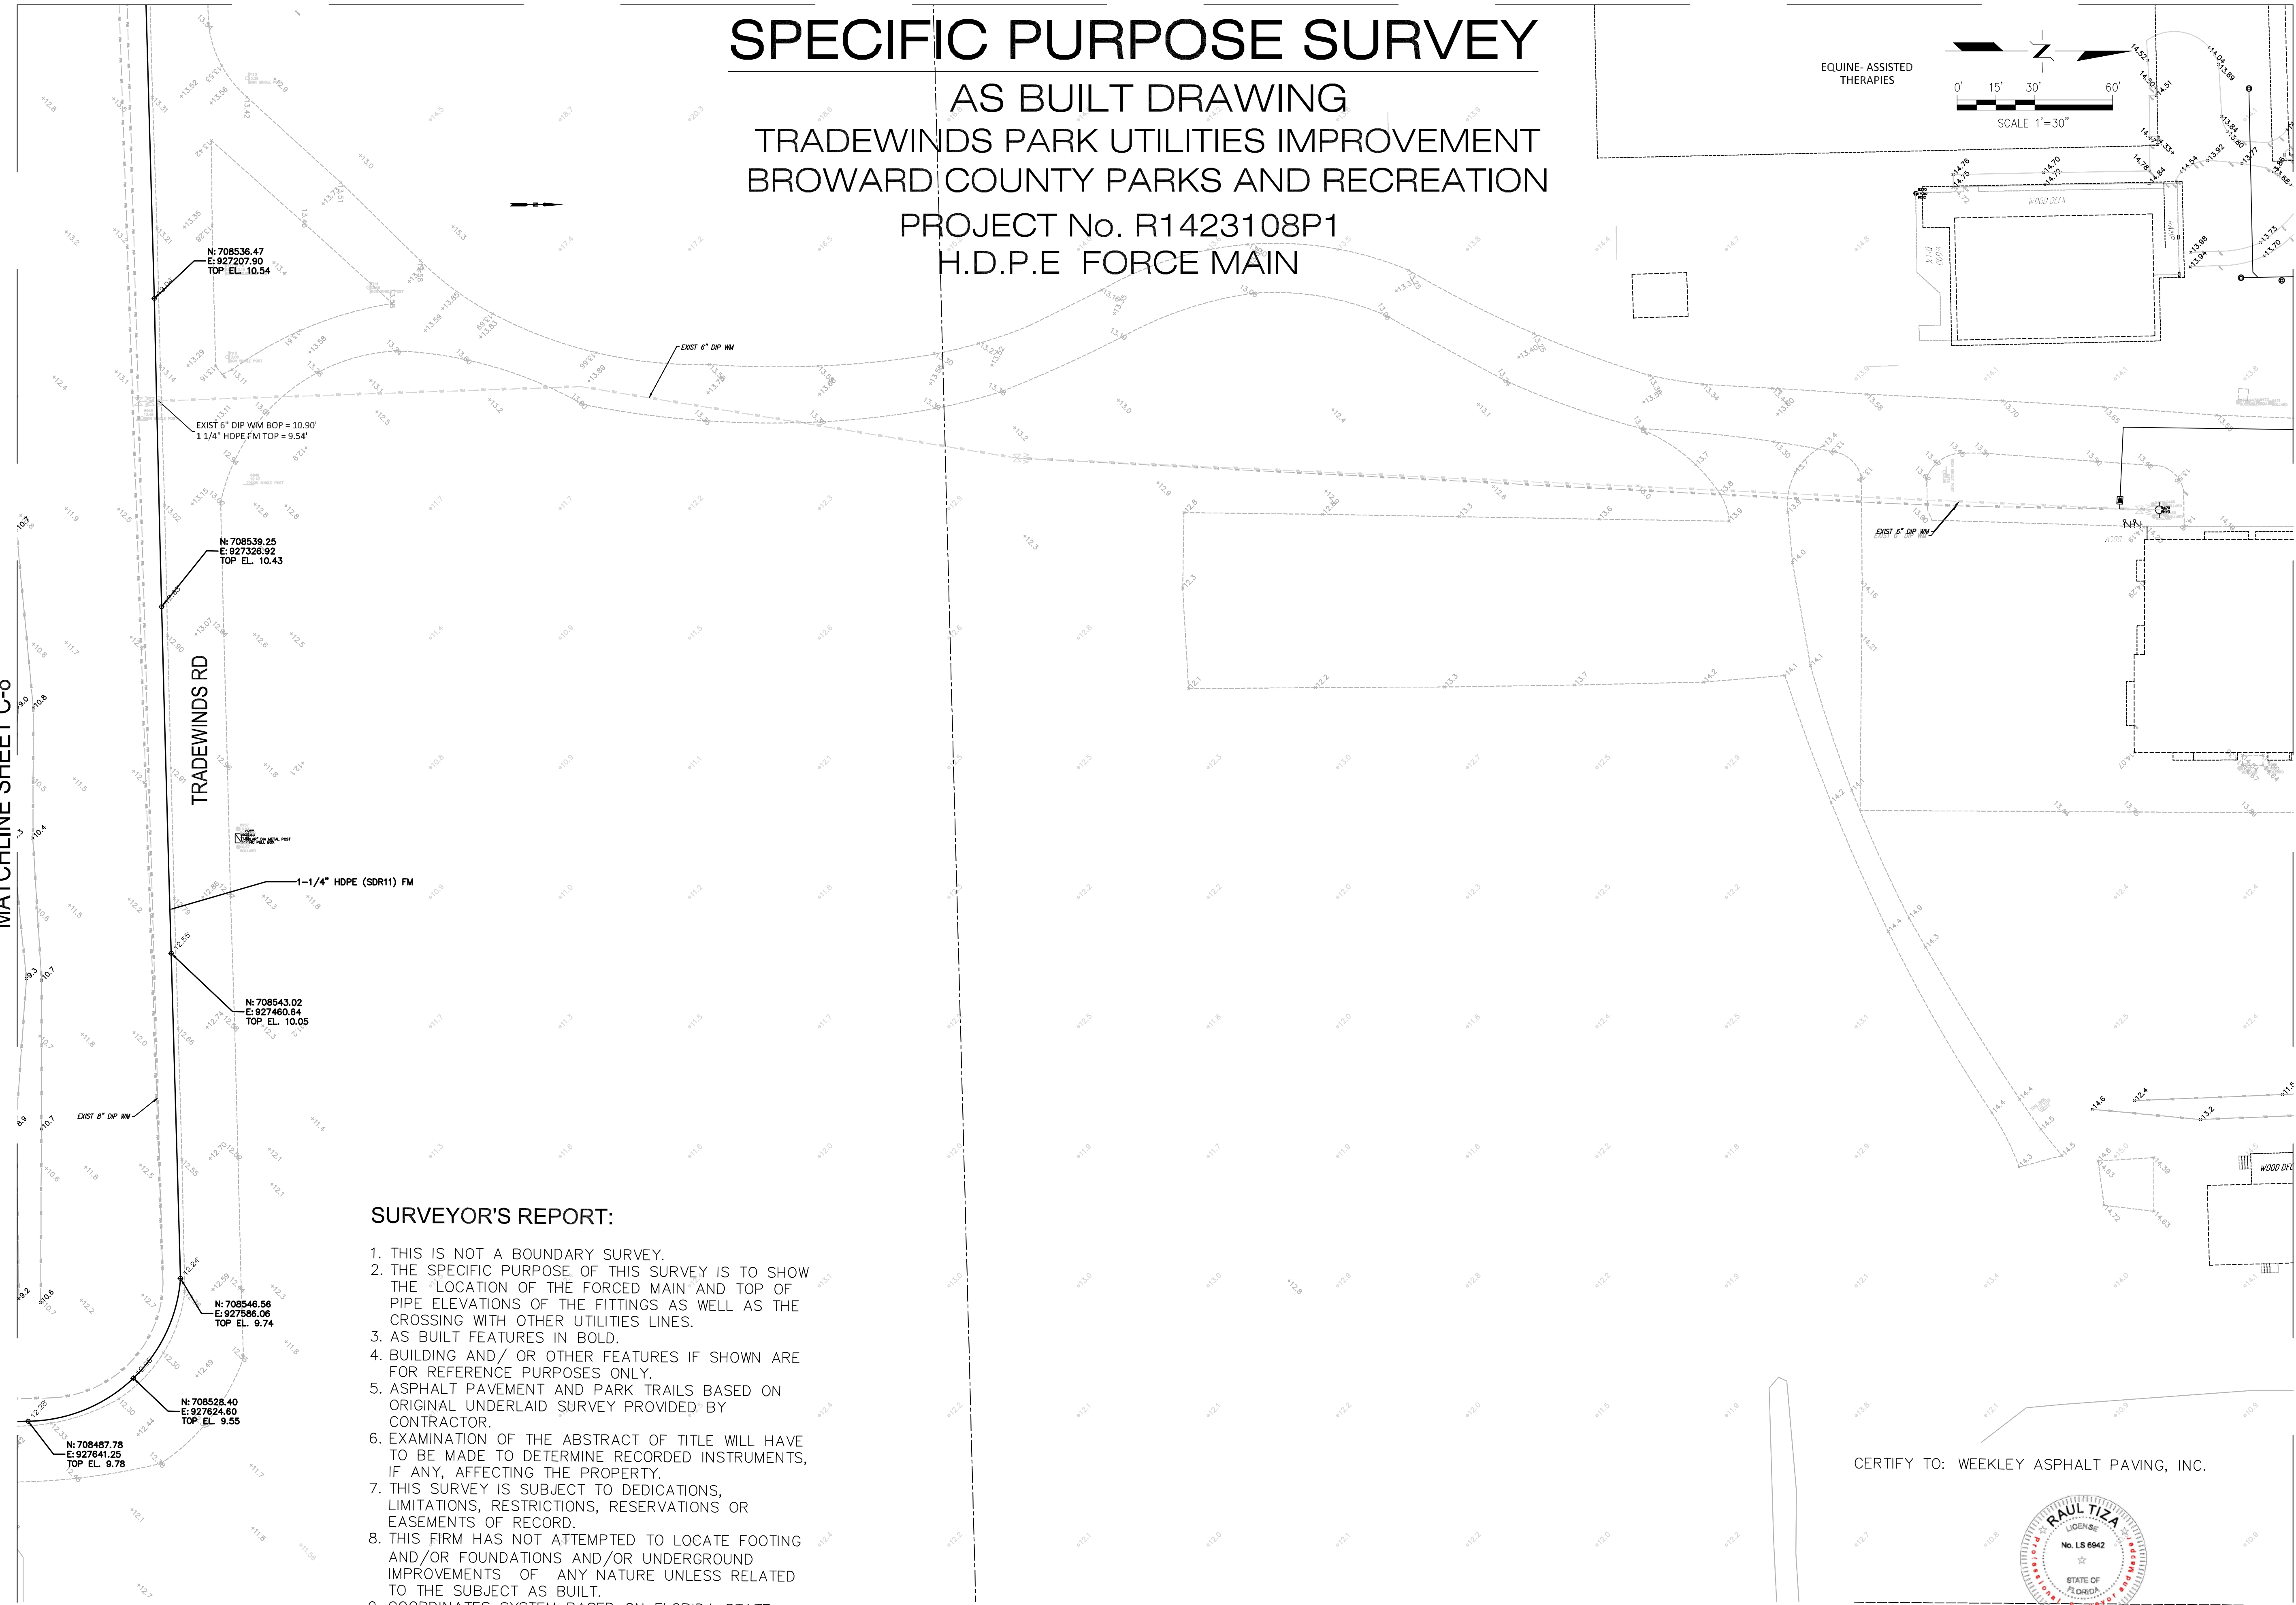

SPECIFIC PURPOSE SURVEY

AS BUILT DRAWING TRADEWINDS PARK UTILITIES IMPROVEMENT BROWARD COUNTY PARKS AND RECREATION

PROJECT No. R1423108P1
1-1/4" H.D.P.E FORCE MAIN

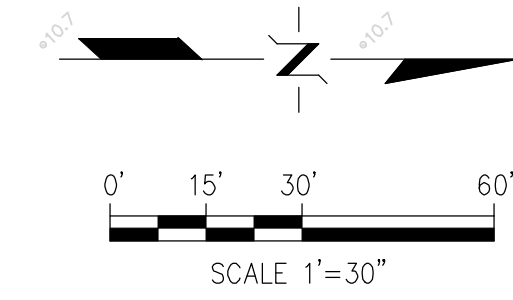


SURVEYOR'S REPORT:


1. THIS IS NOT A BOUNDARY SURVEY.
2. THE SPECIFIC PURPOSE OF THIS SURVEY IS TO SHOW THE LOCATION OF THE FORCED MAIN AND TOP OF PIPE ELEVATIONS OF THE FITTINGS AS WELL AS THE CROSSING WITH OTHER UTILITIES LINES.
3. AS BUILT FEATURES IN BOLD.
4. BUILDING AND/OR OTHER FEATURES IF SHOWN ARE FOR REFERENCE PURPOSES ONLY.
5. ASPHALT PAVEMENT AND PARK TRAILS BASED ON ORIGINAL UNDERLAID SURVEY PROVIDED BY CONTRACTOR.
6. EXAMINATION OF THE ABSTRACT OF TITLE WILL HAVE TO BE MADE TO DETERMINE RECORDED INSTRUMENTS, IF ANY, AFFECTING THE PROPERTY.
7. THIS SURVEY IS SUBJECT TO DEDICATIONS, LIMITATIONS, RESTRICTIONS, RESERVATIONS OR EASEMENTS OF RECORD.
8. THIS FIRM HAS NOT ATTEMPTED TO LOCATE FOOTING AND/OR FOUNDATIONS AND/OR UNDERGROUND IMPROVEMENTS OF ANY NATURE UNLESS RELATED TO THE SUBJECT AS BUILT.
9. COORDINATES SYSTEM BASED ON FLORIDA STATE PLANE COORDINATES N.A.D. 83 FLORIDA EAST, 1990 ADJUSTMENT.
10. ELEVATIONS SHOWN ARE BASED ON N.A.V.D. 88 VERTICAL DATUM.
11. LAST DATE OF THE FIELDWORK 12/22/2023




AS BUILT PLANS SHEET C-8

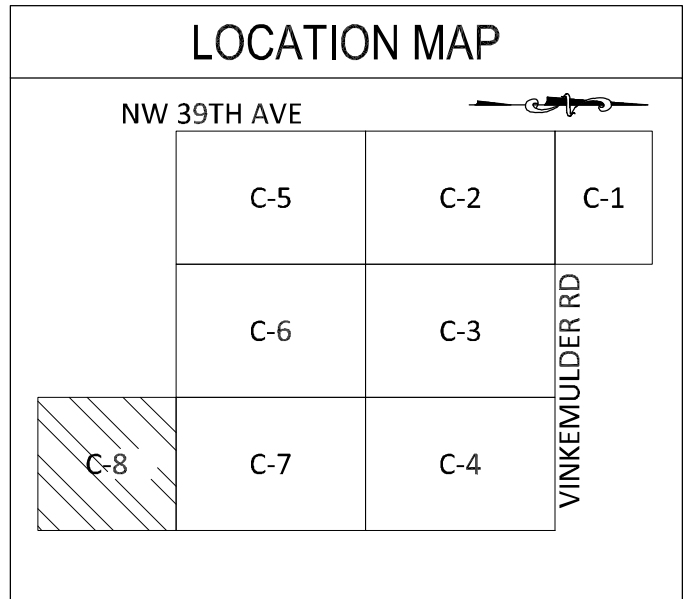

LEGEND	
BOP	BOTTOM OF PIPE
BOT	BOTTOM
BSP	BACTERIAL SAMPLING POINT
BU	BUBBLE UP STRUCTURE
CB	CATCH BASIN
CE	CONTROL ELEVATION
CLEAR	CLEARANCE
CMH	CONFLICT MANHOLE
CMP	CORRUGATED METAL PIPE
CONC	CONCRETE
CS	CONTROL STRUCTURE
DDCV	DOUBLE DETECTOR CHECK VALVE
DIP	DUCTILE IRON PIPE
DR	DRAINAGE
ELEV	ELEVATION
EXIST	EXISTING
FDC	FIRE DEPARTMENT CONNECTION
FFE	FINISHED FLOOR ELEVATION
FH	FIRE HYDRANT
FT	FEET
GV	GATE VALVE
GRD	FINISH GRADE
HDPE	HIGH DENSITY POLYETHYLENE
HW	HEADWALL
IE	INVERT ELEVATION
INV	INVERT OF PIPE
LF	LINEAR FEET
MAS	MAINTENANCE ACCESS STRUCTURE
NAVD	NORTH AMERICAN VERTICAL DATUM
OUT	OUTFALL
PL	PROPERTY LINE
PVC	POLYVINYL CHLORIDE PIPE
PROP	PROPOSED
RE	RIM ELEVATION
RIM	RIM OF STRUCTURE
RCP	REINFORCED CONCRETE PIPE
RPZ	REDUCED PRESSURE ZONE BACKFLOW PREVENTER
R/W	RIGHT OF WAY
STR	STRUCTURE
TOP	TOP OF PIPE
TYP	TYPICAL
WM	WATER MAIN
W/	WITH
YD	YARD DRAIN
	EXIST GRADE (FT-NAVD)
	PROP GRADE (FT-NAVD)
	ASPHALT PAVEMENT
	TO BE REMOVED CONFLICT MARKER
	TO BE REMOVED
	CHAIN LINK FENCE
	DECORATIVE FENCE
	PROPERTY LINE
	EASEMENT LINE
	R/W LINE

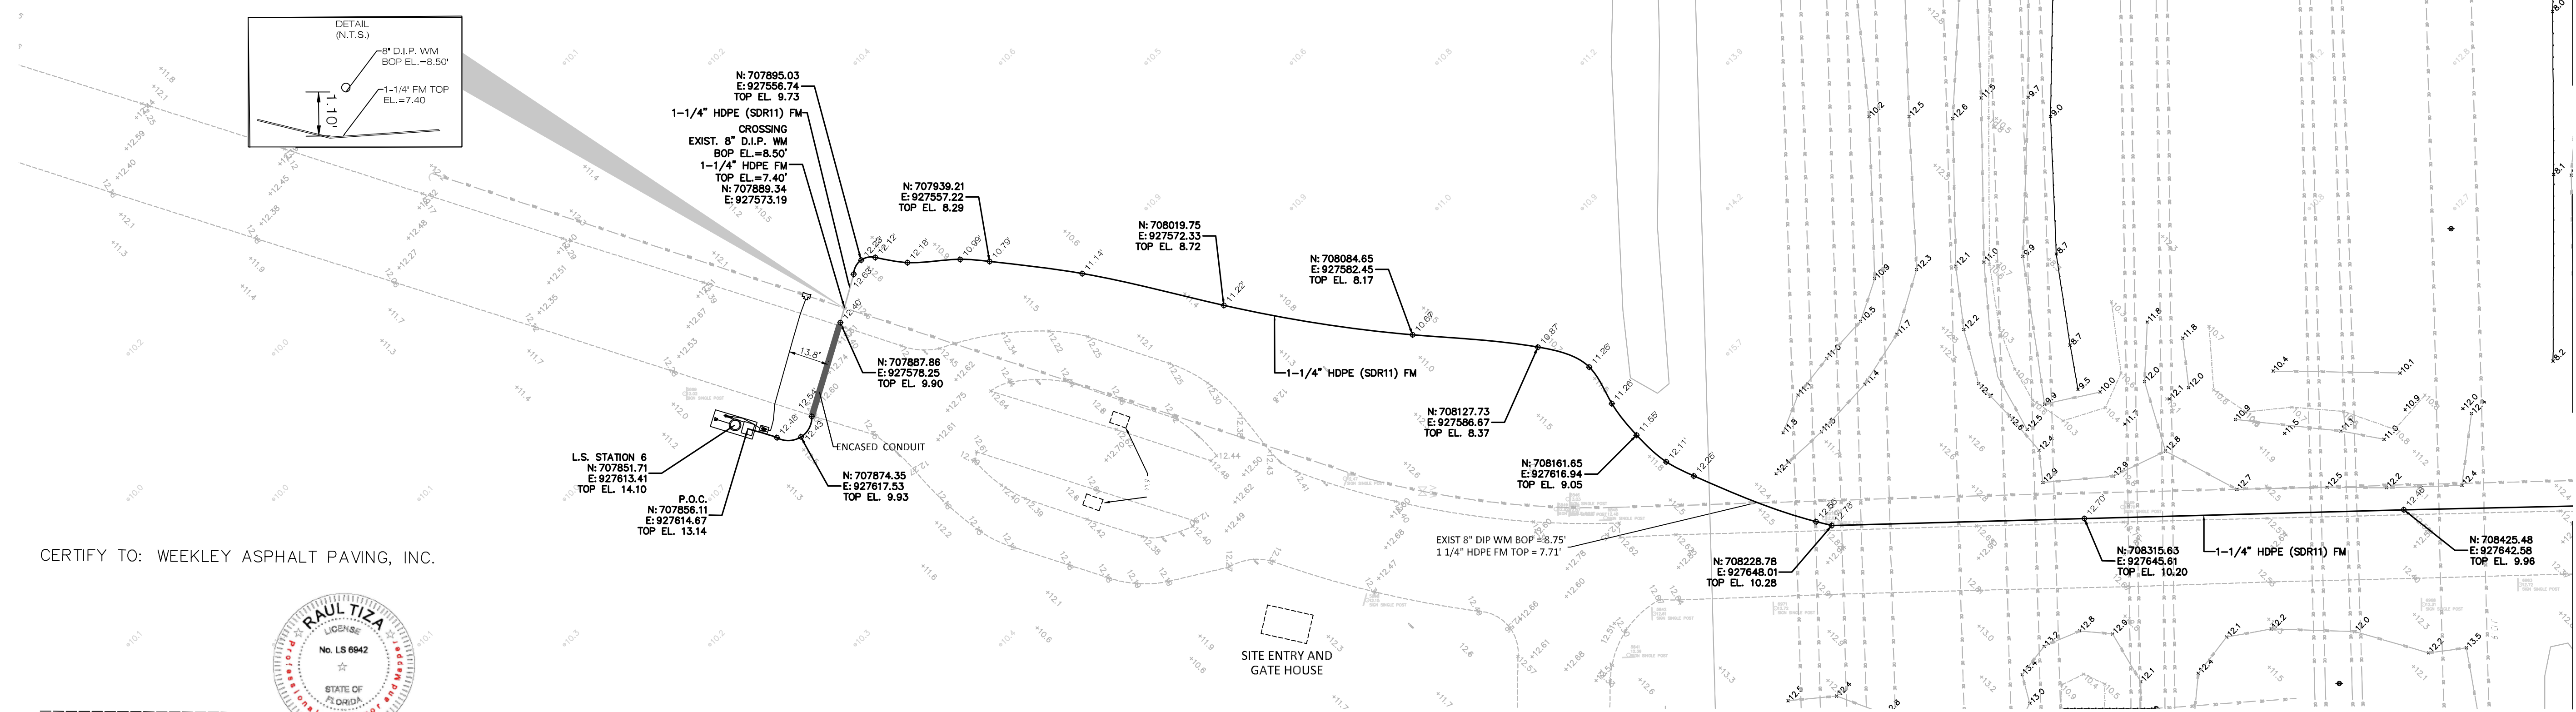

CERTIFY TO: WEEKLEY ASPHALT PAVING, INC.

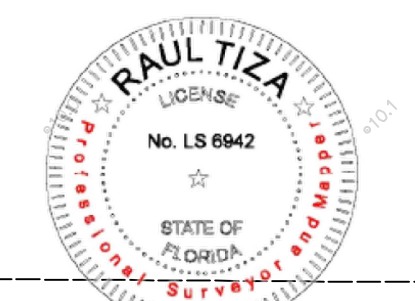

RAUL TIZA
LAND SURVEYOR AND MAPPER No. 6942, LB 8029.
STATE OF FLORIDA
18761 SW 291st TERRACE MIAMI FLORIDA 33030
PHONE: 786-975-8588

NOT VALID WITHOUT THE SIGNATURE AND THE ELECTRONIC SEAL OF A FLORIDA LICENSED SURVEYOR AND MAPPER

MATCHLINE SHEET C-7