
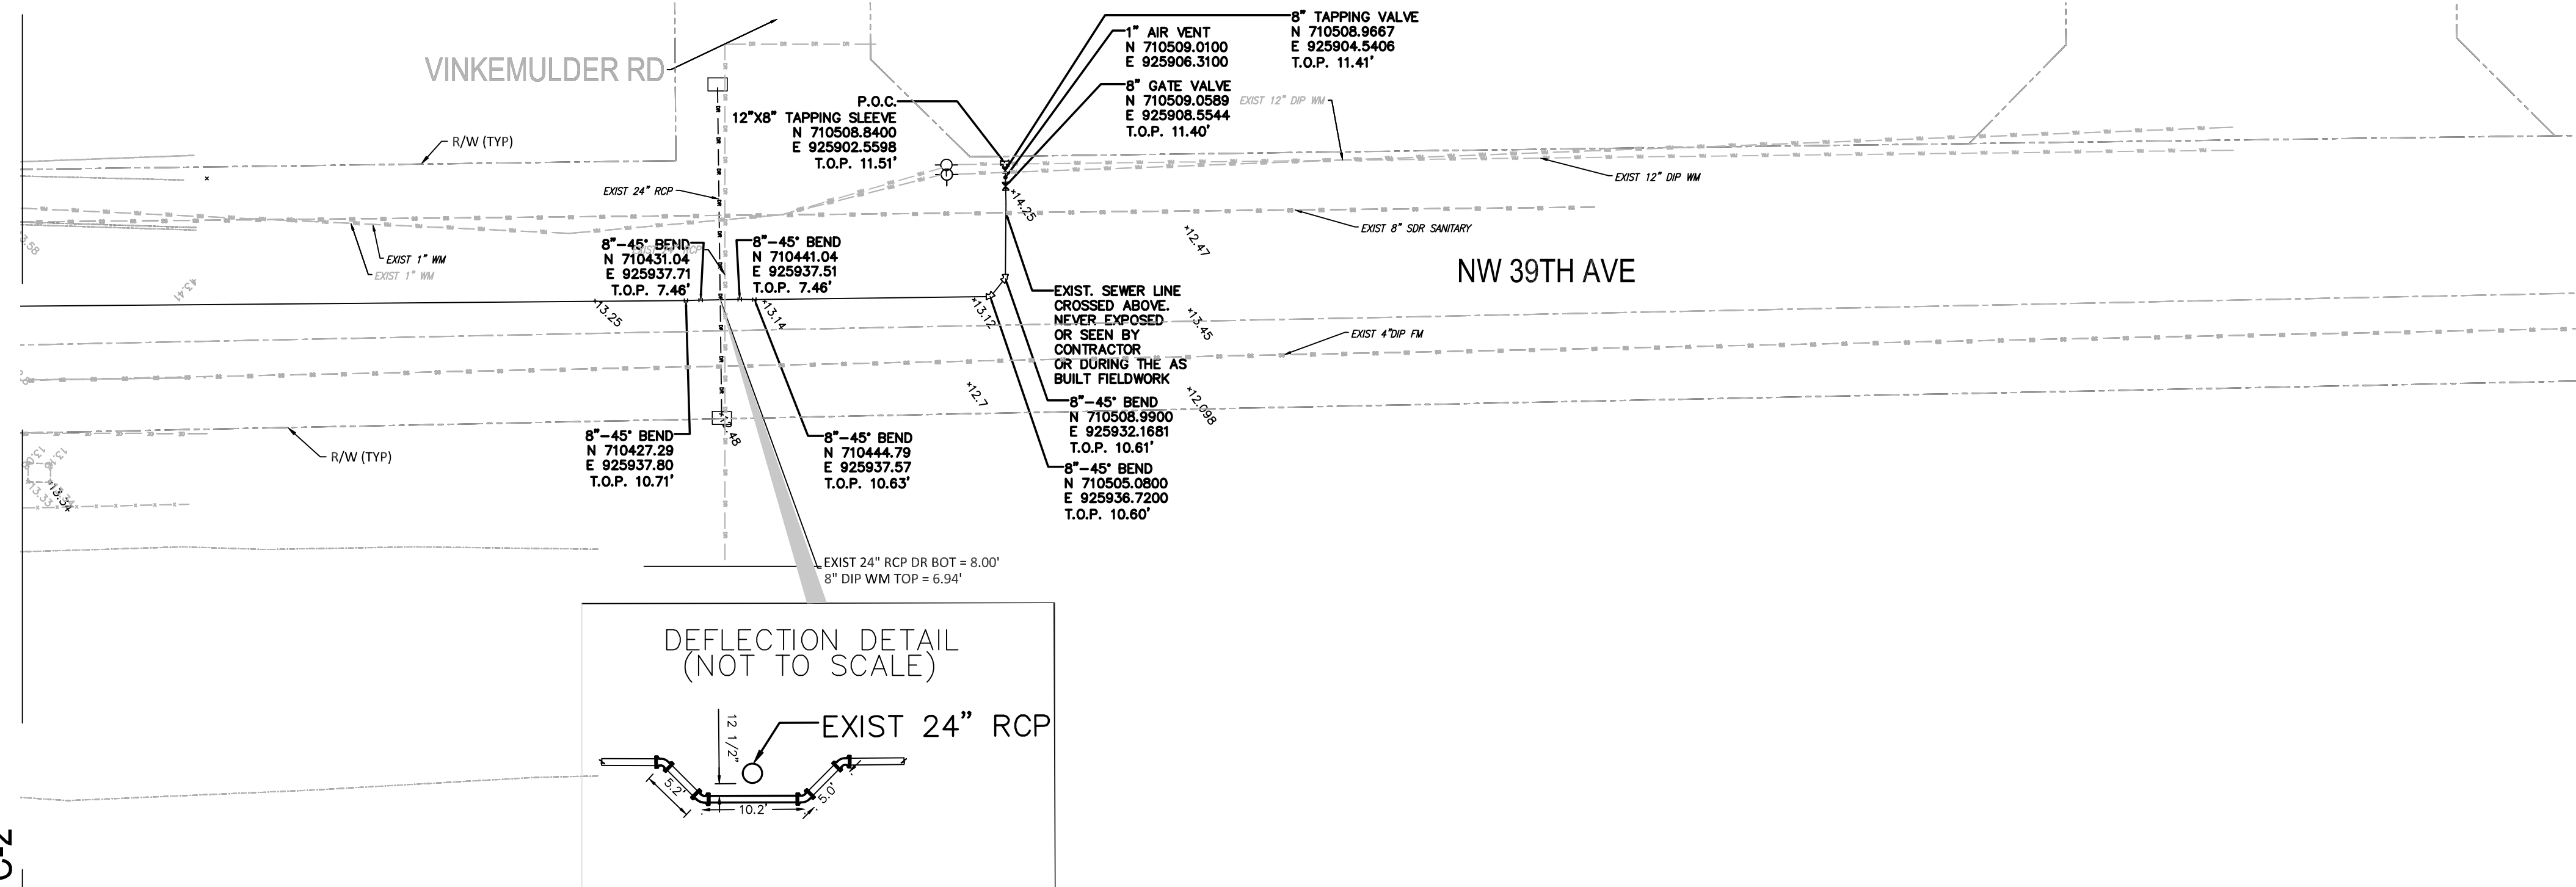
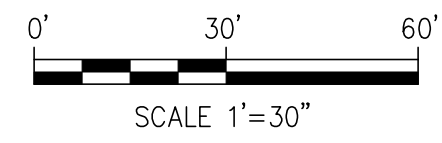


# SPECIFIC PURPOSE SURVEY


## AS BUILT DRAWING TRADEWINDS PARK UTILITIES IMPROVEMENT BROWARD COUNTY PARKS AND RECREATION

PROJECT No. R1423108P1  
8" D.I.P. WATER MAIN

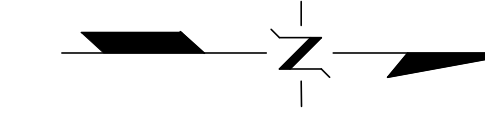

MATCHLINE SHEET C-2


AS BUILT PLANS  
SHEET C-1

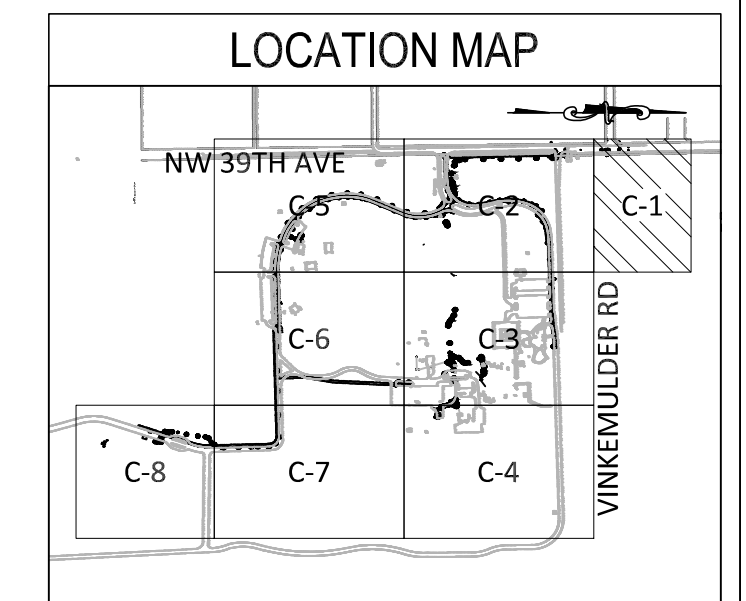

### SURVEYOR'S REPORT:

1. THIS IS NOT A BOUNDARY SURVEY.
2. THE SPECIFIC PURPOSE OF THIS SURVEY IS TO SHOW THE LOCATION OF THE 8" WATER MAIN AND TOP OF PIPE ELEVATIONS OF THE FITTINGS AS WELL AS THE CROSSING WITH OTHER UTILITIES LINES.
3. AS BUILT FEATURES IN BOLD.
4. BUILDING AND/ OR OTHER FEATURES IF SHOWN ARE FOR REFERENCE PURPOSES ONLY.
5. EXAMINATION OF THE ABSTRACT OF TITLE WILL HAVE TO BE MADE TO DETERMINE RECORDED INSTRUMENTS, IF ANY, AFFECTING THE PROPERTY.
6. THIS SURVEY IS SUBJECT TO DEDICATIONS, LIMITATIONS, RESTRICTIONS, RESERVATIONS OR EASEMENTS OF RECORD.
7. THIS FIRM HAS NOT ATTEMPTED TO LOCATE FOOTING AND/OR FOUNDATIONS AND/OR UNDERGROUND IMPROVEMENTS OF ANY NATURE UNLESS RELATED TO THE SUBJECT AS BUILT.
8. COORDINATES SYSTEM BASED ON FLORIDA STATE PLANE COORDINATES N.A.D. 83 FLORIDA EAST, 1990 ADJUSTMENT.
9. ELEVATIONS SHOWN ARE BASED ON N.A.V.D. 88 VERTICAL DATUM.
10. LAST DATE OF THE FIELDWORK 12/22/2023

CERTIFY TO: WEEKLEY ASPHALT PAVING, INC.

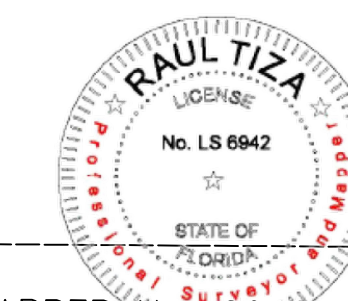

**RAUL TIZA**  
LAND SURVEYOR AND MAPPER No. 6942, LB 8029.  
STATE OF FLORIDA  
18761 SW 291st TERRACE MIAMI FLORIDA 33030  
PHONE: 786-975-8588

NOT VALID WITHOUT THE SIGNATURE AND THE ELECTRONIC SEAL OF A FLORIDA LICENSED SURVEYOR AND MAPPER

### LEGEND


BOP	BOTTOM OF PIPE
BOT	BOTTOM
BSP	BACTERIAL SAMPLING POINT
BU	BUBBLE UP STRUCTURE
CB	CATCH BASIN
CE	CONTROL ELEVATION
CLEAR	CLEARANCE
CMH	CONFLICT MANHOLE
CMP	CORRUGATED METAL PIPE
CONC	CONCRETE
CS	CONTROL STRUCTURE
DDCV	DOUBLE DETECTOR CHECK VALVE
DIP	DUCTILE IRON PIPE
DR	DRAINAGE
ELEV	ELEVATION
EXIST	EXISTING
FDC	FIRE DEPARTMENT CONNECTION
FFE	FINISHED FLOOR ELEVATION
FH	FIRE HYDRANT
FT	FEET
GV	GATE VALVE
GRD	FINISH GRADE
HDPE	HIGH DENSITY POLYETHYLENE
HW	HEADWALL
IE	INVERT ELEVATION
INV	INVERT OF PIPE
LF	LINEAR FEET
MAS	MAINTENANCE ACCESS STRUCTURE
NAVD	NORTH AMERICAN VERTICAL DATUM
OUT	OUTFALL
P	PROPERTY LINE
PVC	POLYVINYL CHLORIDE PIPE
PROP	PROPOSED
RE	RIM ELEVATION
RIM	RIM OF STRUCTURE
RCP	REINFORCED CONCRETE PIPE
RPZ	REDUCED PRESSURE ZONE BACKFLOW PREVENTER
R/W	RIGHT OF WAY
STR	STRUCTURE
TOP	TOP OF PIPE
TYP	TYPICAL
WM	WATER MAIN
W/	WITH
YD	YARD DRAIN
	EXIST GRADE (FT-NAVD)
	PROP GRADE (FT-NAVD)
	ASPHALT PAVEMENT
	TO BE REMOVED CONFLICT MARKER
	TO BE REMOVED
	CHAIN LINK FENCE
	DECORATIVE FENCE
	PROPERTY LINE
	EASEMENT LINE
	R/W LINE

# SPECIFIC PURPOSE SURVEY

PROJECT No. R1423108P1  
8" D.I.P. WATER MAIN


## AS BUILT DRAWING

TRADEWINDS PARK UTILITIES IMPROVEMENT  
BROWARD COUNTY PARKS AND RECREATION

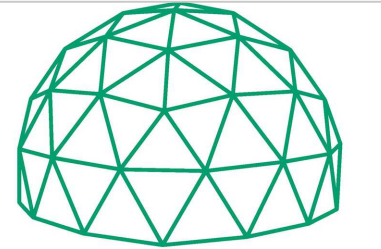


**RT GEOSOLUTIONS**  
A LAND SURVEYING COMPANY

AS BUILT PLANS  
SHEET C-2

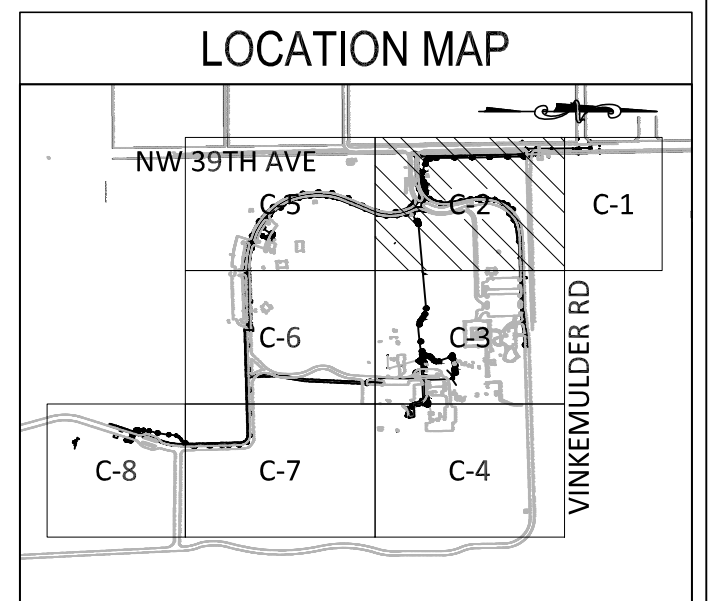

MATCHLINE SHEET C-1

MATCHLINE SHEET C-5

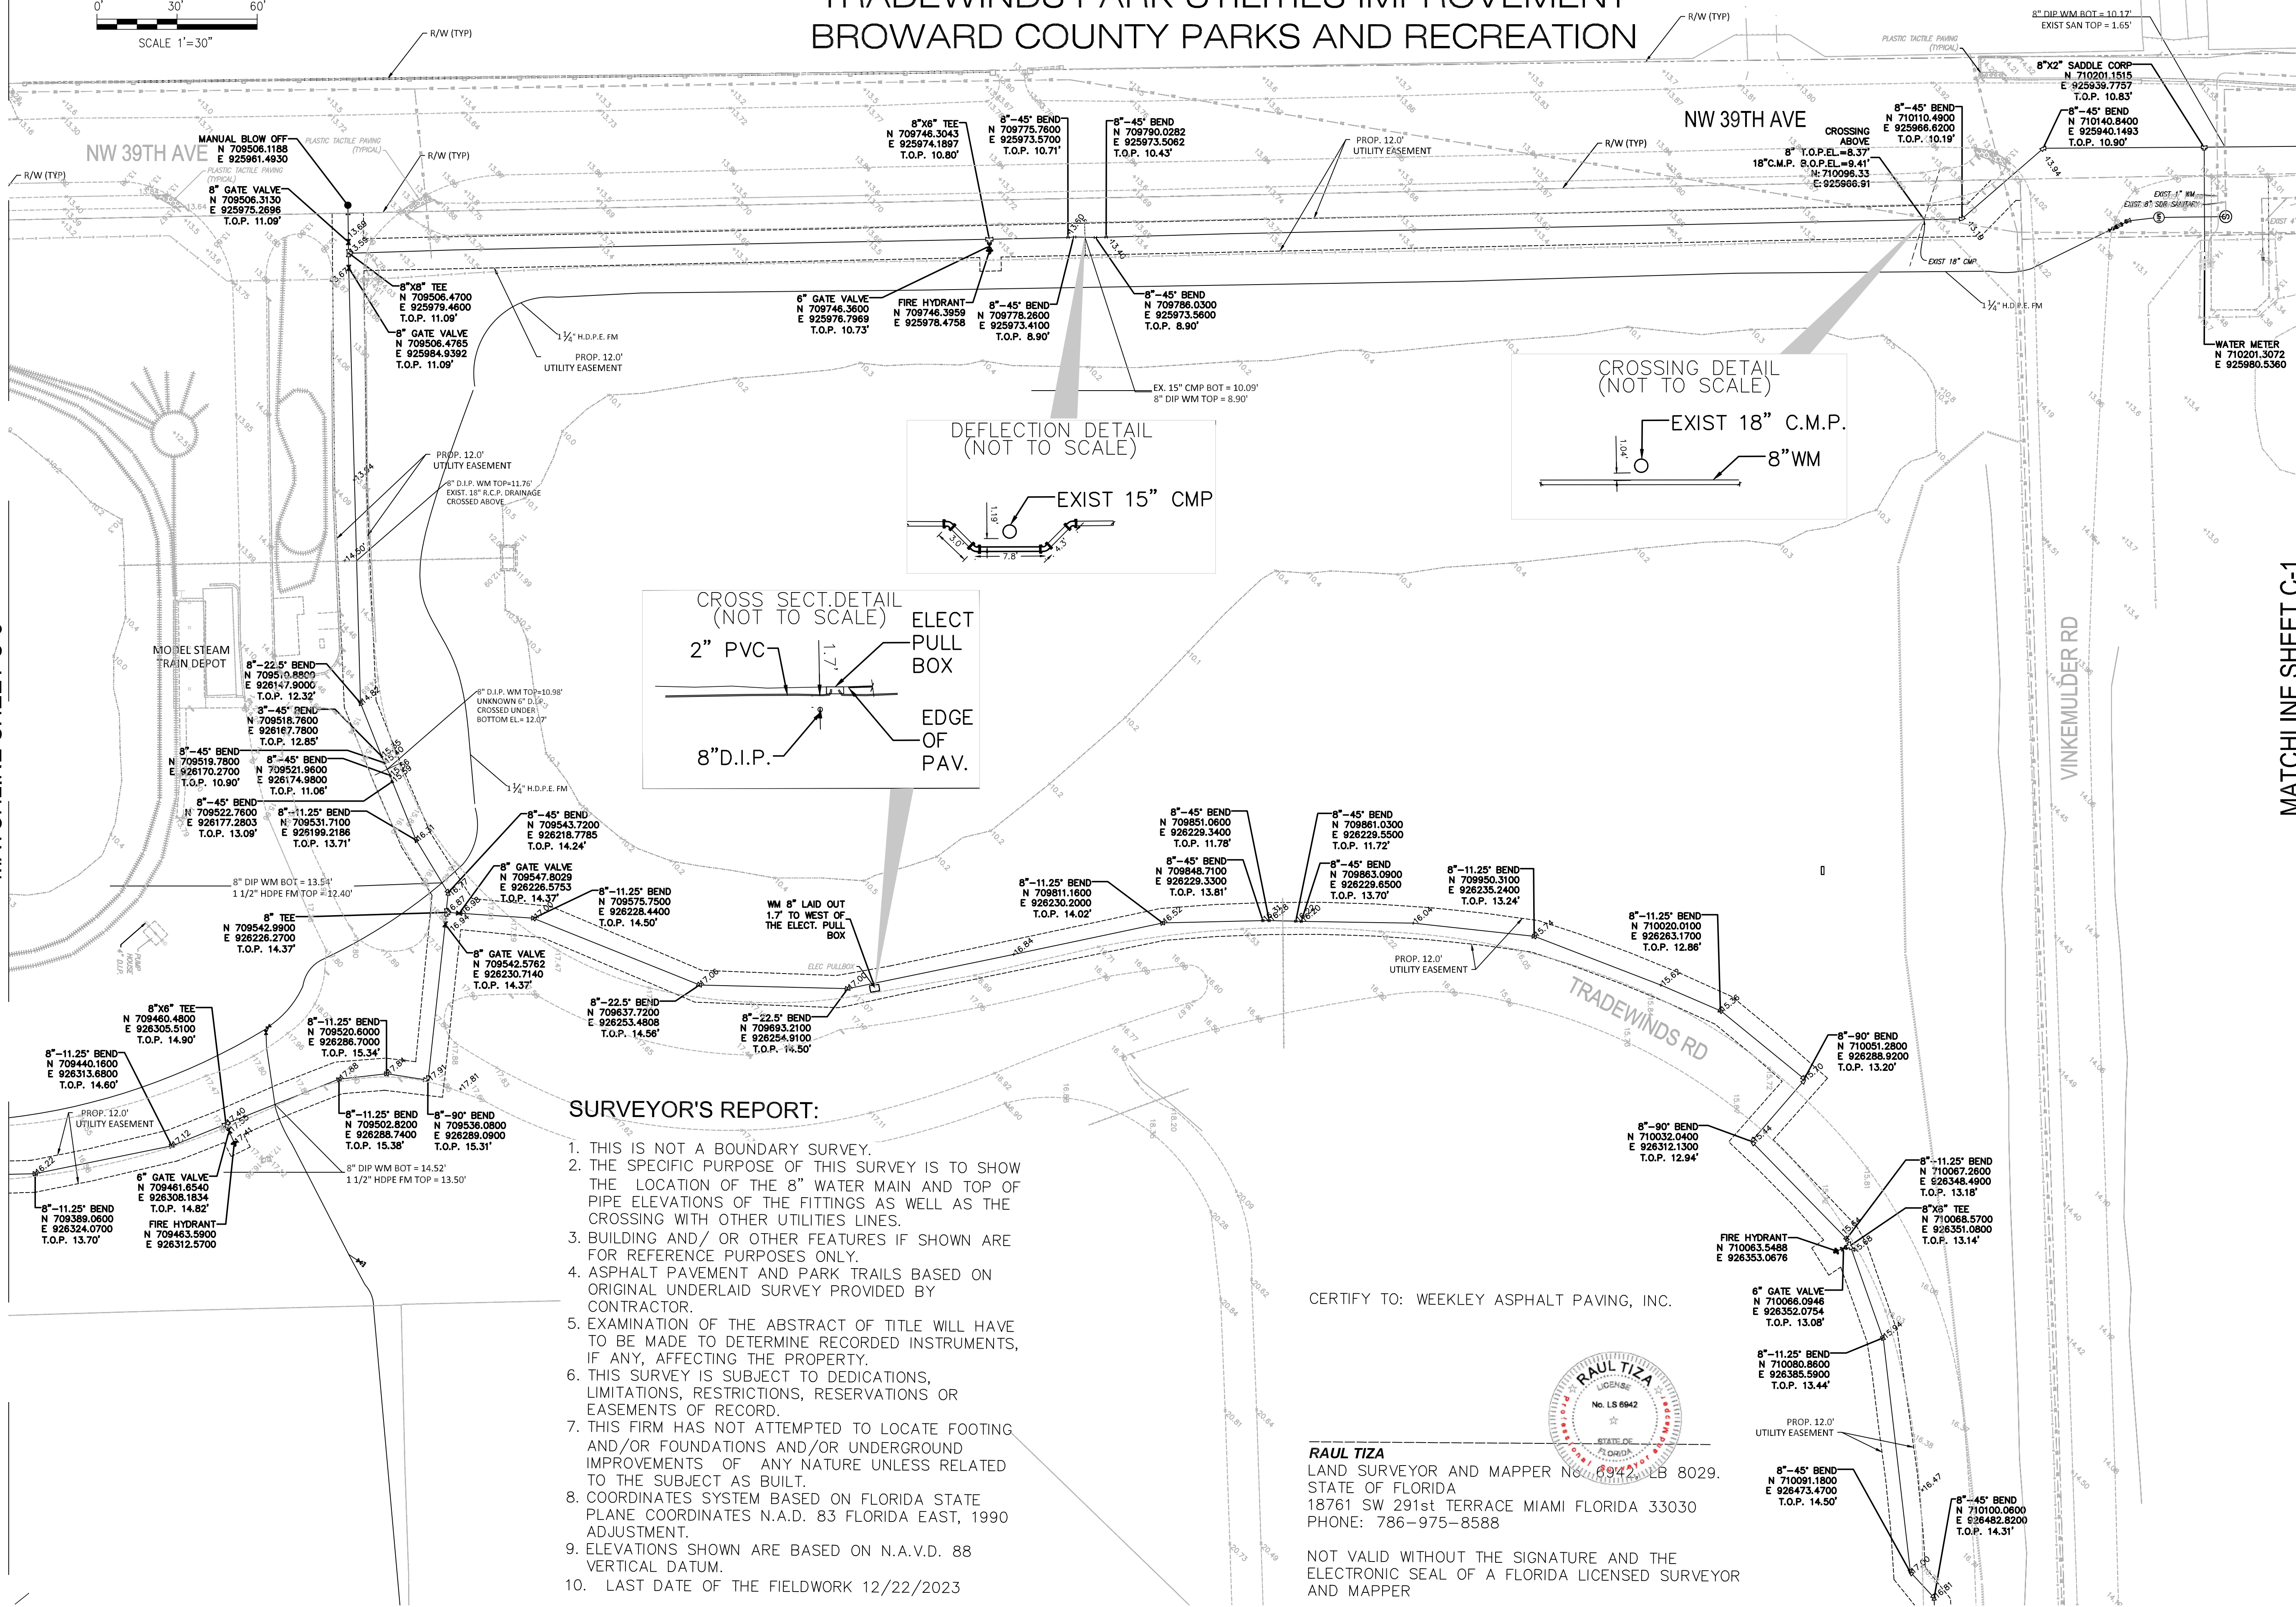

**SURVEYOR'S REPORT:**

1. THIS IS NOT A BOUNDARY SURVEY.
2. THE SPECIFIC PURPOSE OF THIS SURVEY IS TO SHOW THE LOCATION OF THE 8" WATER MAIN AND TOP OF PIPE ELEVATIONS OF THE FITTINGS AS WELL AS THE CROSSING WITH OTHER UTILITIES LINES.
3. BUILDING AND/ OR OTHER FEATURES IF SHOWN ARE FOR REFERENCE PURPOSES ONLY.
4. ASPHALT PAVEMENT AND PARK TRAILS BASED ON ORIGINAL UNDERLAID SURVEY PROVIDED BY CONTRACTOR.
5. EXAMINATION OF THE ABSTRACT OF TITLE WILL HAVE TO BE MADE TO DETERMINE RECORDED INSTRUMENTS, IF ANY, AFFECTING THE PROPERTY.
6. THIS SURVEY IS SUBJECT TO DEDICATIONS, LIMITATIONS, RESTRICTIONS, RESERVATIONS OR EASEMENTS OF RECORD.
7. THIS FIRM HAS NOT ATTEMPTED TO LOCATE FOOTING AND/OR FOUNDATIONS AND/OR UNDERGROUND IMPROVEMENTS OF ANY NATURE UNLESS RELATED TO THE SUBJECT AS BUILT.
8. COORDINATES SYSTEM BASED ON FLORIDA STATE PLANE COORDINATES N.A.D. 83 FLORIDA EAST, 1990 ADJUSTMENT.
9. ELEVATIONS SHOWN ARE BASED ON N.A.V.D. 88 VERTICAL DATUM.
10. LAST DATE OF THE FIELDWORK 12/22/2023

CERTIFY TO: WEEKLEY ASPHALT PAVING, INC.



**RAUL TIZA**  
LAND SURVEYOR AND MAPPER No. 6942, CEB 8029.  
STATE OF FLORIDA  
18761 SW 291st TERRACE MIAMI FLORIDA 33030  
PHONE: 786-975-8588

NOT VALID WITHOUT THE SIGNATURE AND THE ELECTRONIC SEAL OF A FLORIDA LICENSED SURVEYOR AND MAPPER

LEGEND	
BOP	BOTTOM OF PIPE
BOT	BOTTOM
BSJ	BACTERIAL SAMPLING POINT
BU	BURIED UP STRUCTURE
CB	CATCH BASIN
CE	CONTROL ELEVATION
CLEAR	CLEARANCE
CMH	CONFLICT MANHOLE
CMP	CORRUGATED METAL PIPE
CONC	CONCRETE
CS	CONTROL STRUCTURE
DDCV	DOUBLE DETECTOR CHECK VALVE
DIP	DUCTILE IRON PIPE
DR	DRAINAGE
ELEV	ELEVATION
EXIST	EXISTING
EXIST	EXISTING CONNECTION
FDC	FIRE DEPARTMENT CONNECTION
FFC	FINISHED FLOOR ELEVATION
FH	FIRE HYDRANT
FT	FEET
GV	GATE VALVE
GRD	FINISH GRADE
HDPE	HIGH DENSITY POLYETHYLENE
HW	HEADWALL
IE	INVERT ELEVATION
INV	INVERT OF PIPE
LF	LINEAR FEET
MAS	MAINTENANCE ACCESS STRUCTURE
NAVD	NORTH AMERICAN VERTICAL DATUM
OUT	OUTFALL
PL	PROPERTY LINE
PVC	POLYVINYL CHLORIDE PIPE
PROP	PROPOSED
RE	RIM ELEVATION
RIM	RIM OF STRUCTURE
RCP	REINFORCED CONCRETE PIPE
RPZ	REDUCED PRESSURE ZONE BACKFLOW PREVENTER
R/W	RIGHT OF WAY
STR	STRUCTURE
TOP	TOP OF PIPE
TOP	TOP OF STRUCTURE
TYP	TYPICAL
WM	WATER MAIN
W/	WITH
YD	YARD DRAIN



# SPECIFIC PURPOSE SURVEY

PROJECT No. R1423108P1  
8" D.I.P. WATER MAIN



MATCHLINE SHEET C-2  
AS BUILT DRAWING  
TRADEWINDS PARK UTILITIES IMPROVEMENT  
BROWARD COUNTY PARKS AND RECREATION

AS BUILT PLANS  
SHEET C-3

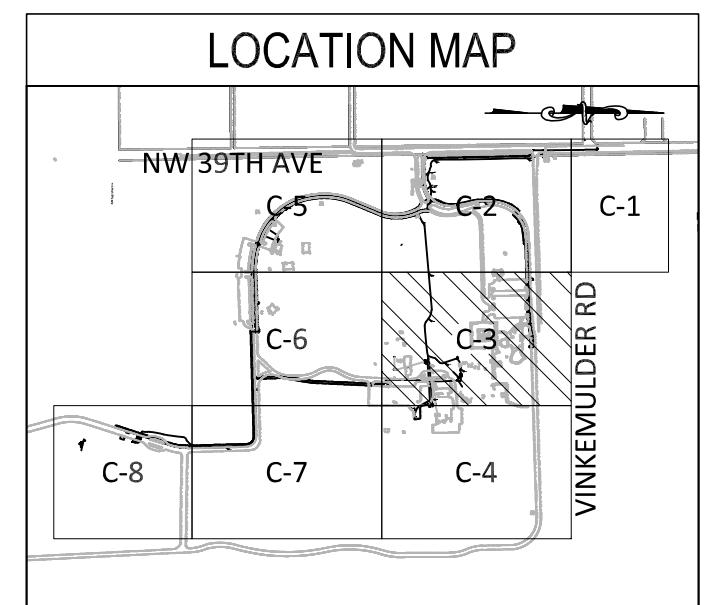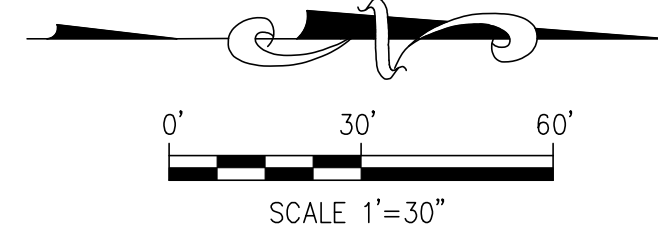


LEGEND	
BOP	BOTTOM OF PIPE
BOT	BOTTOM
BSP	BACTERIAL SAMPLING POINT
BU	BUBBLE UP STRUCTURE
CB	CATCH BASIN
CE	CONTROL ELEVATION
CMH	CONFLICT MANHOLE
CMP	CORRUGATED METAL PIPE
CONC	CONCRETE
CS	CONTROL STRUCTURE
DDCV	DOUBLE DETECTOR CHECK VALVE
DIP	DUCTILE IRON PIPE
DR	DRAINAGE
ELEV	ELEVATION
EXIST	EXISTING
FDC	FIRE DEPARTMENT CONNECTION
FFE	FINISHED FLOOR ELEVATION
FH	FIRE HYDRANT
FT	FEET
GV	GATE VALVE
GRD	FINISH GRADE
HDPE	HIGH DENSITY POLYETHYLENE
HW	HEADWALL
IE	INVERT ELEVATION
INV	INVERT OF PIPE
LF	LINEAR FEET
MAS	MAINTENANCE ACCESS STRUCTURE
NAVD	NORTH AMERICAN VERTICAL DATUM
OUT	OUTFALL
PL	PROPERTY LINE
PVC	POLYVINYL CHLORIDE PIPE
PROP	PROPOSED
RE	RIM ELEVATION
RIM	RIM OF STRUCTURE
RCP	REINFORCED CONCRETE PIPE
RPZ	REDUCED PRESSURE ZONE BACKFLOW PREVENTER
R/W	RIGHT OF WAY
STR	STRUCTURE
TOP	TOP OF PIPE
TYP	TYPICAL
WM	WATER MAIN
W/	WIDTH
YD	YARD DRAIN
---	EXIST GRADE (FT-NAVD)
---	PROP GRADE (FT-NAVD)
---	ASPHALT PAVEMENT
---	TO BE REMOVED CONFLICT MARKER
---	TO BE REMOVED
---	CHAIN LINK FENCE
---	DECORATIVE FENCE
---	PROPERTY LINE
---	EASEMENT LINE
---	R/W LINE

**SURVEYOR'S REPORT:**

1. THIS IS NOT A BOUNDARY SURVEY.
2. THE SPECIFIC PURPOSE OF THIS SURVEY IS TO SHOW THE LOCATION OF THE 8" WATER MAIN AND TOP OF PIPE ELEVATIONS OF THE FITTINGS AS WELL AS THE CROSSING WITH OTHER UTILITIES LINES.
3. AS BUILT FEATURES IN BOLD.
4. BUILDING AND/ OR OTHER FEATURES IF SHOWN ARE FOR REFERENCE PURPOSES ONLY.
5. ASPHALT PAVEMENT AND PARK TRAILS BASED ON ORIGINAL UNDERLAID SURVEY PROVIDED BY CONTRACTOR.
6. EXAMINATION OF THE ABSTRACT OF TITLE WILL HAVE TO BE MADE TO DETERMINE RECORDED INSTRUMENTS, IF ANY, AFFECTING THE PROPERTY.
7. THIS SURVEY IS SUBJECT TO DEDICATIONS, LIMITATIONS, RESTRICTIONS, RESERVATIONS OR EASEMENTS OF RECORD.
8. THIS FIRM HAS NOT ATTEMPTED TO LOCATE FOOTING AND/OR FOUNDATIONS AND/OR UNDERGROUND IMPROVEMENTS OF ANY NATURE UNLESS RELATED TO THE SUBJECT AS BUILT.
9. COORDINATES SYSTEM BASED ON FLORIDA STATE PLANE COORDINATES N.A.D. 83 FLORIDA EAST, 1990 ADJUSTMENT.
10. ELEVATIONS SHOWN ARE BASED ON N.A.V.D. 88 VERTICAL DATUM.
11. LAST DATE OF THE FIELDWORK 12/22/2023

LIMITS OF ADDITIONAL LICENSED PROPERTY  
CERTIFY TO: WEEKLEY ASPHALT PAVING, INC.


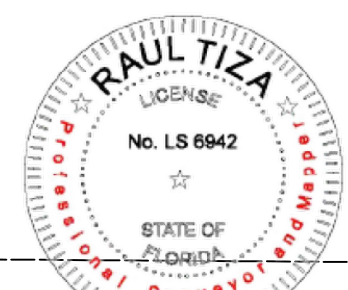



**RAUL TIZA**  
LAND SURVEYOR AND MAPPER No. 6942, LB 8029.  
STATE OF FLORIDA  
18761 SW 291st TERRACE MIAMI FLORIDA 33030  
PHONE: 786-975-8588

NOT VALID WITHOUT THE SIGNATURE AND THE ELECTRONIC SEAL OF A FLORIDA LICENSED SURVEYOR AND MAPPER

MATCHLINE SHEET C-4

MATCHLINE SHEET C-6

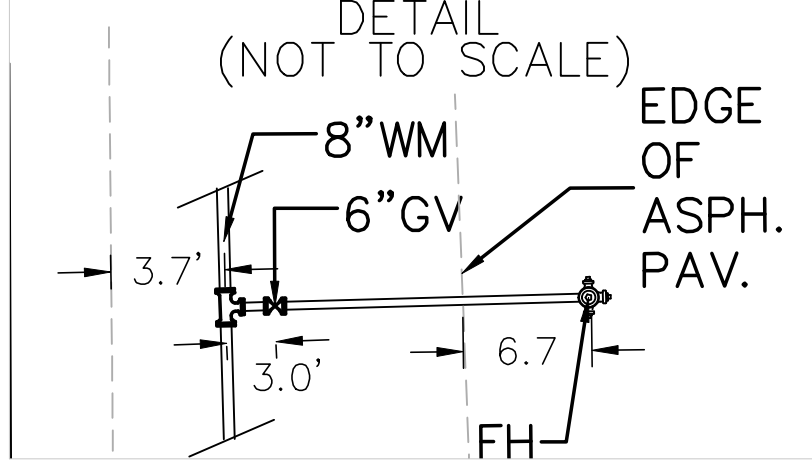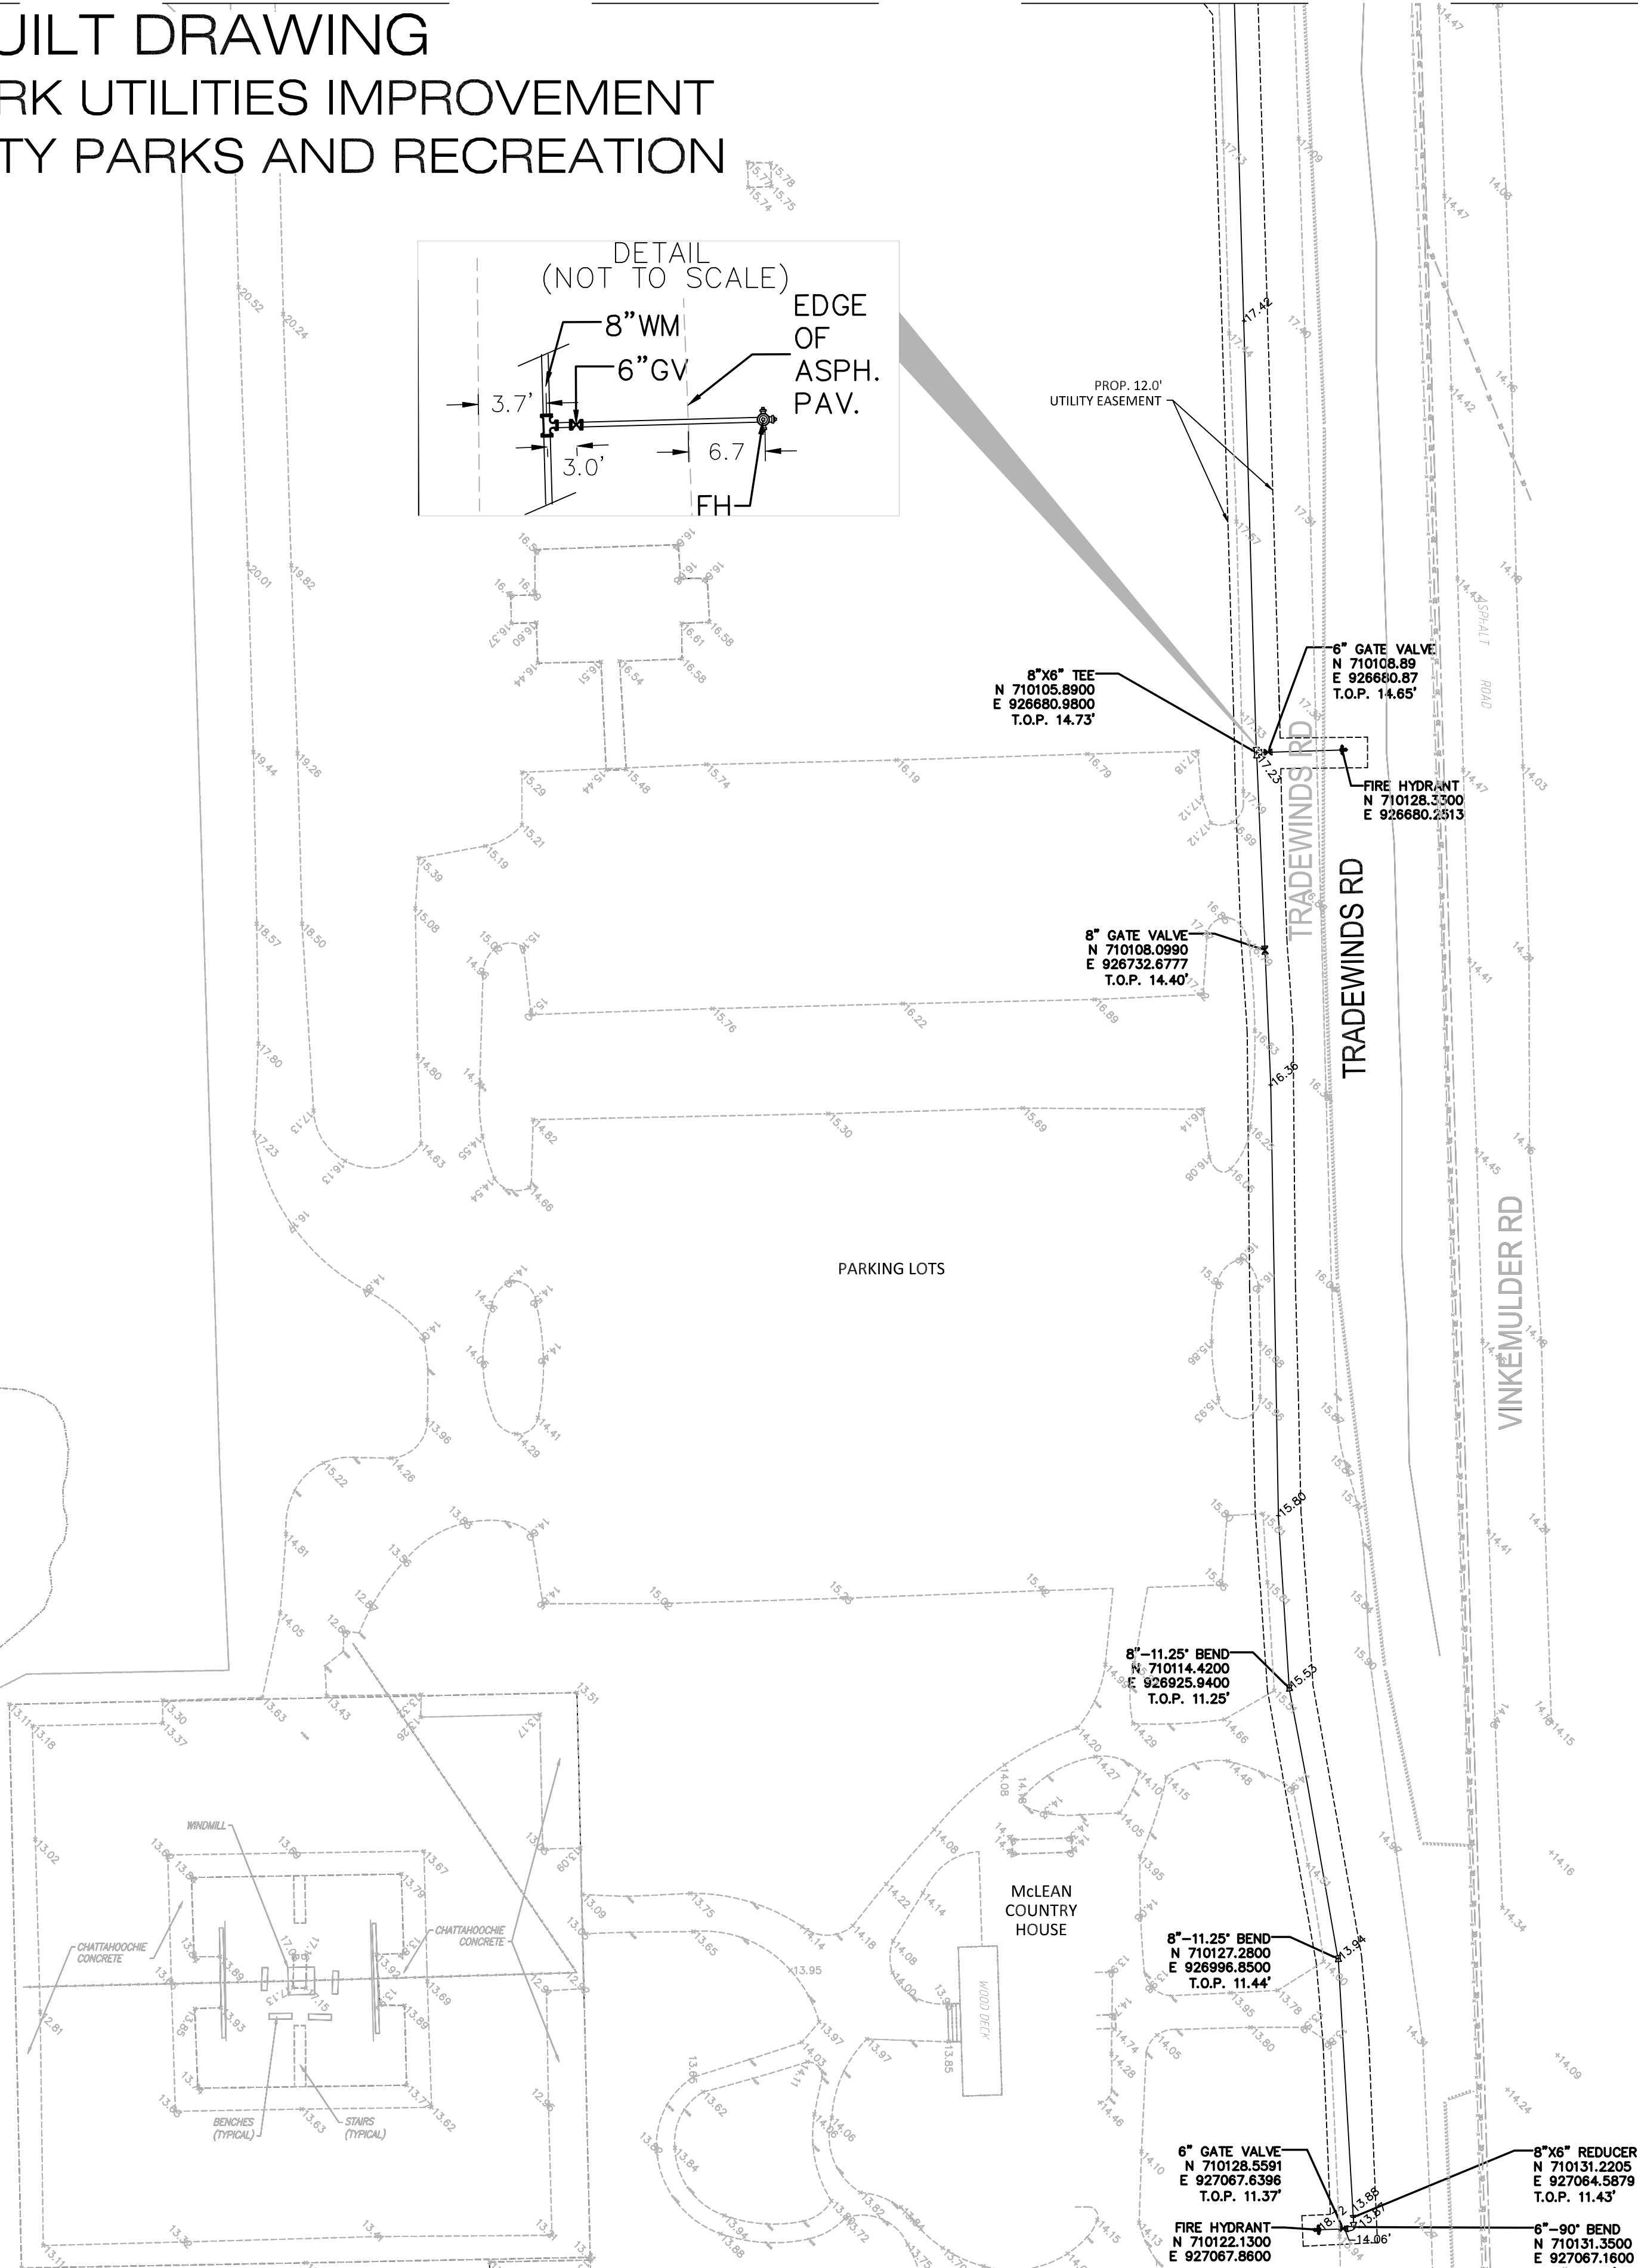

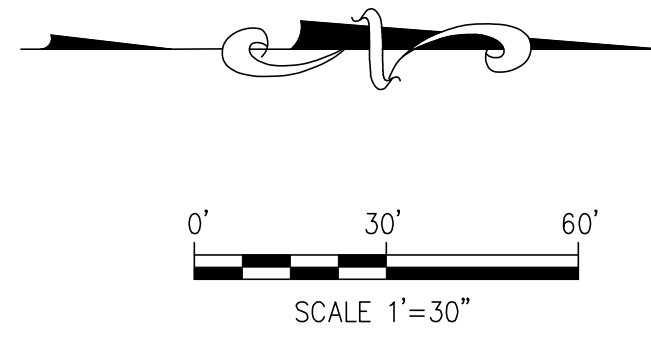

# SPECIFIC PURPOSE SURVEY

## AS BUILT DRAWING


### TRADEWINDS PARK UTILITIES IMPROVEMENT

### BROWARD COUNTY PARKS AND RECREATION

PROJECT No. R1423108P1  
8" D.I.P. WATER MAIN




MATCHLINE SHEET C-3

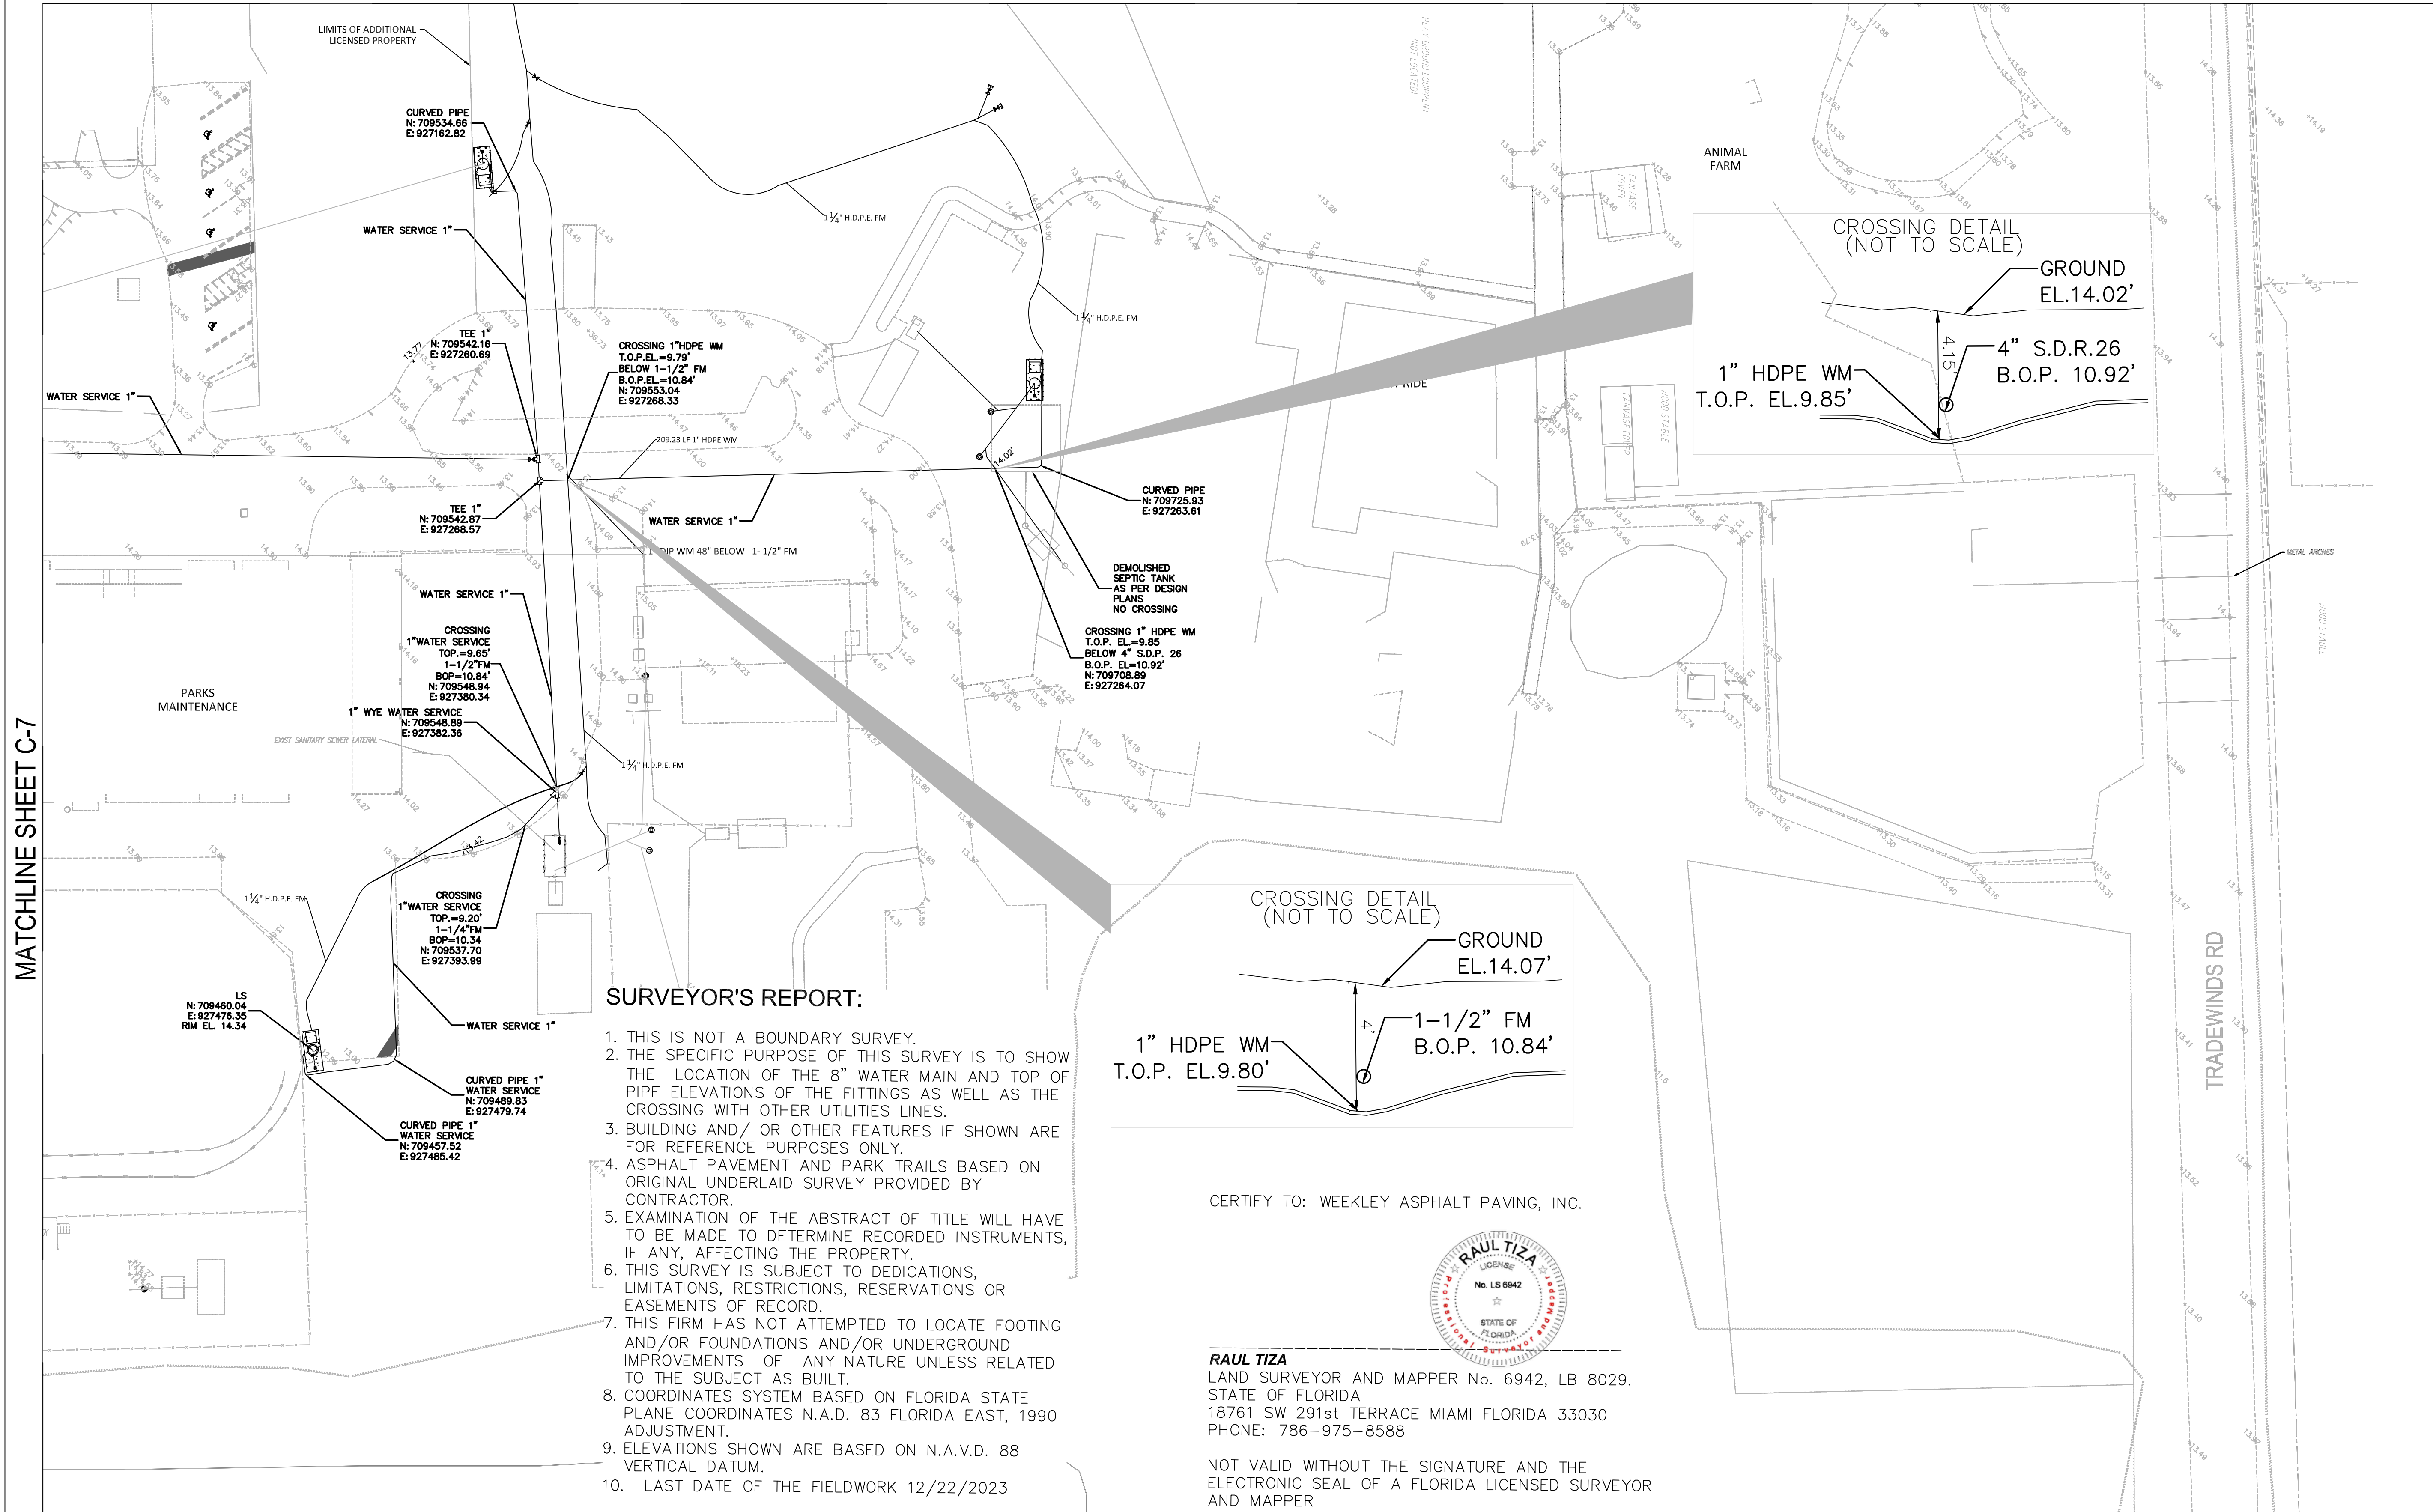

MATCHLINE SHEET C-7


AS BUILT PLANS  
SHEET C-4

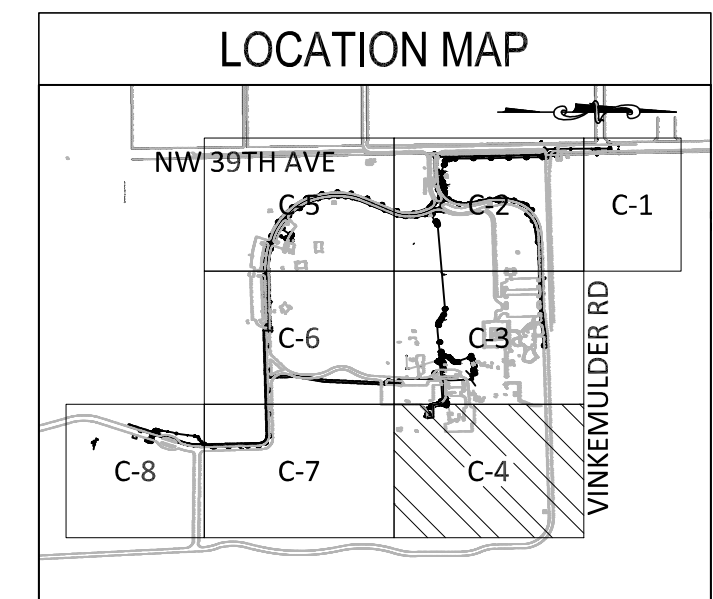

**SURVEYOR'S REPORT:**

1. THIS IS NOT A BOUNDARY SURVEY.
2. THE SPECIFIC PURPOSE OF THIS SURVEY IS TO SHOW THE LOCATION OF THE 8" WATER MAIN AND TOP OF PIPE ELEVATIONS OF THE FITTINGS AS WELL AS THE CROSSING WITH OTHER UTILITIES LINES.
3. BUILDING AND/ OR OTHER FEATURES IF SHOWN ARE FOR REFERENCE PURPOSES ONLY.
4. ASPHALT PAVEMENT AND PARK TRAILS BASED ON ORIGINAL UNDERLAID SURVEY PROVIDED BY CONTRACTOR.
5. EXAMINATION OF THE ABSTRACT OF TITLE WILL HAVE TO BE MADE TO DETERMINE RECORDED INSTRUMENTS, IF ANY, AFFECTING THE PROPERTY.
6. THIS SURVEY IS SUBJECT TO DEDICATIONS, LIMITATIONS, RESTRICTIONS, RESERVATIONS OR EASEMENTS OF RECORD.
7. THIS FIRM HAS NOT ATTEMPTED TO LOCATE FOOTING AND/OR FOUNDATIONS AND/OR UNDERGROUND IMPROVEMENTS OF ANY NATURE UNLESS RELATED TO THE SUBJECT AS BUILT.
8. COORDINATES SYSTEM BASED ON FLORIDA STATE PLANE COORDINATES N.A.D. 83 FLORIDA EAST, 1990 ADJUSTMENT.
9. ELEVATIONS SHOWN ARE BASED ON N.A.V.D. 88 VERTICAL DATUM.
10. LAST DATE OF THE FIELDWORK 12/22/2023

CERTIFY TO: WEEKLEY ASPHALT PAVING, INC.

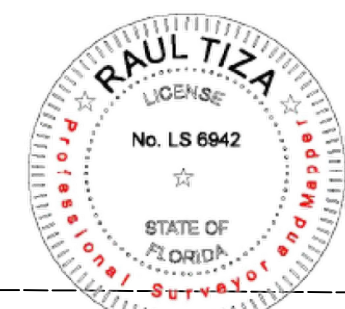

**RAUL TIZA**  
LAND SURVEYOR AND MAPPER No. 6942, LB 8029.  
STATE OF FLORIDA  
18761 SW 291st TERRACE MIAMI FLORIDA 33030  
PHONE: 786-975-8588

NOT VALID WITHOUT THE SIGNATURE AND THE ELECTRONIC SEAL OF A FLORIDA LICENSED SURVEYOR AND MAPPER

**LEGEND**

BOP	BOTTOM OF PIPE
BOT	BOTTOM
BSP	BACTERIAL SAMPLING POINT
BU	BUBBLE UP STRUCTURE
CB	CATCH BASIN
CE	CONTROL ELEVATION
CLEAR	CLEARANCE
CMH	CONFLICT MANHOLE
CMP	CORRUGATED METAL PIPE
CONC	CONCRETE
CS	CONTROL STRUCTURE
DDCV	DOUBLE DETECTOR CHECK VALVE
DIP	DUCTILE IRON PIPE
DR	DRAINAGE
ELEV	ELEVATION
EXIST	EXISTING
FDC	FIRE DEPARTMENT CONNECTION
FFE	FINISHED FLOOR ELEVATION
FH	FIRE HYDRANT
FT	FEET
GV	GATE VALVE
GRD	FINISH GRADE
HDPE	HIGH DENSITY POLYETHYLENE
HW	HEADWALL
IE	INVERT ELEVATION
INV	INVERT OF PIPE
LF	LINEAR FEET
MAS	MAINTENANCE ACCESS STRUCTURE
NAVD	NORTH AMERICAN VERTICAL DATUM
OUT	OUTFALL
PL	PROPERTY LINE
PVC	POLYVINYL CHLORIDE PIPE
PROP	PROPOSED
RE	RIM ELEVATION
RIM	RIM OF STRUCTURE
RCP	REINFORCED CONCRETE PIPE
RPZ	REDUCED PRESSURE ZONE BACKFLOW PREVENTER
R/W	RIGHT OF WAY
STR	STRUCTURE
TOP	TOP OF PIPE
TYP	TYPICAL
WM	WATER MAIN
W/	WITH
YD	YARD DRAIN
	EXIST GRADE (FT-NAVD)
	PROP GRADE (FT-NAVD)
	ASPHALT PAVEMENT
	TO BE REMOVED CONFLICT MARKER
	TO BE REMOVED CHAIN LINK FENCE
	DECORATIVE FENCE
	PROPERTY LINE
	EASEMENT LINE
	R/W LINE


# SPECIFIC PURPOSE SURVEY

## AS BUILT DRAWING


### TRADEWINDS PARK UTILITIES IMPROVEMENT

### BROWARD COUNTY PARKS AND RECREATION

PROJECT No. R1423108P1  
8" D.I.P. WATER MAIN

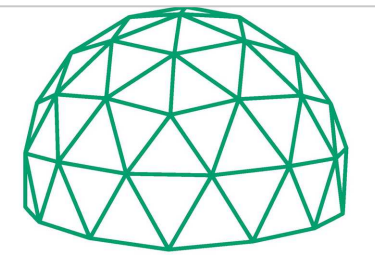


**RT GEOSOLUTIONS**  
A LAND SURVEYING COMPANY

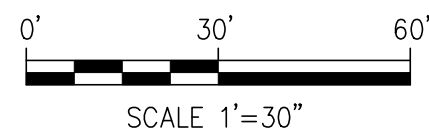

AS BUILT PLANS  
SHEET C-5


LOCATION MAP

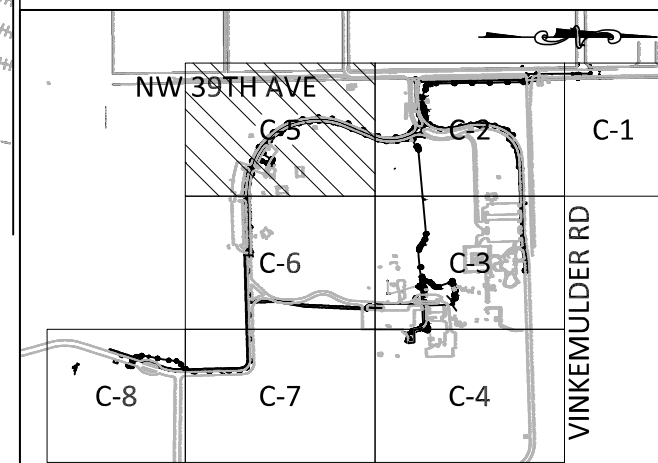

MATCHLINE SHEET C-2

#### SURVEYOR'S REPORT:


1. THIS IS NOT A BOUNDARY SURVEY.
2. THE SPECIFIC PURPOSE OF THIS SURVEY IS TO SHOW THE LOCATION OF THE 8" WATER MAIN AND TOP OF PIPE ELEVATIONS OF THE FITTINGS AS WELL AS THE CROSSING WITH OTHER UTILITIES LINES.
3. AS BUILT FEATURES IN BOLD
4. BUILDING AND/ OR OTHER FEATURES IF SHOWN ARE FOR REFERENCE PURPOSES ONLY.
5. ASPHALT PAVEMENT AND PARK TRAILS BASED ON ORIGINAL UNDERLAID SURVEY PROVIDED BY CONTRACTOR.
6. EXAMINATION OF THE ABSTRACT OF TITLE WILL HAVE TO BE MADE TO DETERMINE RECORDED INSTRUMENTS, IF ANY, AFFECTING THE PROPERTY.
7. THIS SURVEY IS SUBJECT TO DEDICATIONS, LIMITATIONS, RESTRICTIONS, RESERVATIONS OR EASEMENTS OF RECORD.
8. THIS FIRM HAS NOT ATTEMPTED TO LOCATE FOOTING AND/OR FOUNDATIONS AND/OR UNDERGROUND IMPROVEMENTS OF ANY NATURE UNLESS RELATED TO THE SUBJECT AS BUILT.
9. COORDINATES SYSTEM BASED ON FLORIDA STATE PLANE COORDINATES N.A.D. 83 FLORIDA EAST, 1990 ADJUSTMENT.
10. ELEVATIONS SHOWN ARE BASED ON N.A.V.D. 88 VERTICAL DATUM.
11. LAST DATE OF THE FIELDWORK 12/22/2023.

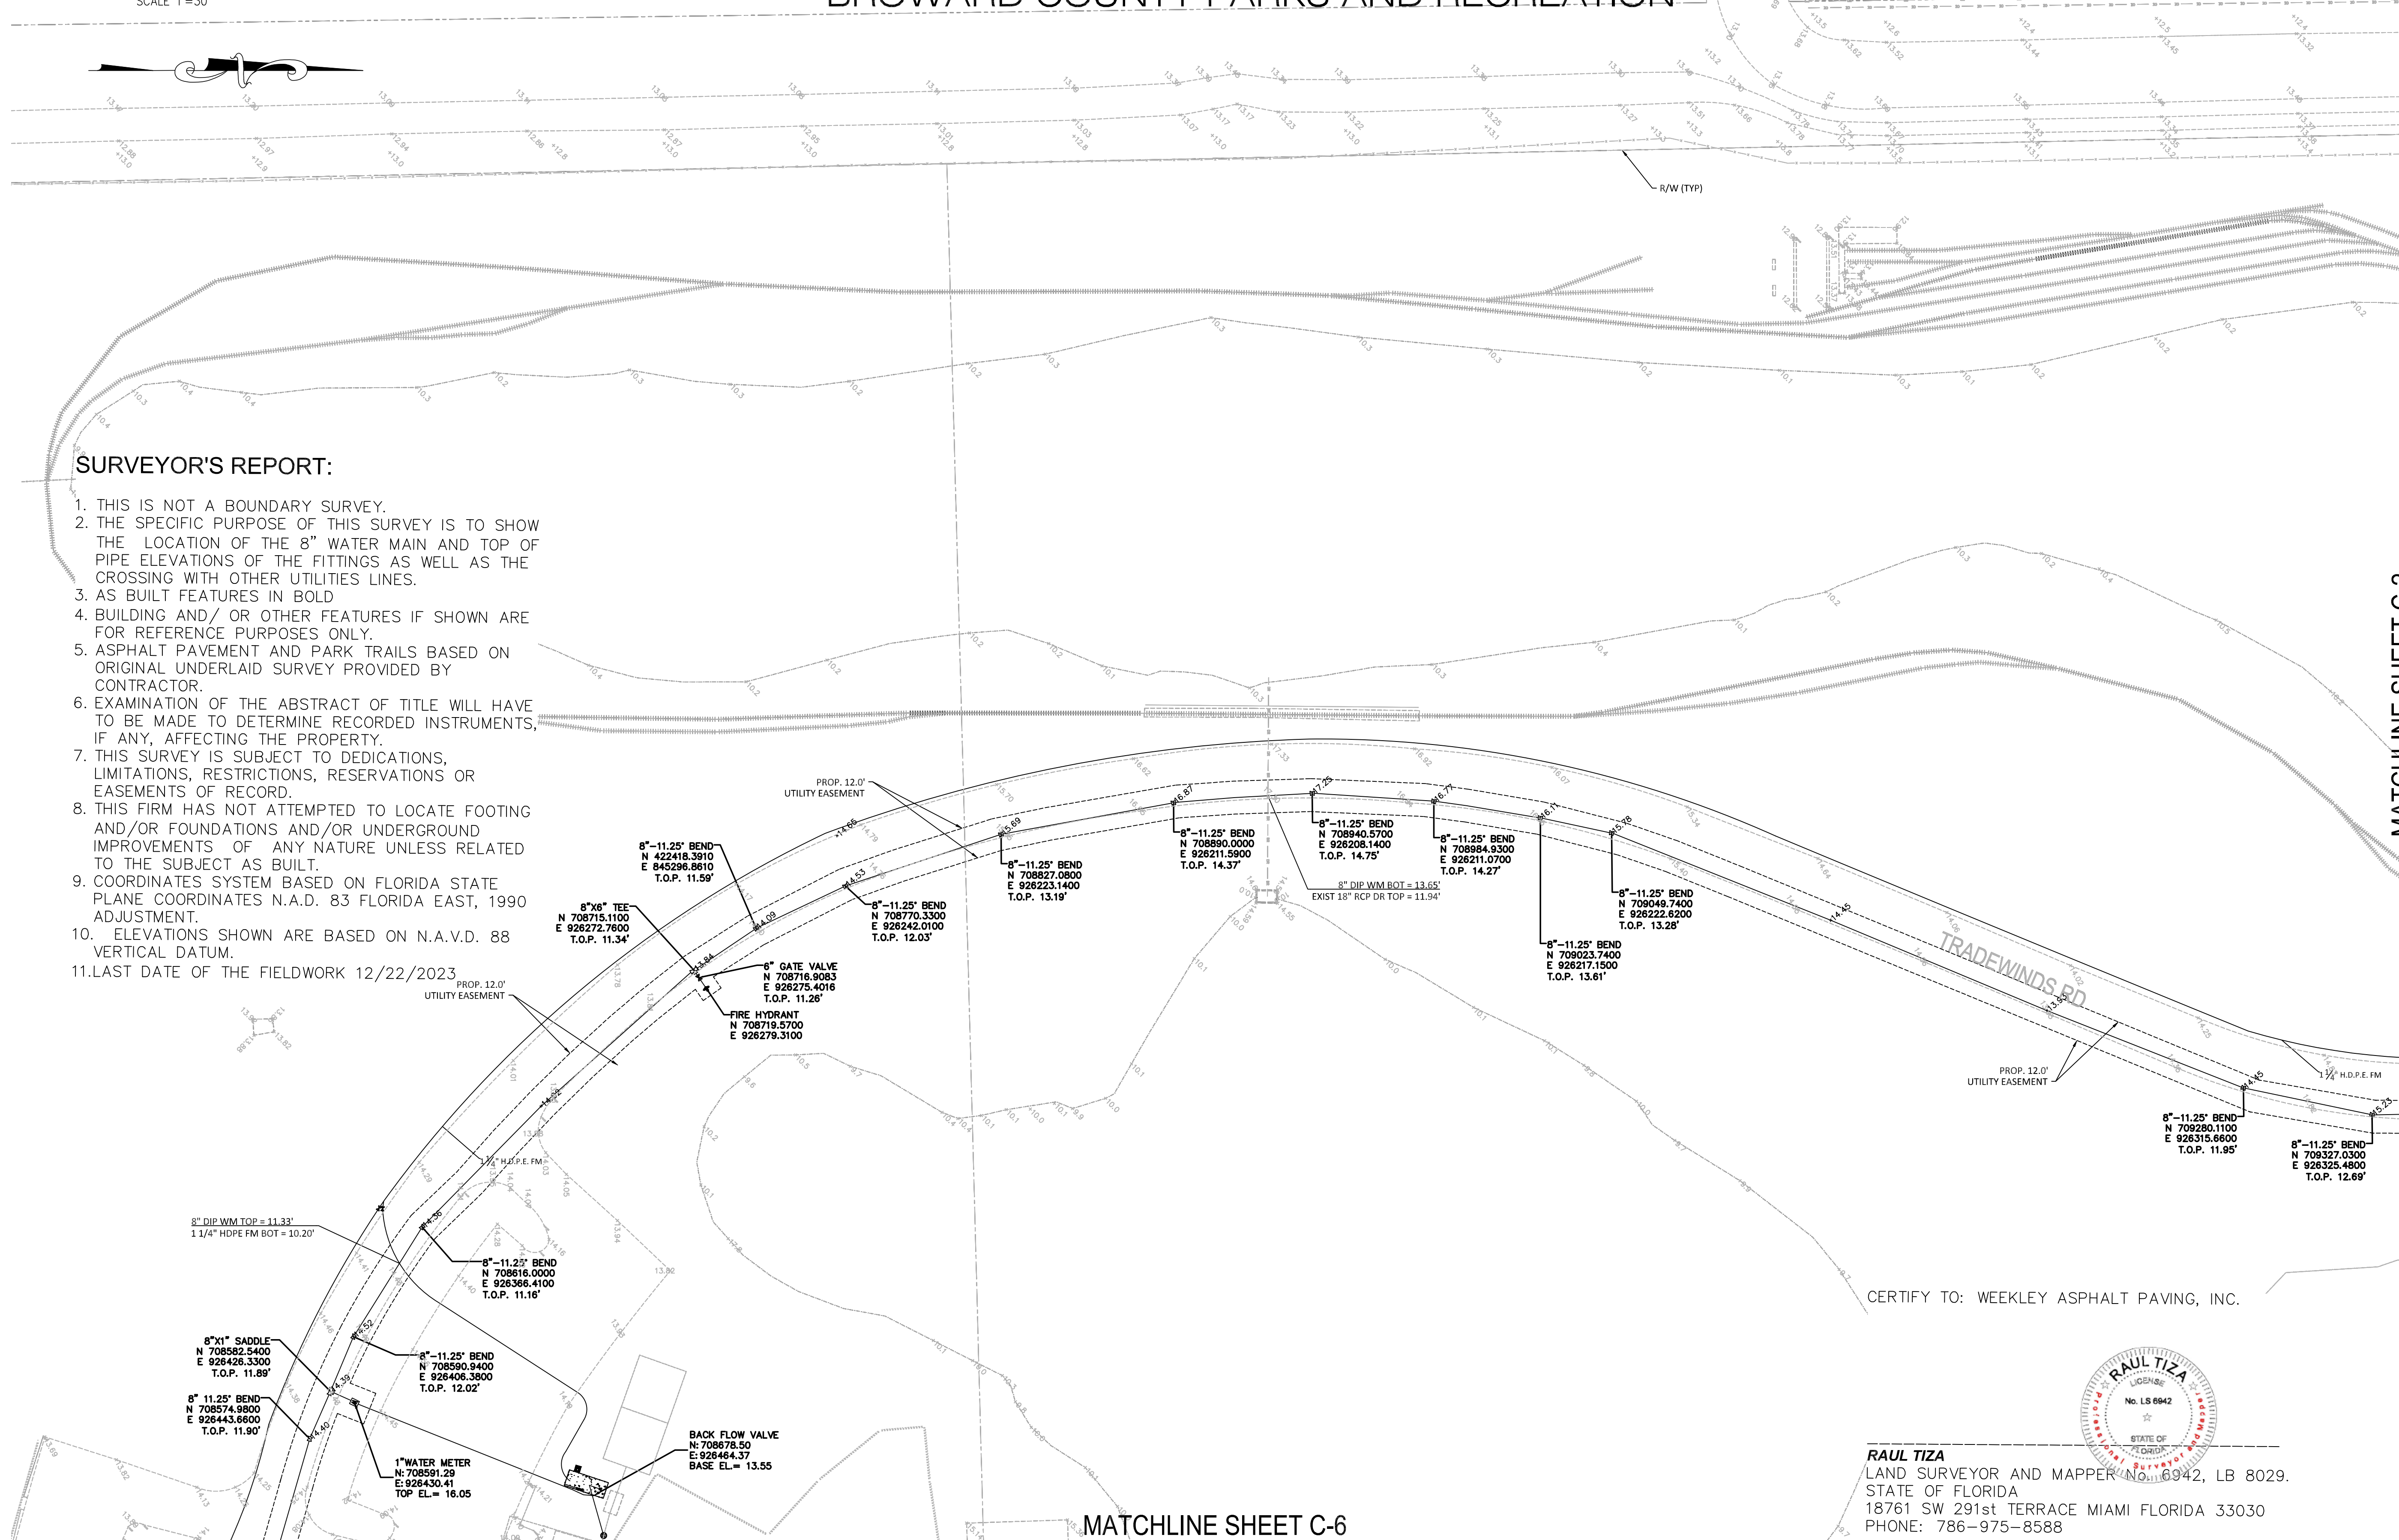

#### LEGEND

BOP	BOTTOM OF PIPE
BOT	BOTTOM
BSP	BACTERIAL SAMPLING POINT
BU	BURIED UP STRUCTURE
CB	CATCH BASIN
CE	CONTROL ELEVATION
CLEAR	CLEARANCE
CMH	CONFLICT MANHOLE
CMP	CORRUGATED METAL PIPE
CONC	CONCRETE
CS	CONTROL STRUCTURE
DDCV	DOUBLE DETECTOR CHECK VALVE
DIP	DUCTILE IRON PIPE
DR	DRAINAGE
ELEV	ELEVATION
EXIST	EXISTING
EXIST	EXISTING CONNECTION
FDC	FIRE DEPARTMENT CONNECTION
FFE	FINISHED FLOOR ELEVATION
FH	FIRE HYDRANT
FT	FEET
GV	GATE VALVE
GRD	FINISH GRADE
HDPE	HIGH DENSITY POLYETHYLENE
HW	HEADWALL
IE	INVERT ELEVATION
INV	INVERT OF PIPE
LF	LINEAR FEET
MAS	MAINTENANCE ACCESS STRUCTURE
NAVD	NORTH AMERICAN VERTICAL DATUM
OUT	OUTFALL
PL	PROPERTY LINE
PVC	POLYVINYL CHLORIDE PIPE
PROP	PROPOSED
RE	RIM ELEVATION
RIM	RIM OF STRUCTURE
RCP	REINFORCED CONCRETE PIPE
RPZ	REDUCED PRESSURE ZONE BACKFLOW PREVENTER
R/W	RIGHT OF WAY
STR	STRUCTURE
TOP	TOP OF PIPE
TYP	TYPICAL
WM	WATER MAIN
W/	WITH
YD	YARD DRAIN

CERTIFY TO: WEEKLEY ASPHALT PAVING, INC.

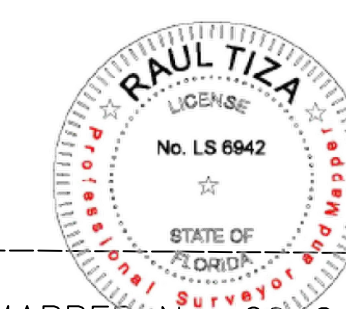

**RAUL TIZA**  
LAND SURVEYOR AND MAPPER No. 6942, LB 8029.  
STATE OF FLORIDA  
18761 SW 291st TERRACE MIAMI FLORIDA 33030  
PHONE: 786-975-8588

NOT VALID WITHOUT THE SIGNATURE AND THE ELECTRONIC SEAL OF A FLORIDA LICENSED SURVEYOR AND MAPPER

MATCHLINE SHEET C-6


# SPECIFIC PURPOSE SURVEY

## AS BUILT DRAWING

### TRADEWINDS PARK UTILITIES IMPROVEMENT

### BROWARD COUNTY PARKS AND RECREATION



PROJECT No. R1423108P1  
8" D.I.P. WATER MAIN

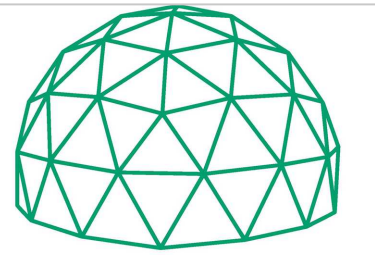


**RT GEOSOLUTIONS**  
A LAND SURVEYING COMPANY

AS BUILT PLANS  
SHEET C-6

LOCATION MAP

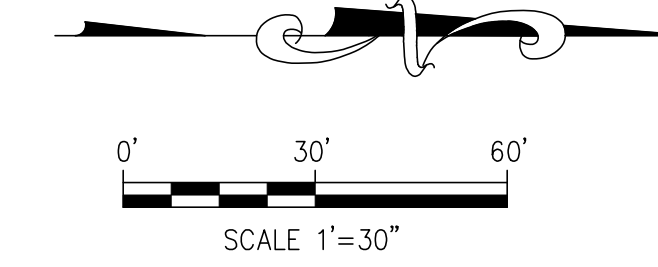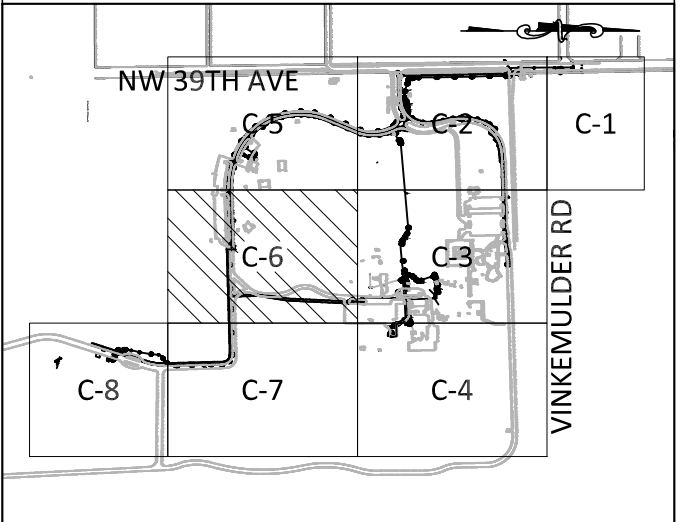

MATCHLINE SHEET C-3

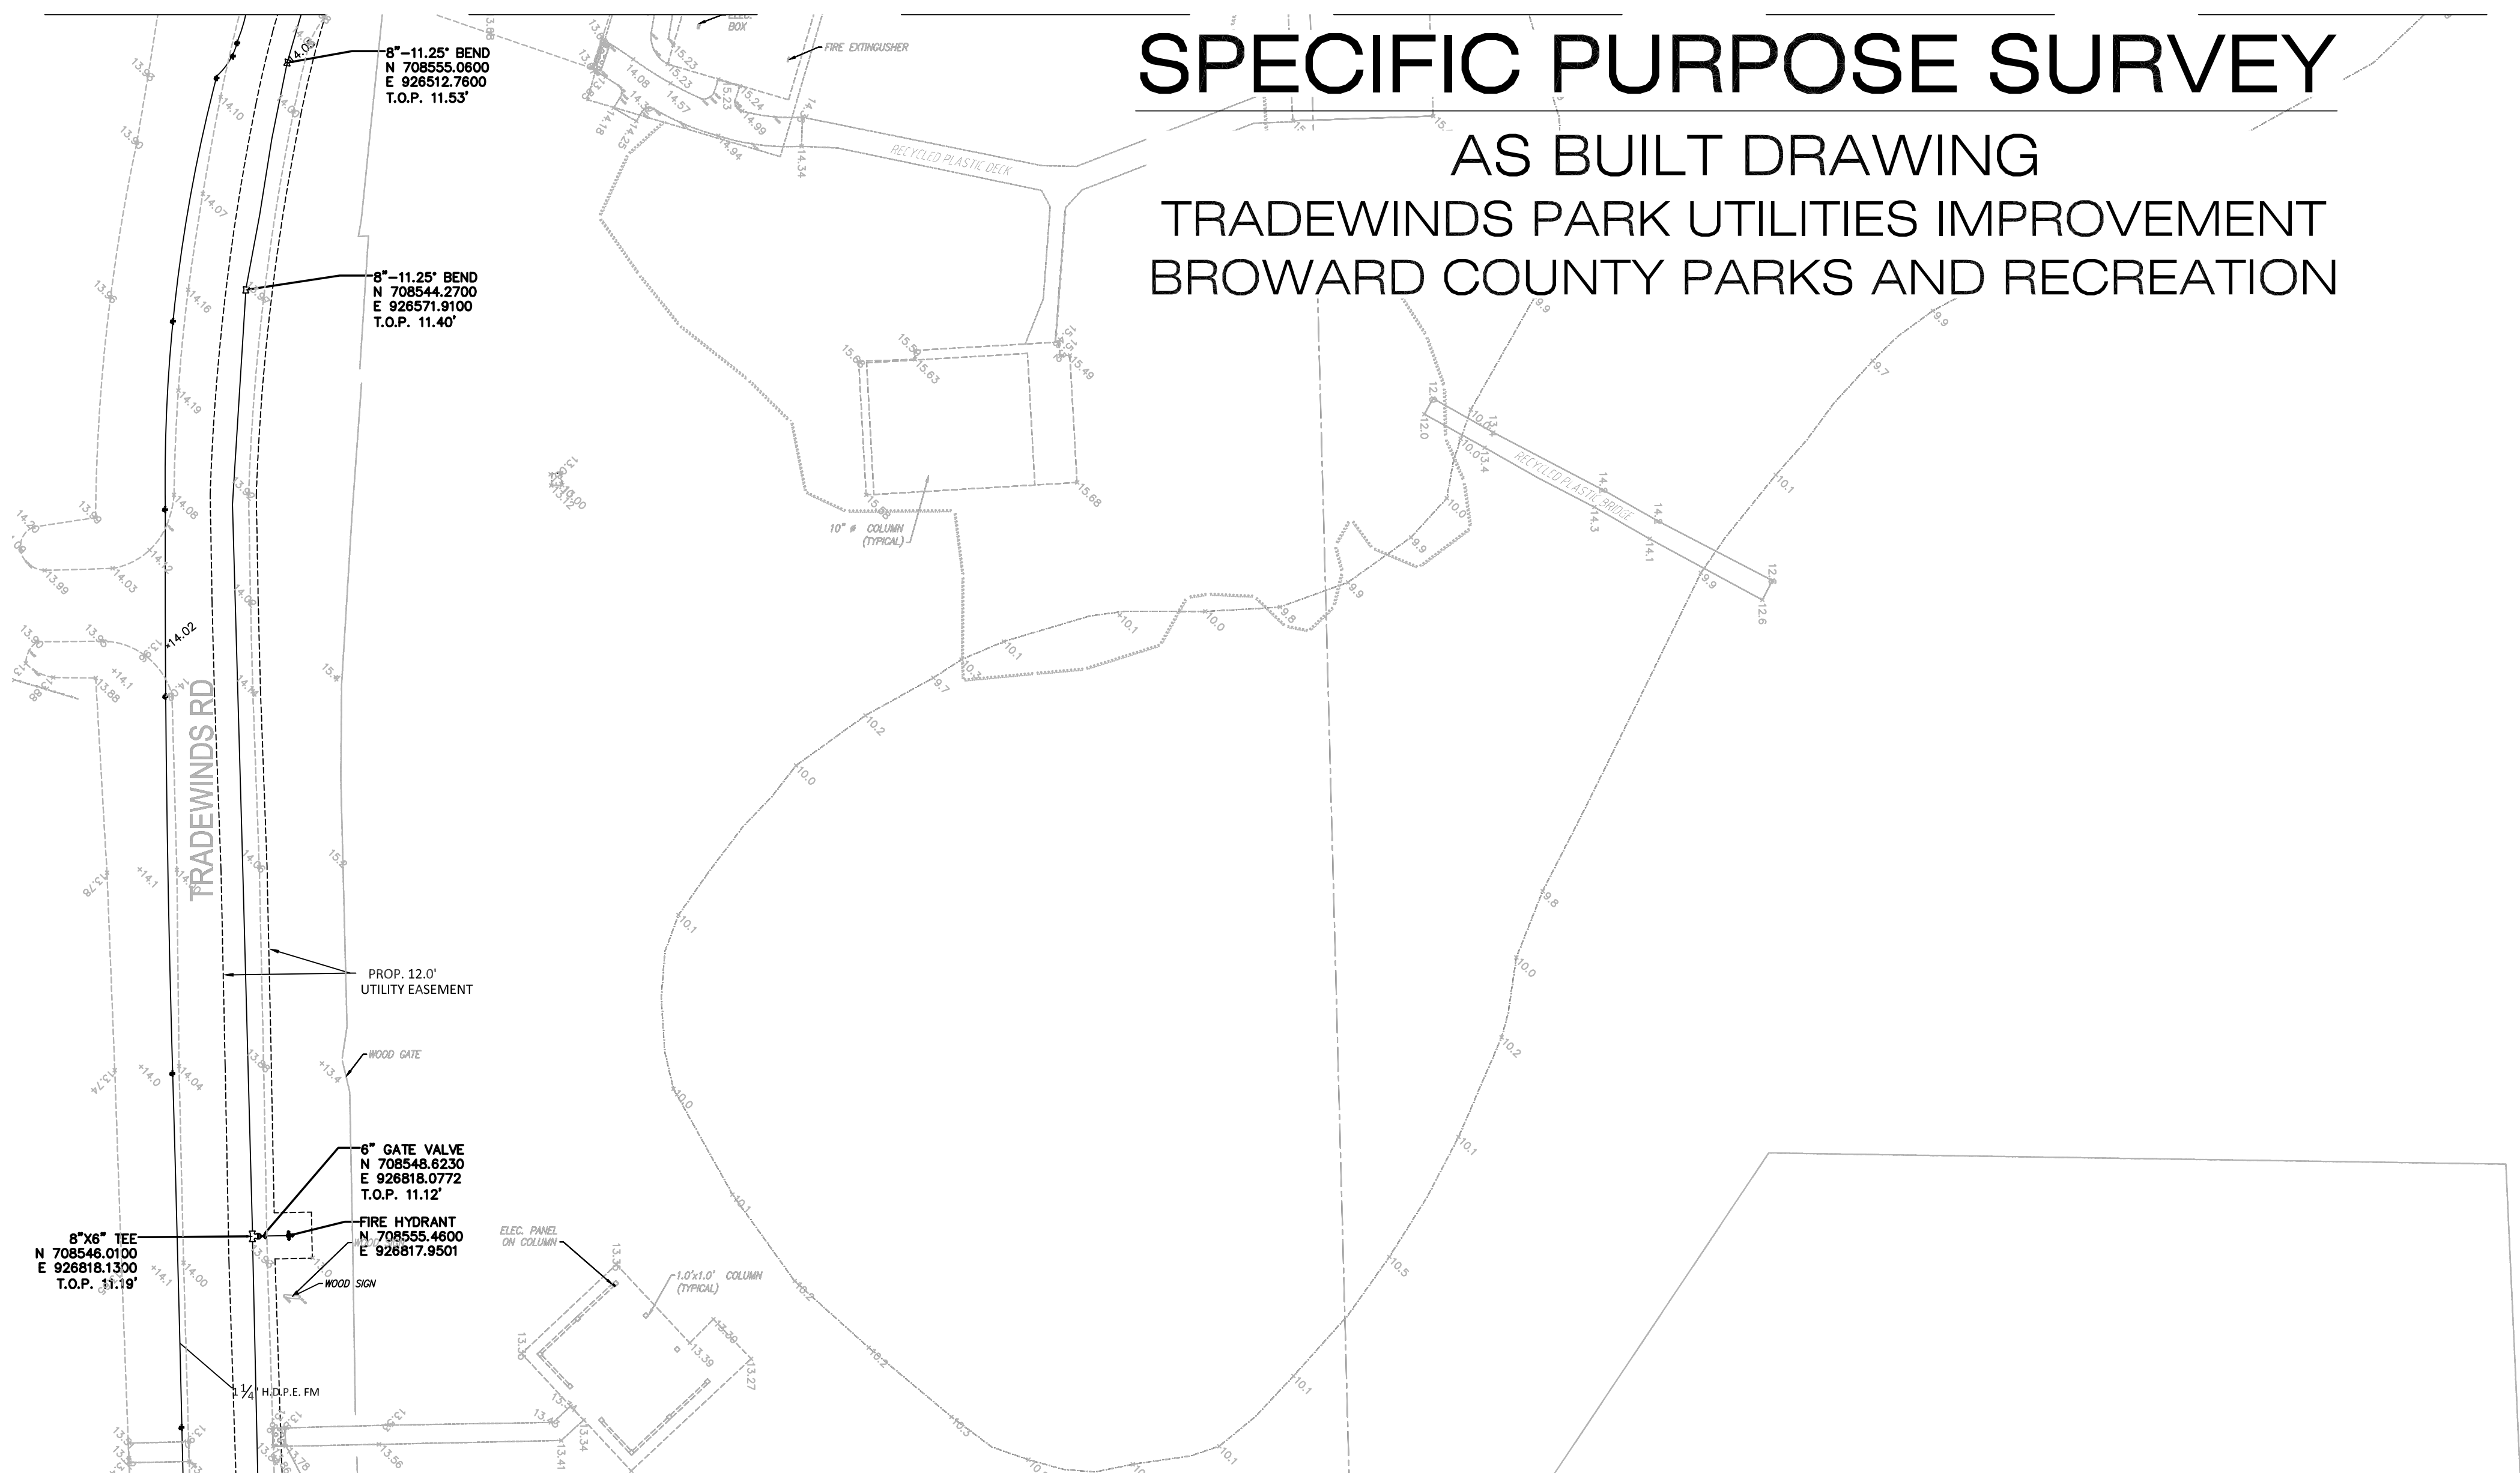


**SURVEYOR'S REPORT:**

1. THIS IS NOT A BOUNDARY SURVEY.
2. THE SPECIFIC PURPOSE OF THIS SURVEY IS TO SHOW THE LOCATION OF THE 8" WATER MAIN AND TOP OF PIPE ELEVATIONS OF THE FITTINGS AS WELL AS THE CROSSING WITH OTHER UTILITIES LINES.
3. AS BUILT FEATURES IN BOLD.
4. BUILDING AND/ OR OTHER FEATURES IF SHOWN ARE FOR REFERENCE PURPOSES ONLY.
5. ASPHALT PAVEMENT AND PARK TRAILS BASED ON ORIGINAL UNDERLAID SURVEY PROVIDED BY CONTRACTOR.
6. EXAMINATION OF THE ABSTRACT OF TITLE WILL HAVE TO BE MADE TO DETERMINE RECORDED INSTRUMENTS, IF ANY, AFFECTING THE PROPERTY.
7. THIS SURVEY IS SUBJECT TO DEDICATIONS, LIMITATIONS, RESTRICTIONS, RESERVATIONS OR EASEMENTS OF RECORD.
8. THIS FIRM HAS NOT ATTEMPTED TO LOCATE FOOTING AND/OR FOUNDATIONS AND/OR UNDERGROUND IMPROVEMENTS OF ANY NATURE UNLESS RELATED TO THE SUBJECT AS BUILT.
9. COORDINATES SYSTEM BASED ON FLORIDA STATE PLANE COORDINATES N.A.D. 83 FLORIDA EAST, 1990 ADJUSTMENT.
10. ELEVATIONS SHOWN ARE BASED ON N.A.V.D. 88 VERTICAL DATUM.
11. LAST DATE OF THE FIELDWORK 12/22/2023

MATCHLINE SHEET C-7

CERTIFY TO: WEEKLEY ASPHALT PAVING, INC.

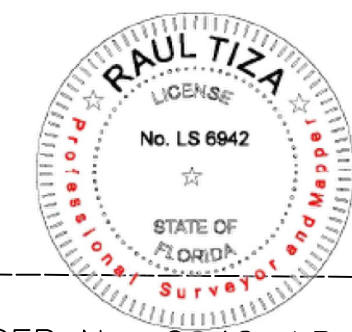

**RAUL TIZA**  
LAND SURVEYOR AND MAPPER No. 6942, LB 8029.  
STATE OF FLORIDA  
18761 SW 291st TERRACE MIAMI FLORIDA 33030  
PHONE: 786-975-8588

NOT VALID WITHOUT THE SIGNATURE AND THE ELECTRONIC SEAL OF A FLORIDA LICENSED SURVEYOR AND MAPPER

**LEGEND**

BOP	BOTTOM OF PIPE
BOT	BOTTOM
BSP	BACTERIAL SAMPLING POINT
BU	BUBBLE UP STRUCTURE
CB	CATCH BASIN
CE	CONTROL ELEVATION
CLEAR	CLEARANCE
CMH	CONFLICT MANHOLE
CMP	CORRUGATED METAL PIPE
CONC	CONCRETE
CS	CONTROL STRUCTURE
DDCV	DOUBLE DETECTOR CHECK VALVE
DIP	DUCTILE IRON PIPE
DR	DRAINAGE
ELEV	ELEVATION
EXIST	EXISTING
FDC	FIRE DEPARTMENT CONNECTION
FFE	FINISHED FLOOR ELEVATION
FH	FIRE HYDRANT
FT	FEET
GV	GATE VALVE
GRID	FINISH GRADE
HDPE	HIGH DENSITY POLYETHYLENE
HW	HEADWALL
IE	INVERT ELEVATION
INV	INVERT OF PIPE
LF	LINEAR FEET
MAS	MAINTENANCE ACCESS STRUCTURE
NAVD	NORTH AMERICAN VERTICAL DATUM
OUT	OUTFALL
PL	PROPERTY LINE
PVC	POLYVINYL CHLORIDE PIPE
PROP	PROPOSED
RE	RIM ELEVATION
RIM	RIM OF STRUCTURE
RCP	REINFORCED CONCRETE PIPE
RPZ	REDUCED PRESSURE ZONE BACKFLOW PREVENTER
R/W	RIGHT OF WAY
STR	STRUCTURE
TOP	TOP OF PIPE
TYP	TYPICAL
WM	WATER MAIN
W/	WITH
YD	YARD DRAIN
EXIST GRADE (FT-NAVD)	
PROP GRADE (FT-NAVD)	
ASPHALT PAVEMENT	
TO BE REMOVED	
CONFLICT MARKER	
TO BE REMOVED	
CHAIN LINK FENCE	
DECORATIVE FENCE	
PROPERTY LINE	
EASEMENT LINE	
R/W LINE	


# SPECIFIC PURPOSE SURVEY

AS BUILT DRAWING


MATCHLINE SHEET C-6

PROJECT No. R1423108P1  
8" D.I.P. WATER MAIN

TRADEWINDS PARK UTILITIES IMPROVEMENT  
BROWARD COUNTY PARKS AND RECREATION

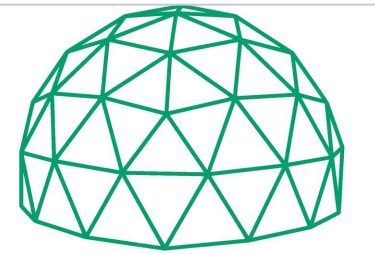



**RT GEOSOLUTIONS**  
A LAND SURVEYING COMPANY

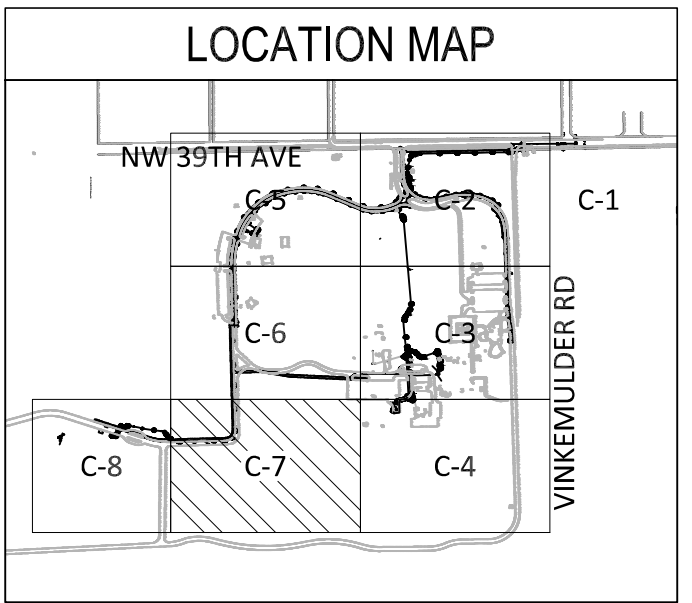

AS BUILT PLANS  
SHEET C-7

MATCHLINE SHEET C-8

MATCHLINE SHEET C-4

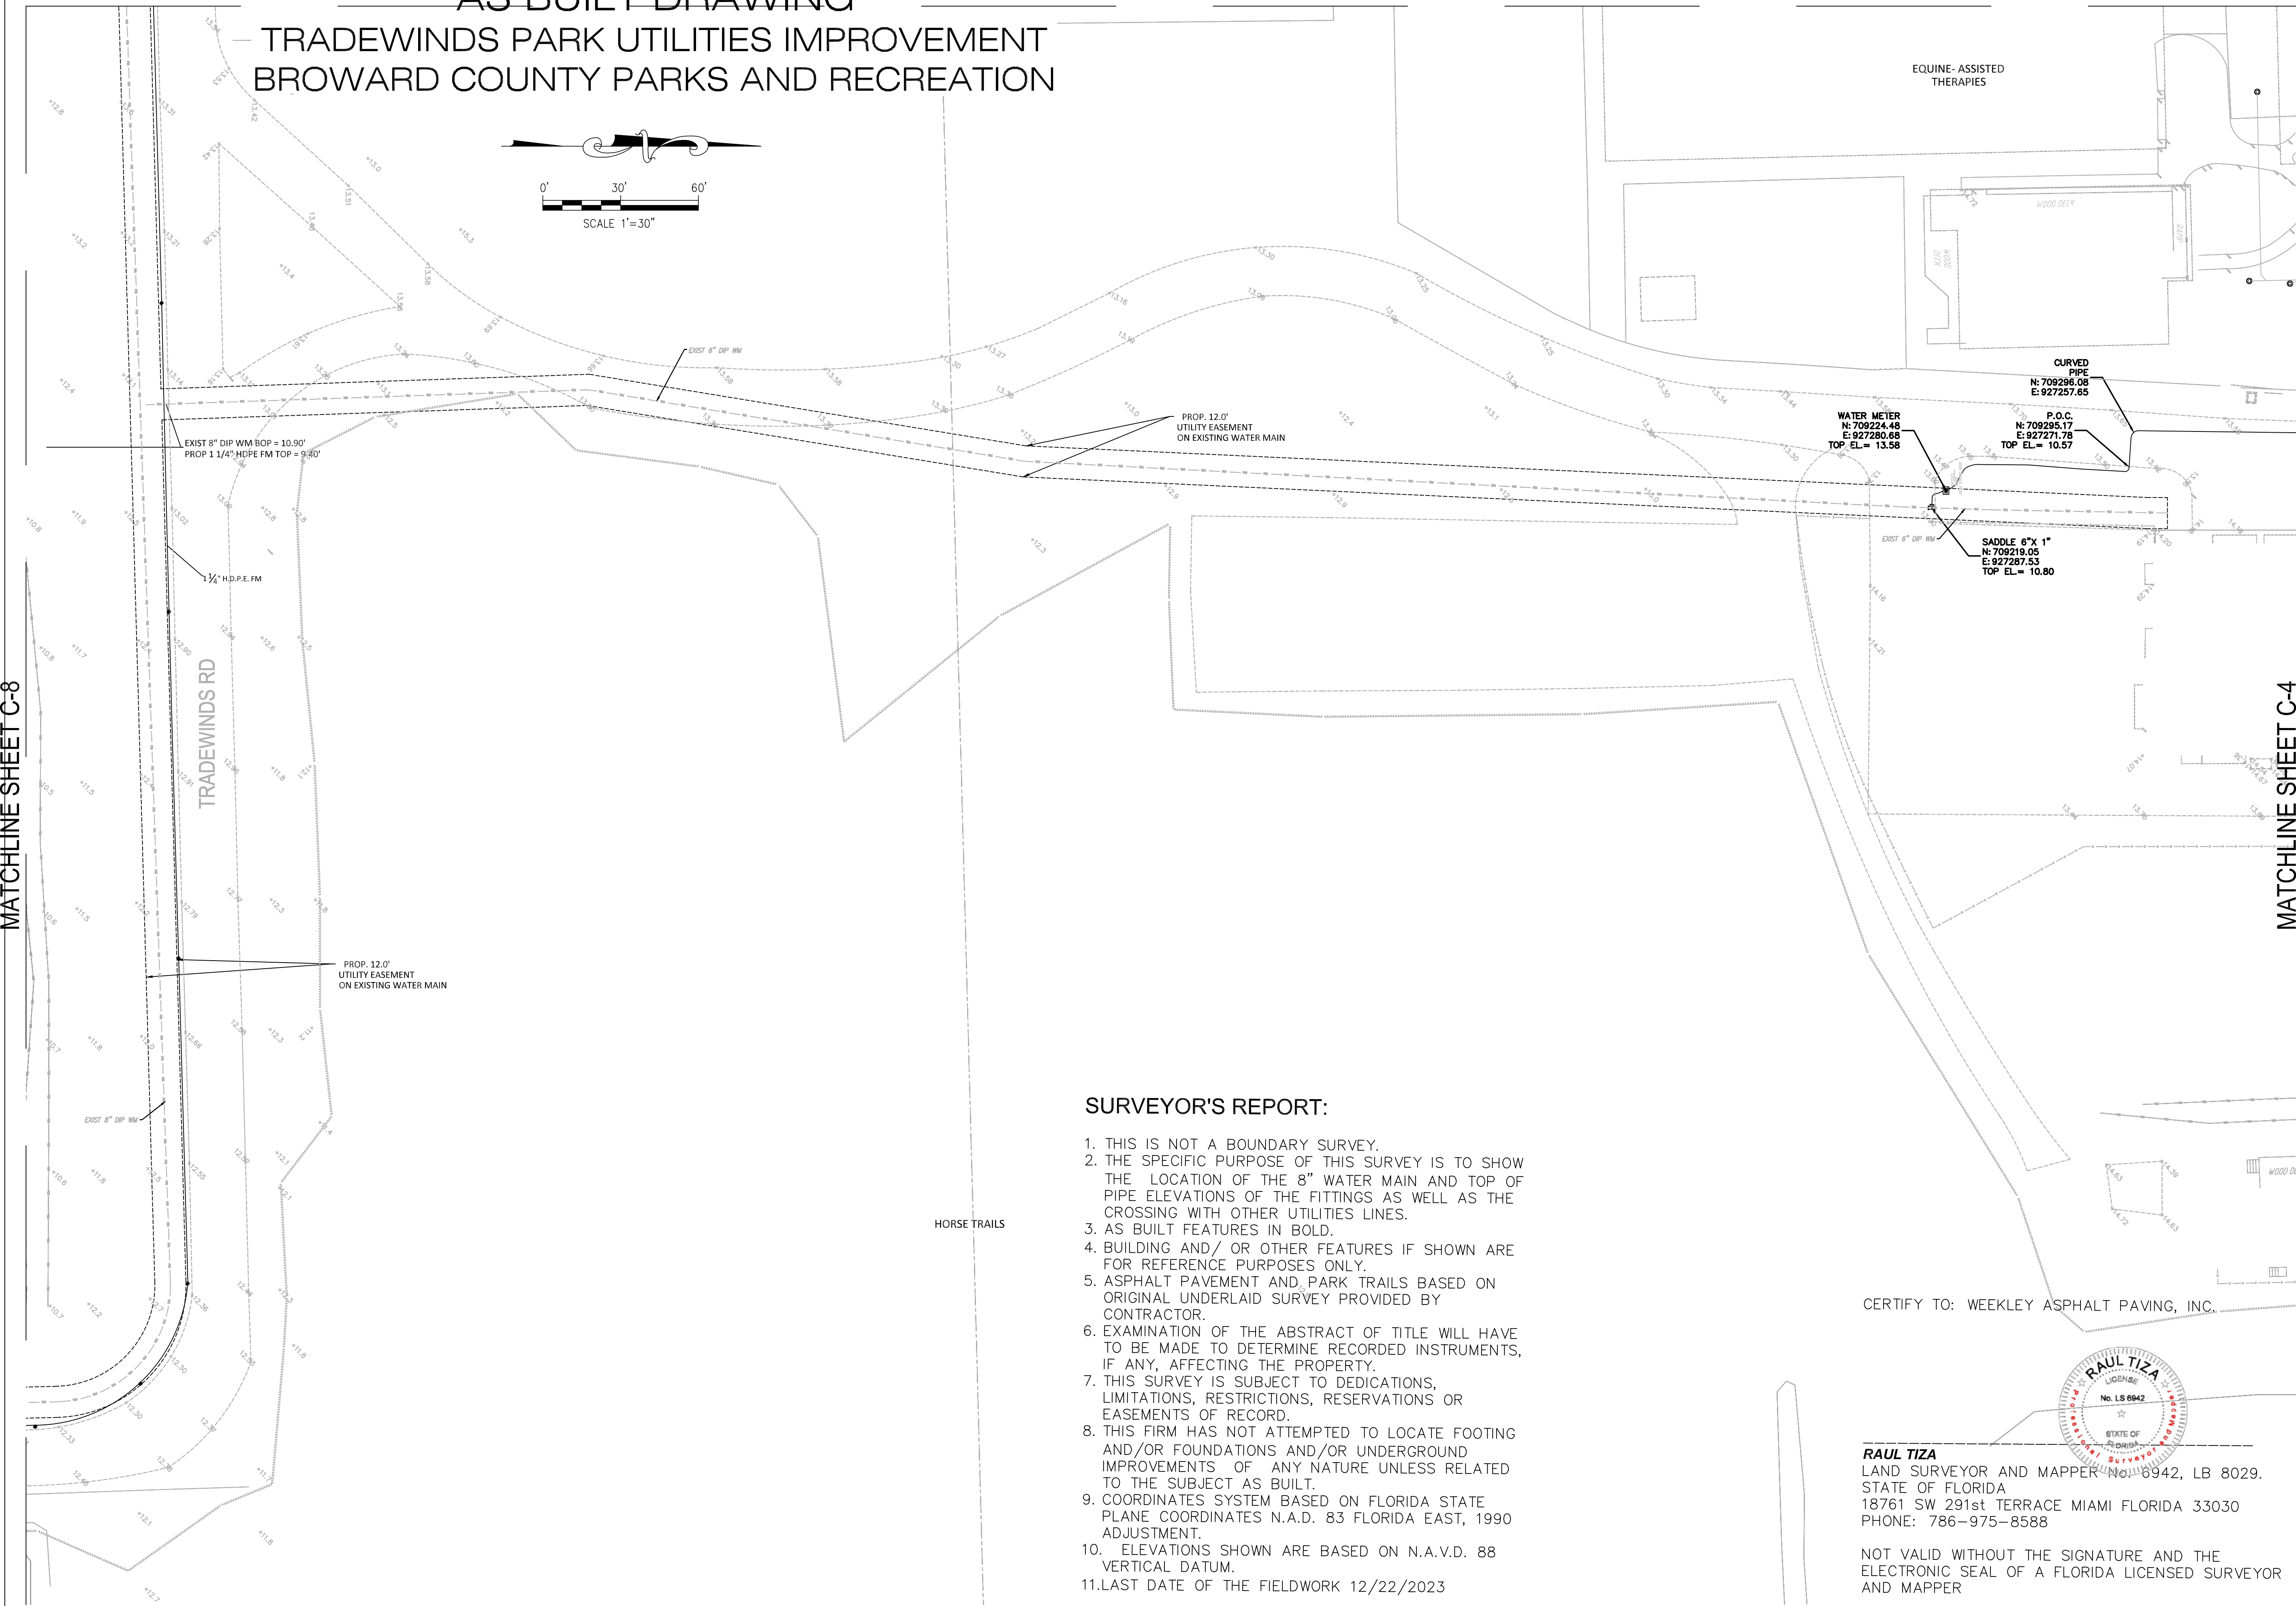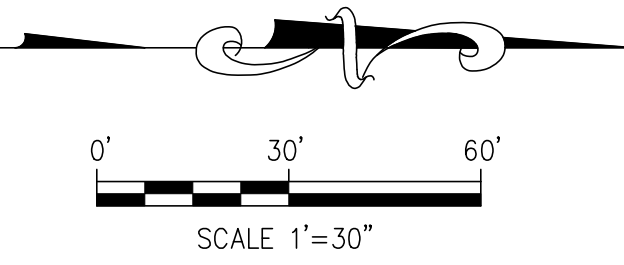

**LEGEND**

BOP	BOTTOM OF PIPE
BOT	BOTTOM
BSP	BACTERIAL SAMPLING POINT
BU	BUBBLE UP STRUCTURE
CB	CATCH BASIN
CE	CONTROL ELEVATION
CLEAR	CLEARANCE
CMH	CONFLICT MANHOLE
CMP	CORRUGATED METAL PIPE
CONC	CONCRETE
CS	CONTROL STRUCTURE
DDCV	DOUBLE DETECTOR CHECK VALVE
DIP	DUCTILE IRON PIPE
DR	DRAINAGE
ELEV	ELEVATION
EXIST	EXISTING
FDC	FIRE DEPARTMENT CONNECTION
FFE	FINISHED FLOOR ELEVATION
FH	FIRE HYDRANT
FT	FEET
GV	GATE VALVE
GRD	FINISH GRADE
HDPE	HIGH DENSITY POLYETHYLENE
HW	HEADWALL
IE	INVERT ELEVATION
INV	INVERT OF PIPE
LF	LINEAR FEET
MAS	MAINTENANCE ACCESS STRUCTURE
NAVD	NORTH AMERICAN VERTICAL DATUM
OUT	OUTFALL
±	PROPERTY LINE
PVC	POLYVINYL CHLORIDE PIPE
PROP	PROPOSED
RE	RIM ELEVATION
RIM	RIM OF STRUCTURE
RCP	REINFORCED CONCRETE PIPE
RPZ	REDUCED PRESSURE ZONE BACKFLOW PREVENTER
R/W	RIGHT OF WAY
STR	STRUCTURE
TOP	TOP OF PIPE
TYP	TYPICAL
WM	WATER MAIN
W/	WITH
YD	YARD DRAIN


  

	EXIST GRADE (FT-NAVD)
	PROP GRADE (FT-NAVD)
	ASPHALT PAVEMENT
	TO BE REMOVED CONFLICT MARKER
	TO BE REMOVED
	CHAIN LINK FENCE
	DECORATIVE FENCE
	PROPERTY LINE
	EASEMENT LINE
	R/W LINE

**SURVEYOR'S REPORT:**

1. THIS IS NOT A BOUNDARY SURVEY.
2. THE SPECIFIC PURPOSE OF THIS SURVEY IS TO SHOW THE LOCATION OF THE 8" WATER MAIN AND TOP OF PIPE ELEVATIONS OF THE FITTINGS AS WELL AS THE CROSSING WITH OTHER UTILITIES LINES.
3. AS BUILT FEATURES IN BOLD.
4. BUILDING AND/ OR OTHER FEATURES IF SHOWN ARE FOR REFERENCE PURPOSES ONLY.
5. ASPHALT PAVEMENT AND PARK TRAILS BASED ON ORIGINAL UNDERLAID SURVEY PROVIDED BY CONTRACTOR.
6. EXAMINATION OF THE ABSTRACT OF TITLE WILL HAVE TO BE MADE TO DETERMINE RECORDED INSTRUMENTS, IF ANY, AFFECTING THE PROPERTY.
7. THIS SURVEY IS SUBJECT TO DEDICATIONS, LIMITATIONS, RESTRICTIONS, RESERVATIONS OR EASEMENTS OF RECORD.
8. THIS FIRM HAS NOT ATTEMPTED TO LOCATE FOOTING AND/OR FOUNDATIONS AND/OR UNDERGROUND IMPROVEMENTS OF ANY NATURE UNLESS RELATED TO THE SUBJECT AS BUILT.
9. COORDINATES SYSTEM BASED ON FLORIDA STATE PLANE COORDINATES N.A.D. 83 FLORIDA EAST, 1990 ADJUSTMENT.
10. ELEVATIONS SHOWN ARE BASED ON N.A.V.D. 88 VERTICAL DATUM.
11. LAST DATE OF THE FIELDWORK 12/22/2023

CERTIFY TO: WEEKLEY ASPHALT PAVING, INC.

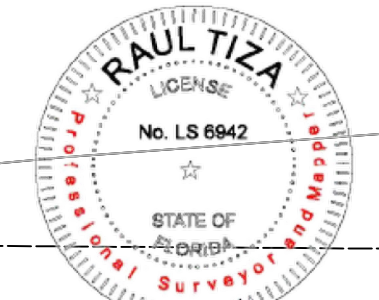

**RAUL TIZA**  
LAND SURVEYOR AND MAPPER No. 6842, LB 8029.  
STATE OF FLORIDA  
18761 SW 291st TERRACE MIAMI FLORIDA 33030  
PHONE: 786-975-8588

NOT VALID WITHOUT THE SIGNATURE AND THE ELECTRONIC SEAL OF A FLORIDA LICENSED SURVEYOR AND MAPPER


# SPECIFIC PURPOSE SURVEY

## AS BUILT DRAWING

### TRADEWINDS PARK UTILITIES IMPROVEMENT

### BROWARD COUNTY PARKS AND RECREATION

PROJECT No. R1423108P1  
8" D.I.P. WATER MAIN

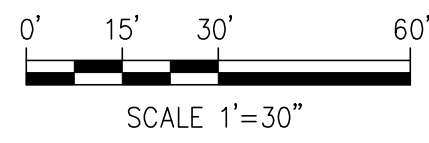


#### SURVEYOR'S REPORT:

1. THIS IS NOT A BOUNDARY SURVEY.
2. THE SPECIFIC PURPOSE OF THIS SURVEY IS TO SHOW THE LOCATION OF THE 8" WATER MAIN AND TOP OF PIPE ELEVATIONS OF THE FITTINGS AS WELL AS THE CROSSING WITH OTHER UTILITIES LINES.
3. BUILDING AND/ OR OTHER FEATURES IF SHOWN ARE FOR REFERENCE PURPOSES ONLY.
4. ASPHALT PAVEMENT AND PARK TRAILS BASED ON ORIGINAL UNDERLAID SURVEY PROVIDED BY CONTRACTOR.
5. EXAMINATION OF THE ABSTRACT OF TITLE WILL HAVE TO BE MADE TO DETERMINE RECORDED INSTRUMENTS, IF ANY, AFFECTING THE PROPERTY.
6. THIS SURVEY IS SUBJECT TO DEDICATIONS, LIMITATIONS, RESTRICTIONS, RESERVATIONS OR EASEMENTS OF RECORD.
7. THIS FIRM HAS NOT ATTEMPTED TO LOCATE FOOTING AND/OR FOUNDATIONS AND/OR UNDERGROUND IMPROVEMENTS OF ANY NATURE UNLESS RELATED TO THE SUBJECT AS BUILT.
8. COORDINATES SYSTEM BASED ON FLORIDA STATE PLANE COORDINATES N.A.D. 83 FLORIDA EAST, 1990 ADJUSTMENT.
9. ELEVATIONS SHOWN ARE BASED ON N.A.V.D. 88 VERTICAL DATUM.
10. LAST DATE OF THE FIELDWORK 12/22/2023

AS BUILT PLANS  
SHEET C-8

LOCATION MAP

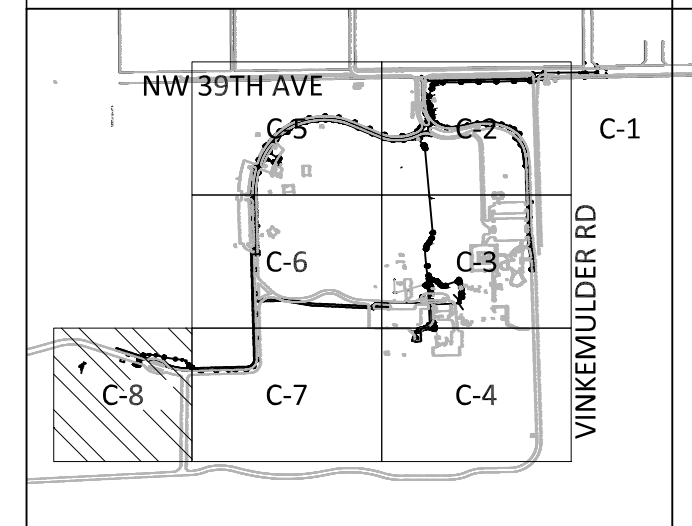


MATCHLINE SHEET C-7

#### LEGEND


BOP	BOTTOM OF PIPE
BOT	BOTTOM
BSP	BACTERIAL SAMPLING POINT
BU	BUBBLE UP STRUCTURE
CB	CATCH BASIN
CE	CONTROL ELEVATION
CLEAR	CLEARANCE
CMH	CONFLICT MANHOLE
CMP	CORRUGATED METAL PIPE
CONC	CONCRETE
CS	CONTROL STRUCTURE
DDCV	DOUBLE DETECTOR CHECK VALVE
DIP	DUCTILE IRON PIPE
DR	DRAINAGE
ELEV	ELEVATION
EXIST	EXISTING
FDC	FIRE DEPARTMENT CONNECTION
FFE	FINISHED FLOOR ELEVATION
FH	FIRE HYDRANT
FT	FEET
GV	GATE VALVE
GRD	FINISH GRADE
HDPE	HIGH DENSITY POLYETHYLENE
HW	HEADWALL
IE	INVERT ELEVATION
INV	INVERT OF PIPE
LF	LINEAR FEET
MAS	MAINTENANCE ACCESS STRUCTURE
NAVD	NORTH AMERICAN VERTICAL DATUM
OUT	OUTFALL
PL	PROPERTY LINE
PVC	POLYVINYL CHLORIDE PIPE
PROP	PROPOSED
RE	RIM ELEVATION
RIM	RIM OF STRUCTURE
RCP	REINFORCED CONCRETE PIPE
RPZ	REDUCED PRESSURE ZONE BACKFLOW PREVENTER
R/W	RIGHT OF WAY
STR	STRUCTURE
TOP	TOP OF PIPE
TYP	TYPICAL
WM	WATER MAIN
W/	WITH
YD	YARD DRAIN

	EXIST GRADE (FT-NAVD)
	PROP GRADE (FT-NAVD)
	ASPHALT PAVEMENT
	TO BE REMOVED CONFLICT MARKER
	TO BE REMOVED
	CHAIN LINK FENCE
	DECORATIVE FENCE
	PROPERTY LINE
	EASEMENT LINE
	R/W LINE

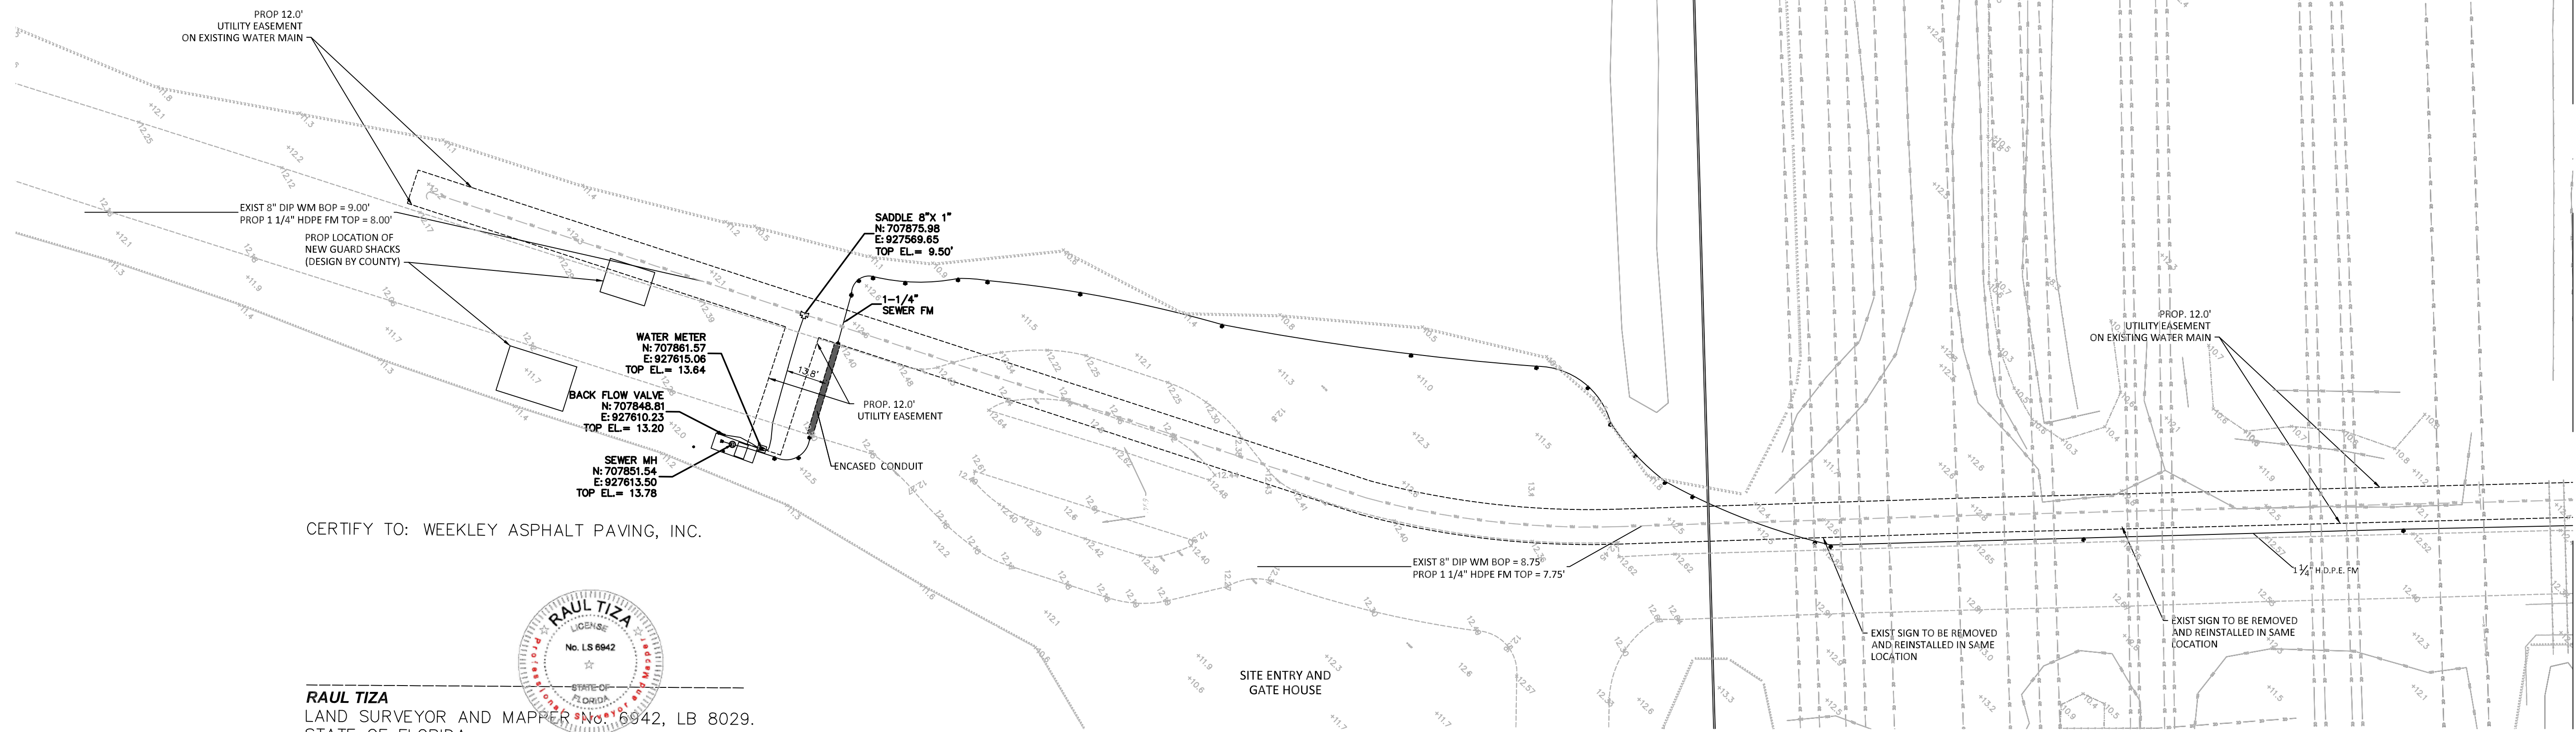

CERTIFY TO: WEEKLEY ASPHALT PAVING, INC.

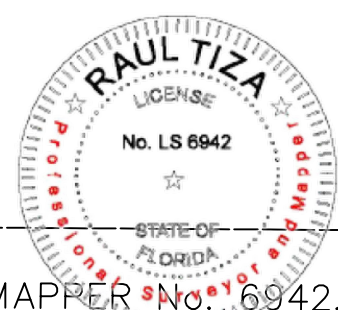

**RAUL TIZA**  
LAND SURVEYOR AND MAPPER No. 6942, LB 8029.  
STATE OF FLORIDA  
18761 SW 291st TERRACE MIAMI FLORIDA 33030  
PHONE: 786-975-8588

NOT VALID WITHOUT THE SIGNATURE AND THE ELECTRONIC SEAL OF A FLORIDA LICENSED SURVEYOR AND MAPPER