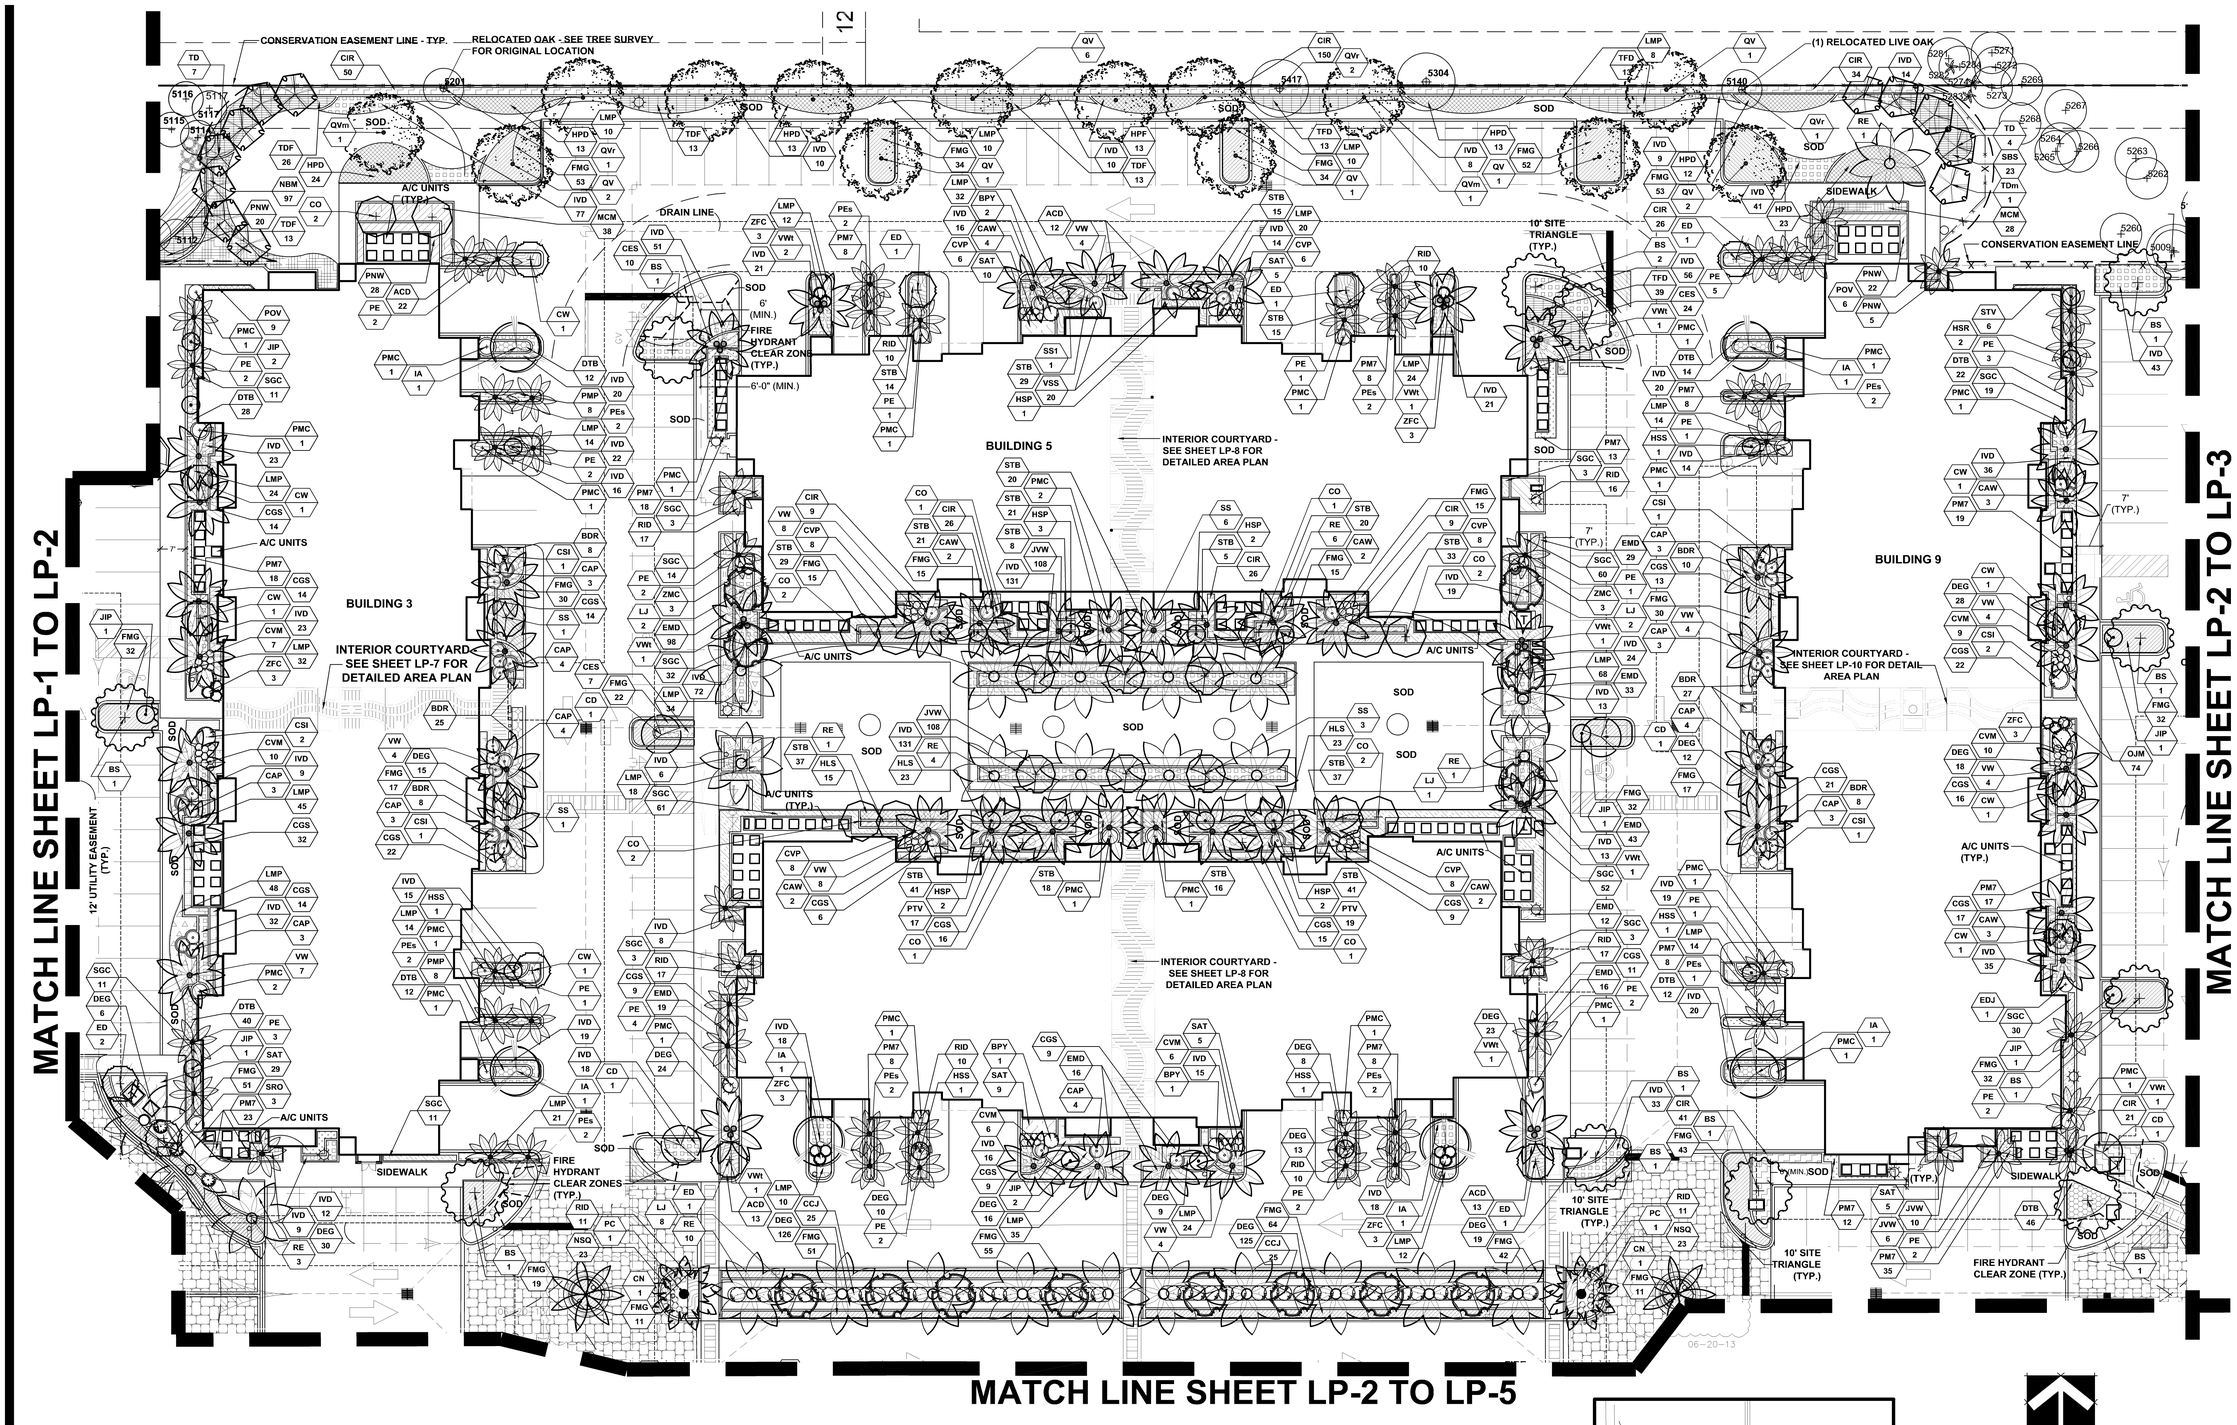

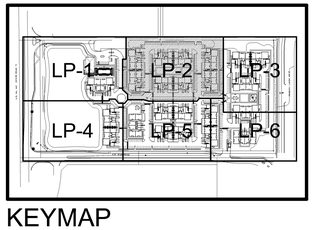

KEYMAP

SCALE: 1" = 20'-0"

ARCHITECTURE
LANDSCAPE ARCHITECTURE
LAND PLANNING
INTERIOR DESIGN
GOVERNMENTAL PROCESSING

ARCHITECTURAL ALLIANCE

612 S.W. FOURTH AVENUE, FORT LAUDERDALE, FLORIDA 33315 AA26001446 LCC000237
TEL: (954) 764-8858 FAX: (954) 764-0731 E-MAIL: landscape@archall.net

HUGH JOHNSON
RLA #C000237

Seal

Revision Dates

Overall As-Built Landscape Plan

CASA PALMA

ZOM DEVELOPMENT, LLC.
COCONUT CREEK, FLORIDA

Sheet Description
Overall As-Built Landscape Plan

Release Date
12/12/14

Project Number
1165

Drawing Number
LP-2

Sheet 2 OF 12