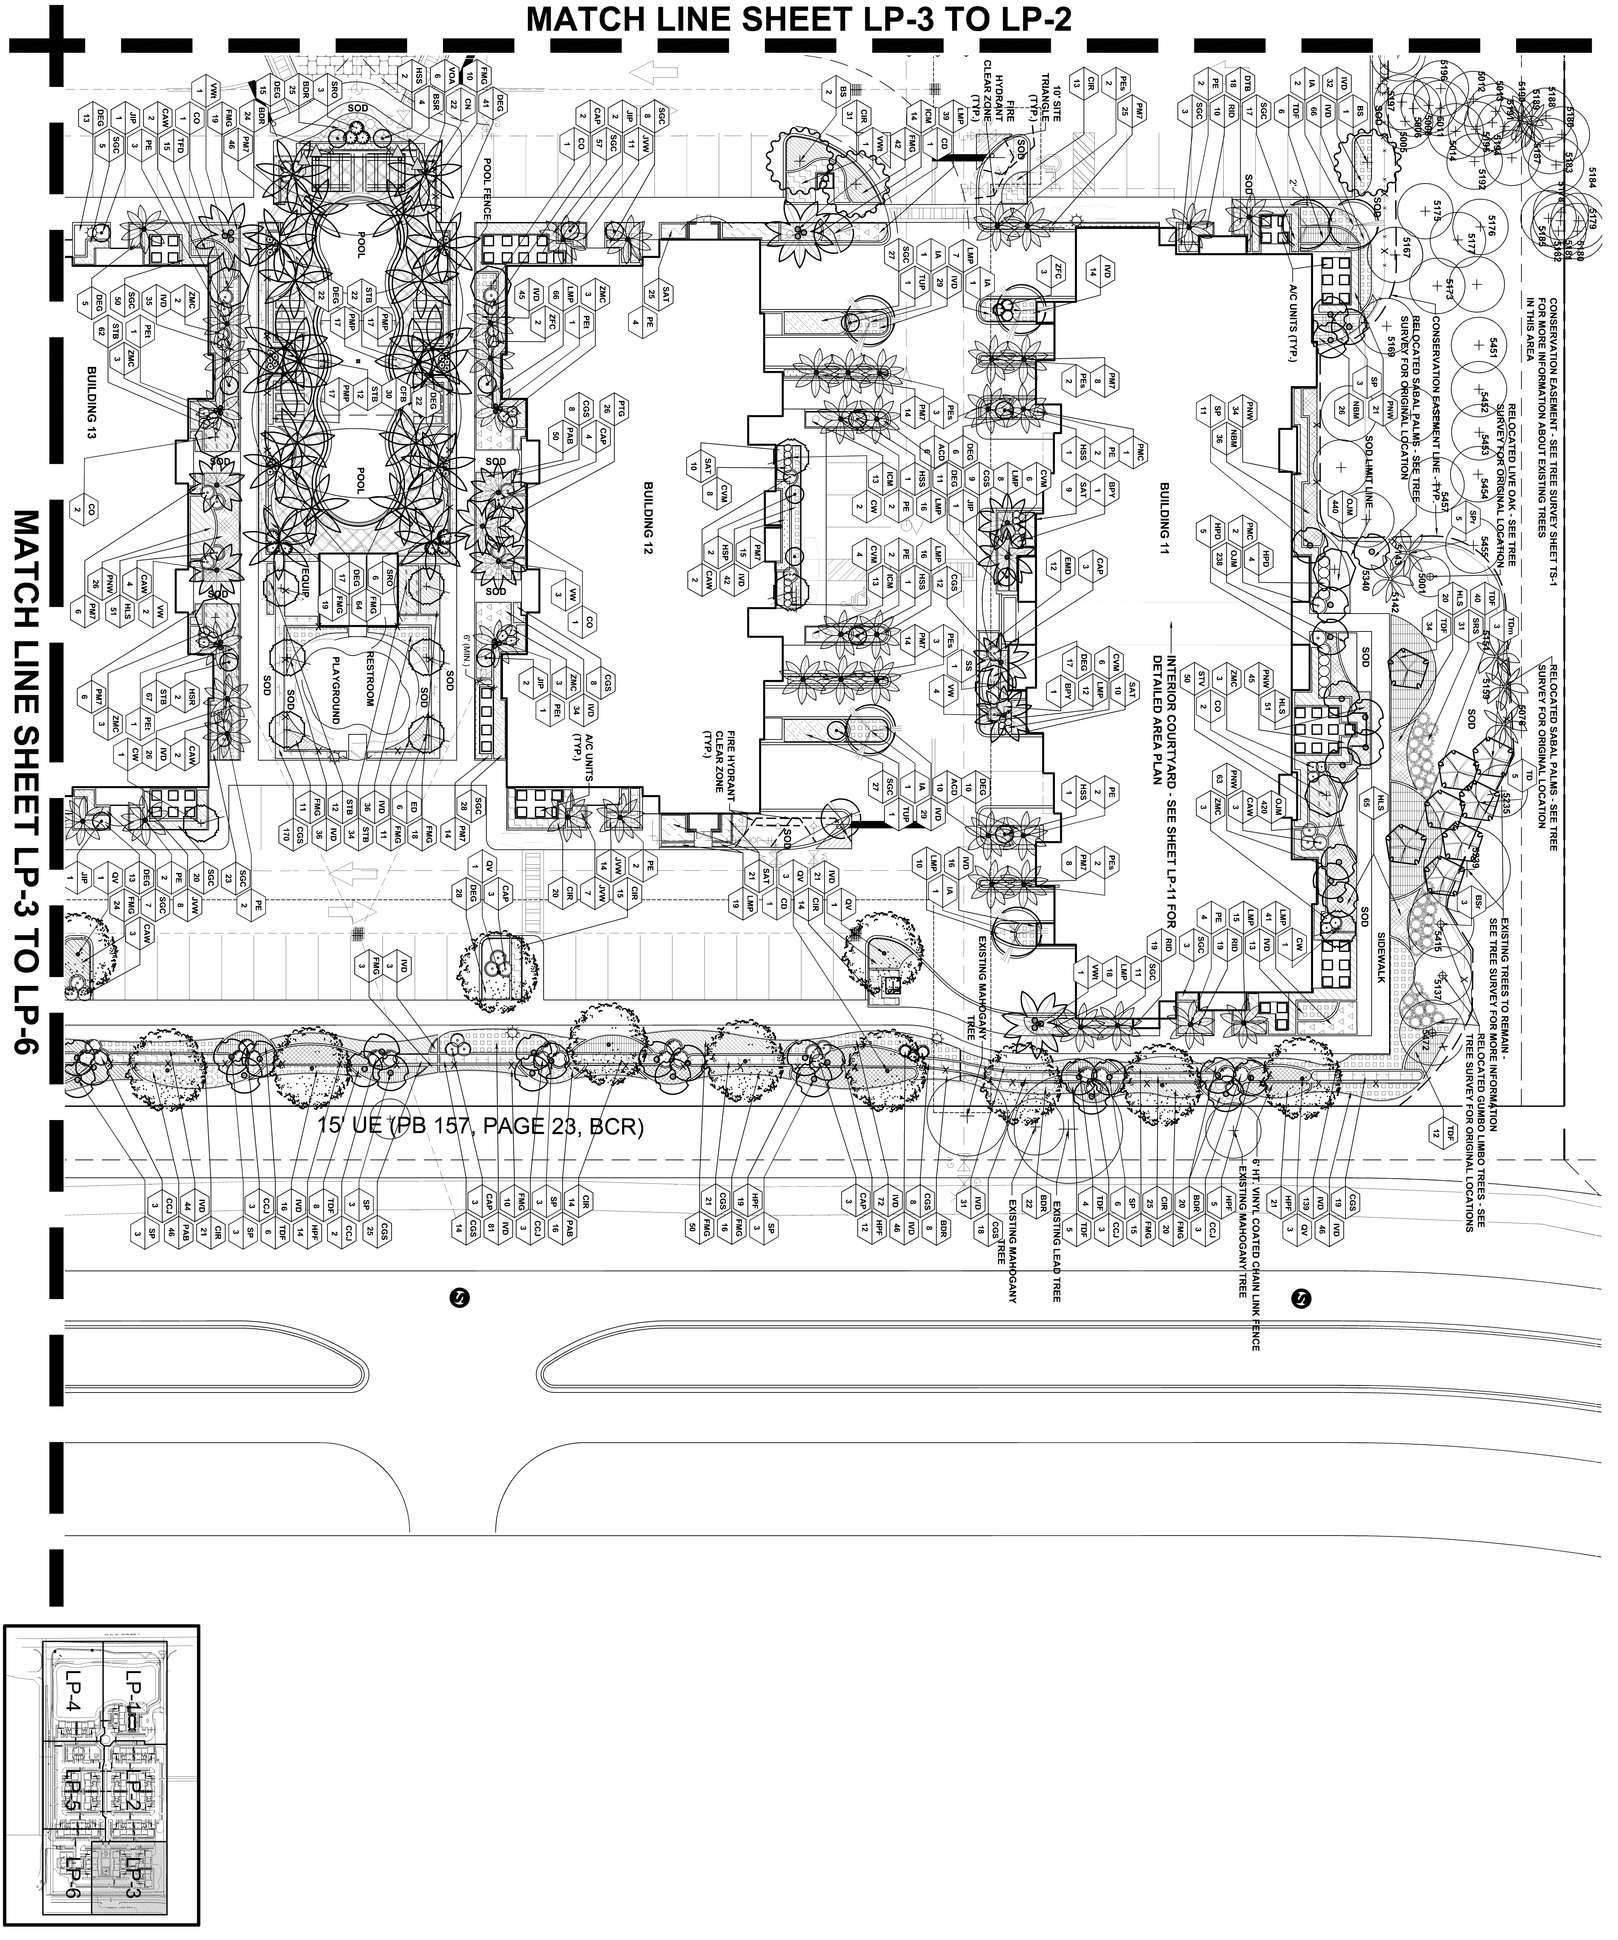

Sheet Description	Overall As-Built Landscape Plan
Release Date	12/12/14
Project Number	1165
Drawing Number	LP-3
	Sheet 3 OF 12

Overall As-Built Landscape Plan

CASA PALMA

ZOM DEVELOPMENT, LLC.

COCONUT CREEK, FLORIDA

Revision Dates

HUGH JOHNSON
RLA #C000237

Seal

ARCHITECTURE
LANDSCAPE ARCHITECTURE
LAND PLANNING
INTERIOR DESIGN
GOVERNMENTAL PROCESSING
ARCHITECTURAL ALLIANCE
612 S.W. FOURTH AVENUE, FORT LAUDERDALE, FLORIDA 33315 AA26001446 LC0000237
TEL: (954) 764-8858 FAX: (954) 764-0731 E-MAIL: landscape@archall.net