MATCH LINE SHEET LP-4 TO LP-1

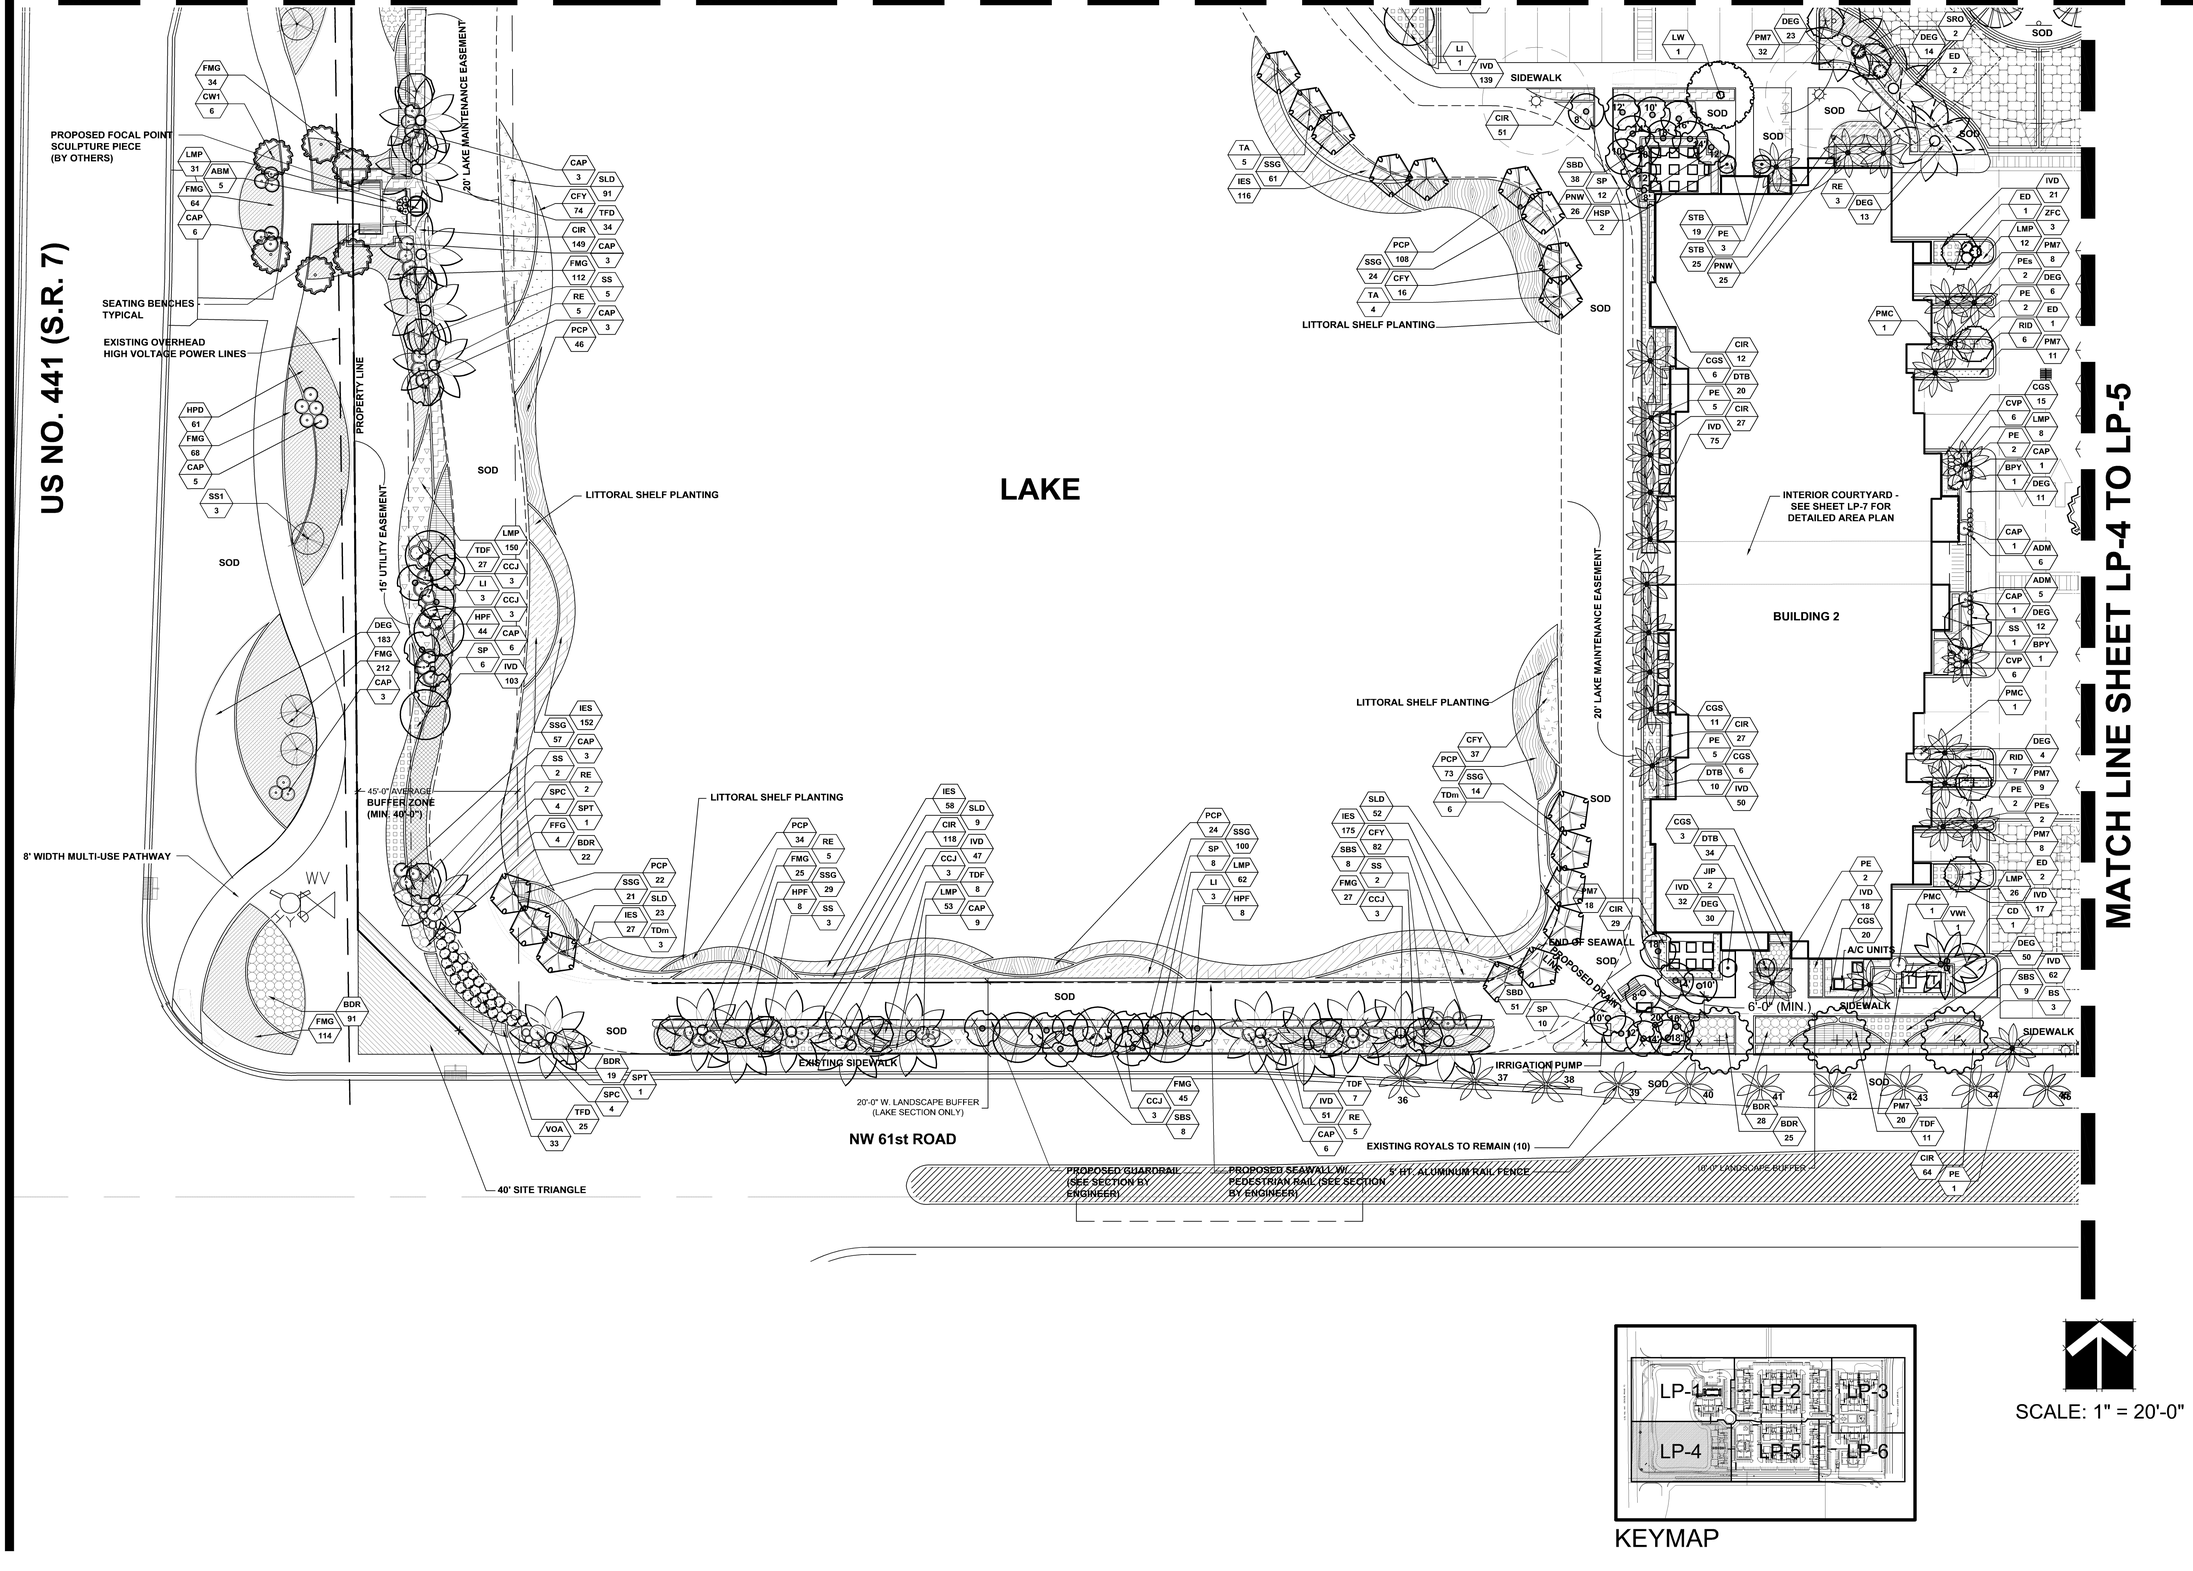

MATCH LINE SHEET LP-4 TO LP-5

KEYMAP

SCALE: 1" = 20'-0"

ARCHITECTURAL ALLIANCE
ARCHITECTURE
LANDSCAPE ARCHITECTURE
LAND PLANNING
INTERIOR DESIGN
GOVERNMENTAL PROCESSING
AA26000627
615 S. Congress Avenue, Delray Beach, FL 33445
(561) 750-6868 FAX: (954) 704-0731 E-MAIL: aainfo@aarchitect.net

HUGH JOHNSON
RLA #C000237
Seal

Revision Dates

Overall As-Built Landscape Plan
CASA PALMA
ZOM DEVELOPMENT, LLC.
COCONUT CREEK, FLORIDA

Sheet Description: Overall As-Built Landscape Plan

Release Date: 12/12/14

Project Number: 1165

Drawing Number: LP-4

Sheet 4 OF 12