abbreviations :

&	AND	JAN	JANITOR
∠	ANGLE	JT	JOINT
@	AT		
℄	CENTER LINE	K	THOUSAND (1,000)
⌀	DIAMETER OR ROUND	KIT	KITCHEN
⊥	PERPENDICULAR		
#	POUND OR NUMBER	LAM	LAMINATED
(E)	EXISTING	LAV	LAVATORY
		LP	LOW POINT
ABV	ABOVE	LVR	LOUVER
ACOUS	ACOUSTICAL		
A/C	AIR CONDITIONING	MACH	MACHINE
AD	AREA DRAIN	MATL	MATERIAL
ADJ	ADJACENT/ADJUSTABLE	MAX	MAXIMUM
AFF	ABOVE FINISHED FLOOR	MDF	MEDIUM DENSITY FIBERBOARD
A.H.U.	AIR HANDLER UNIT	MECH	MECHANICAL
ALT	ALTERNATE	MEMB	MEMBRANE
ALUM	ALUMINUM	MEZZ	MEZZANINE
ANOD	ANODIZED	MFR	MANUFACTURE
APPROX	APPROXIMATE (LY)	MH	MAN HOLE
		MIN	MINIMUM
BD	BOARD	MIR	MIRROR
BITUM	BITUMINOUS	MISC	MISCELLANEOUS
BLDG	BUILDING	MO	MASONRY OPENING
BLK	BLOCK	MTD	MOUNTED
BLKG	BLOCKING	MTL	METAL
BM	BEAM	MUL	MULLION
BOT	BOTTOM		
BRZ	BRONZE		
		N	NORTH
C.	CHANNEL	NIC	NOT IN CONTRACT
CAB	CABINET	NO OR #	NUMBER
CB	CATCH BASIN	NOM	NOMINAL
CER	CERAMIC	NTS	NOT TO SCALE
CJ	CONTROL JOINT		
CLG	CEILING	OA	OVERALL
CL	CLOSET	OC	ON CENTER
CLR	CLEAR	OD	OUTSIDE DIAMETER
CLR OPG	CLEAR OPENING	OFF	OFFICE
CMU	CONCRETE MASONRY UNIT	OPNG	OPENING
CNTR	COUNTER	OPH	OPPOSITE HAND
CO	CLEAN OUT		
COL	COLUMN		
CONC	CONCRETE	PARTN	PARTITION
CONSTR.	CONSTRUCTION	PED.	PEDESTAL
CONT	CONTINUOUS	PH	PENTHOUSE
CONTR	CONTRACTOR	P L	PROPERTY LINE
COORD	COORDINATE	PLAM	PLASTIC LAMINATE
CPT	CARPET	PLAS	PLASTER
CT	CERAMIC TILE	PLBG	PLUMBING
CTR	CENTER	PLWD	PLYWOOD
		PNL	PANEL
D	DRYER	PNT	PAINT
DBL	DOUBLE	PR	PAIR
DEPT	DEPARTMENT	PREFAB	PREFABRICATED
DET	DETAIL	PREFIN	PRE-FINISHED
DF	DRINKING FOUTAIN	PS	PULL STATION
DD	DECK DRAIN	PSF	POUNDS PER SQUARE FOOT
DIAM	DIAMETER	PSI	POUNDS PER SQUARE INCH
DIM	DIMENSION	PT	PRESSURE TREATED
DISP	DISPENSER	PRCST	PRE-CAST
DN	DOWN	PREFAB	PREFABRICATED
DR	DOOR	PVMT	PAVEMENT
DS	DOWNSPOUT	PVC	POLYVINYL CHLORIDE
DTL	DETAIL		
DW	DISHWASHER	QT	QUARRY TILE
DWG	DRAWING	QTY	QUALITY
E	EAST	R	RISER OR RADIUS
EA	EACH	R&S	ROD AND SHELF
EJ	EXPANSION JOINT	RA	RETURN AIR
EL	ELEVATION	RAD	RADIUS
ELECT	ELECTRICAL	RD	ROOF DRAIN
ELEV	ELEVATOR	REF	REFRIGERATOR
EMER	EMERGENCY	REINF	REINFORCED
ENCL	ENCLOSE/ENCLOSURE	REQ'D	REQUIRED
EQ	EQUAL	REV	REVISION
EQUIP	EQUIPMENT	RM	ROOM
EWC	ELECTRIC WATER COOLER	RO	ROUGH OPENING
EXIST	EXISTING	RTU	ROOF TOP UNIT
EXP	EXPANSION	RWL	RAIN WATER LEADER
EXT	EXTERIOR		
		S	SOUTH
FA	FIRE ALARM	SC	SOLID CORE
FD	FLOOR DRAIN	SCHED	SCHEDULE
FDN	FOUNDATION	SEC	SECTION
FE	FIRE EXTINGUISHER	SHT	SHEET
FEC	FIRE EXTINGUISHER CABINET	SHWR	SHOWER
FF/FIN.FLR.	FINISH FLOOR	SIM	SIMILAR
FHC	FIRE HOSE CABINET	SPEC	SPECIFICATION
FHR	FIRE HOSE RACK	SQ	SQUARE
FIXT	FIXTURE	SS	STAINLESS STEEL
FLR	FLOOR	SSK	SERVICE SINK
FLUOR	FLUORESCENT	STA	STATION
FND	FOUNDATION	STC	SOUND TRANSMISSION COEFF.
FP	FIRE PROOF	STD	STANDARD
FRT	FIRE RETARDANT TREATED	STL	STEEL
FS	FULL SIZE	STOR	STORAGE
FT	FOOT	STRUCT	STRUCTURAL/STRUCTURE
FTG	FOOTING	SUSP	SUSPENDED
FURN	FURNITURE	SYM	SYMMETRICAL
FURR	FURRING		
		T	TREAD OR TOILET
GA	GAUGE	TELE	TELEPHONE
GALV	GALVANIZED	TEMP	TEMPERED
GC	GENERAL CONTRACTOR	T&G	TONGUE AND GROOVE
GL	GLASS	THK	THICK (NESS)
GL BLK	GLASS BLOCK	TO	TOP OF
GND	GROUND	TYP	TYPICAL
GRND	GROUND		
GYP	GYPSUM		
GYP BD	GYPSUM BOARD	UC	UNDERCUT
		UNF	UNFINISHED
HB	HOSE BIBB	UON	UNLESS OTHERWISE NOTED
HC	HANDICAPED	UR	URINAL
HDWR	HARDWARE		
HM	HOLLOW METAL	VCT	VINYL COMPOSITION TILE
HP	HIGH POINT	VEST	VESTIBULE
HR	HOUR (S)	VIF	VERIFY IN FIELD
HT	HEIGHT		
HVAC	HEATING/VENTILATING	W	WASHER
		W/	WITH
ID	INSIDE DIAMETER	W/O	WITHOUT
IN	INCH	WC	WATER CLOSET
INCL	INCLUDE	WD	WOOD
INFO	INFORMATION	WR	WATER RESISTANT
INSUL	INSULATION	WSCT	WAINSCOAT
INT	INTERIOR	WT	WEIGHT
INV	INVERT	WWF	WELDED WIRE FABRIC

symbols :

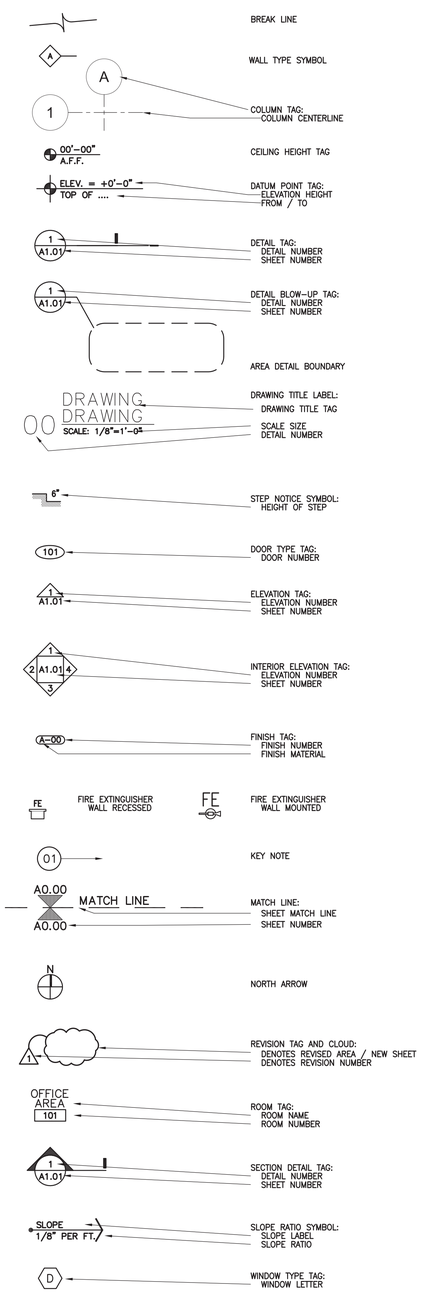

index of drawings :

NUMB.	SHEET:	DESCRIPTION:	11/18/2019 (ADMIN. SITE APPROVAL)	03/03/2020(AREV 1)	06/05/2020(AREV 2)
001	CS.00	COVER SHEET	●	●	
002	CS.01	ABBREVIATIONS, SYMBOLS & INDEX OF DRAWINGS	●	●	●
		SURVEY :			
070	SUV1.0	SURVEY	●		●
071	SUV2.0	SURVEY	●		●
072	SUV3.0	~~EASEMENT LETTER (SENT ON 8DVSON 1)~~		●	
073	SUV4.0	SURVEY – EXISTING RAMP DETAILS (NEW)			●
		ARCHITECTURAL :			/2
090	A2.01	DEMOLITION & PROPOSED ELEVATIONS (W/ COLOR FINISHES)	●	●	
091	A2.02	DEMOLITION & PROPOSED ELEVATIONS (W/ COLOR FINISHES)	●	●	
092	A2.03	DEMOLITION & PROPOSED ELEVATIONS (W/ COLOR FINISHES)	●	●	
093	A2.04	PROPOSED 3D "CONCEPTUAL" RENDERINGS & FINISHES	●	●	
		TREE DISPOSITIONPLAN :			
170	TD.1	TREE SURVEY & DISPOSITION PLAN	●		
		LANDSCAPING PLAN :			
190	LP.1	LANDSCAPING – PLANTING PLAN	●		●
191	LP.2	LANDSCAPING – PLANTING DETAILS & PLANT LIST	●		
192	LP.3	~~LANDSCAPING – COCONUT CREEK STAND. LANDSCAPING NOTES~~			●
193	LH.1	LANDSCAPING – HARDSCAPE PLAN (NEW)			●
194	LH.2	LANDSCAPING – HARDSCAPE DETAILS (NEW)			●
195	LL	LANDSCAPING – LIGHTING PLAN (NEW)			●
		PHOTOMETRIC PLAN :			/2
190	PH.1.0	PHOTOMETRIC PLAN – STANDARD	●	●	●

modis architects
4955 SW 75th Avneue
Miami, Florida 33155
Florida Corp. AA#26001777
t. 786.879.8882
f. 786.350.1515
e. MODIS@MODISarchitects.com

project info :

TOWNSHIP PLAZA

Facade Renovation

4400 W. SAMPLE RD.
COCONUT CREEK, FL 33073

client :

S2 DEVELOPMENT
18851 NE 29th Ave,Suite 1011
Aventura, FL 33180
www.s2development.com

seal :

Robert K. Morisette

Digitally signed by Robert K. Morisette
Date: 2020.06.08 16:55:39 -04'00'

ROBERT K. MORISETTE, AIA, NCARB, LEED AP BD+C, CDP
FLORIDA REGISTERED ARCHITECT # AR 93259

THIS DRAWING IS THE PROPERTY OF MODIS ARCHITECTS, LLC AND IS NOT TO BE REPRODUCED OR COPIED IN WHOLE OR IN PART WITHOUT THE PRIOR WRITTEN CONSENT OF MODIS ARCHITECTS, LLC. THIS DRAWING IS ONLY TO BE USED FOR THE PROJECT AND SITE SPECIFICALLY IDENTIFIED HEREIN AND IS NOT TO BE USED FOR ANY OTHER PROJECT. SCALES ARE AS STATED. THE CONTRACTOR SHALL CAREFULLY REVIEW ALL DIMENSIONS AND CONDITIONS SHOWN HEREON AND AT ONCE NOTIFY THE ARCHITECT AS TO ANY ERRORS, OMISSIONS, AND/OR INCONSISTENCIES HEREIN. MAY OBLIGATE OVER. COPYRIGHT © 2017 MODIS ARCHITECTS, LLC

revisions :

2	06/08/2020	DRC COMMENTS
1	03/03/2020	DRC COMMENTS

drawing data :

ABBREVIATIONS, SYMBOLS & INDEX OF DRAWINGS

project number :	
#19077	
drawn by :	**proj. manager :**
RC	YP
drawing scale :	**drawing date :**
As Shown	03/11/2020

phase :

CONST. DOCUMENTS

sheet number :

CS.01

Copyright © 2019 | MODIS ARCHITECTS, LLC | All Rights Reserved | M:\MODIS - Drawings\2019 - Drawings\19077 - Township Plaza\Drawings\Revit Files\2020\Arch\19077 - Township Plaza Site Plan Revised.Revit 2/20/2020 4:54:06 PM