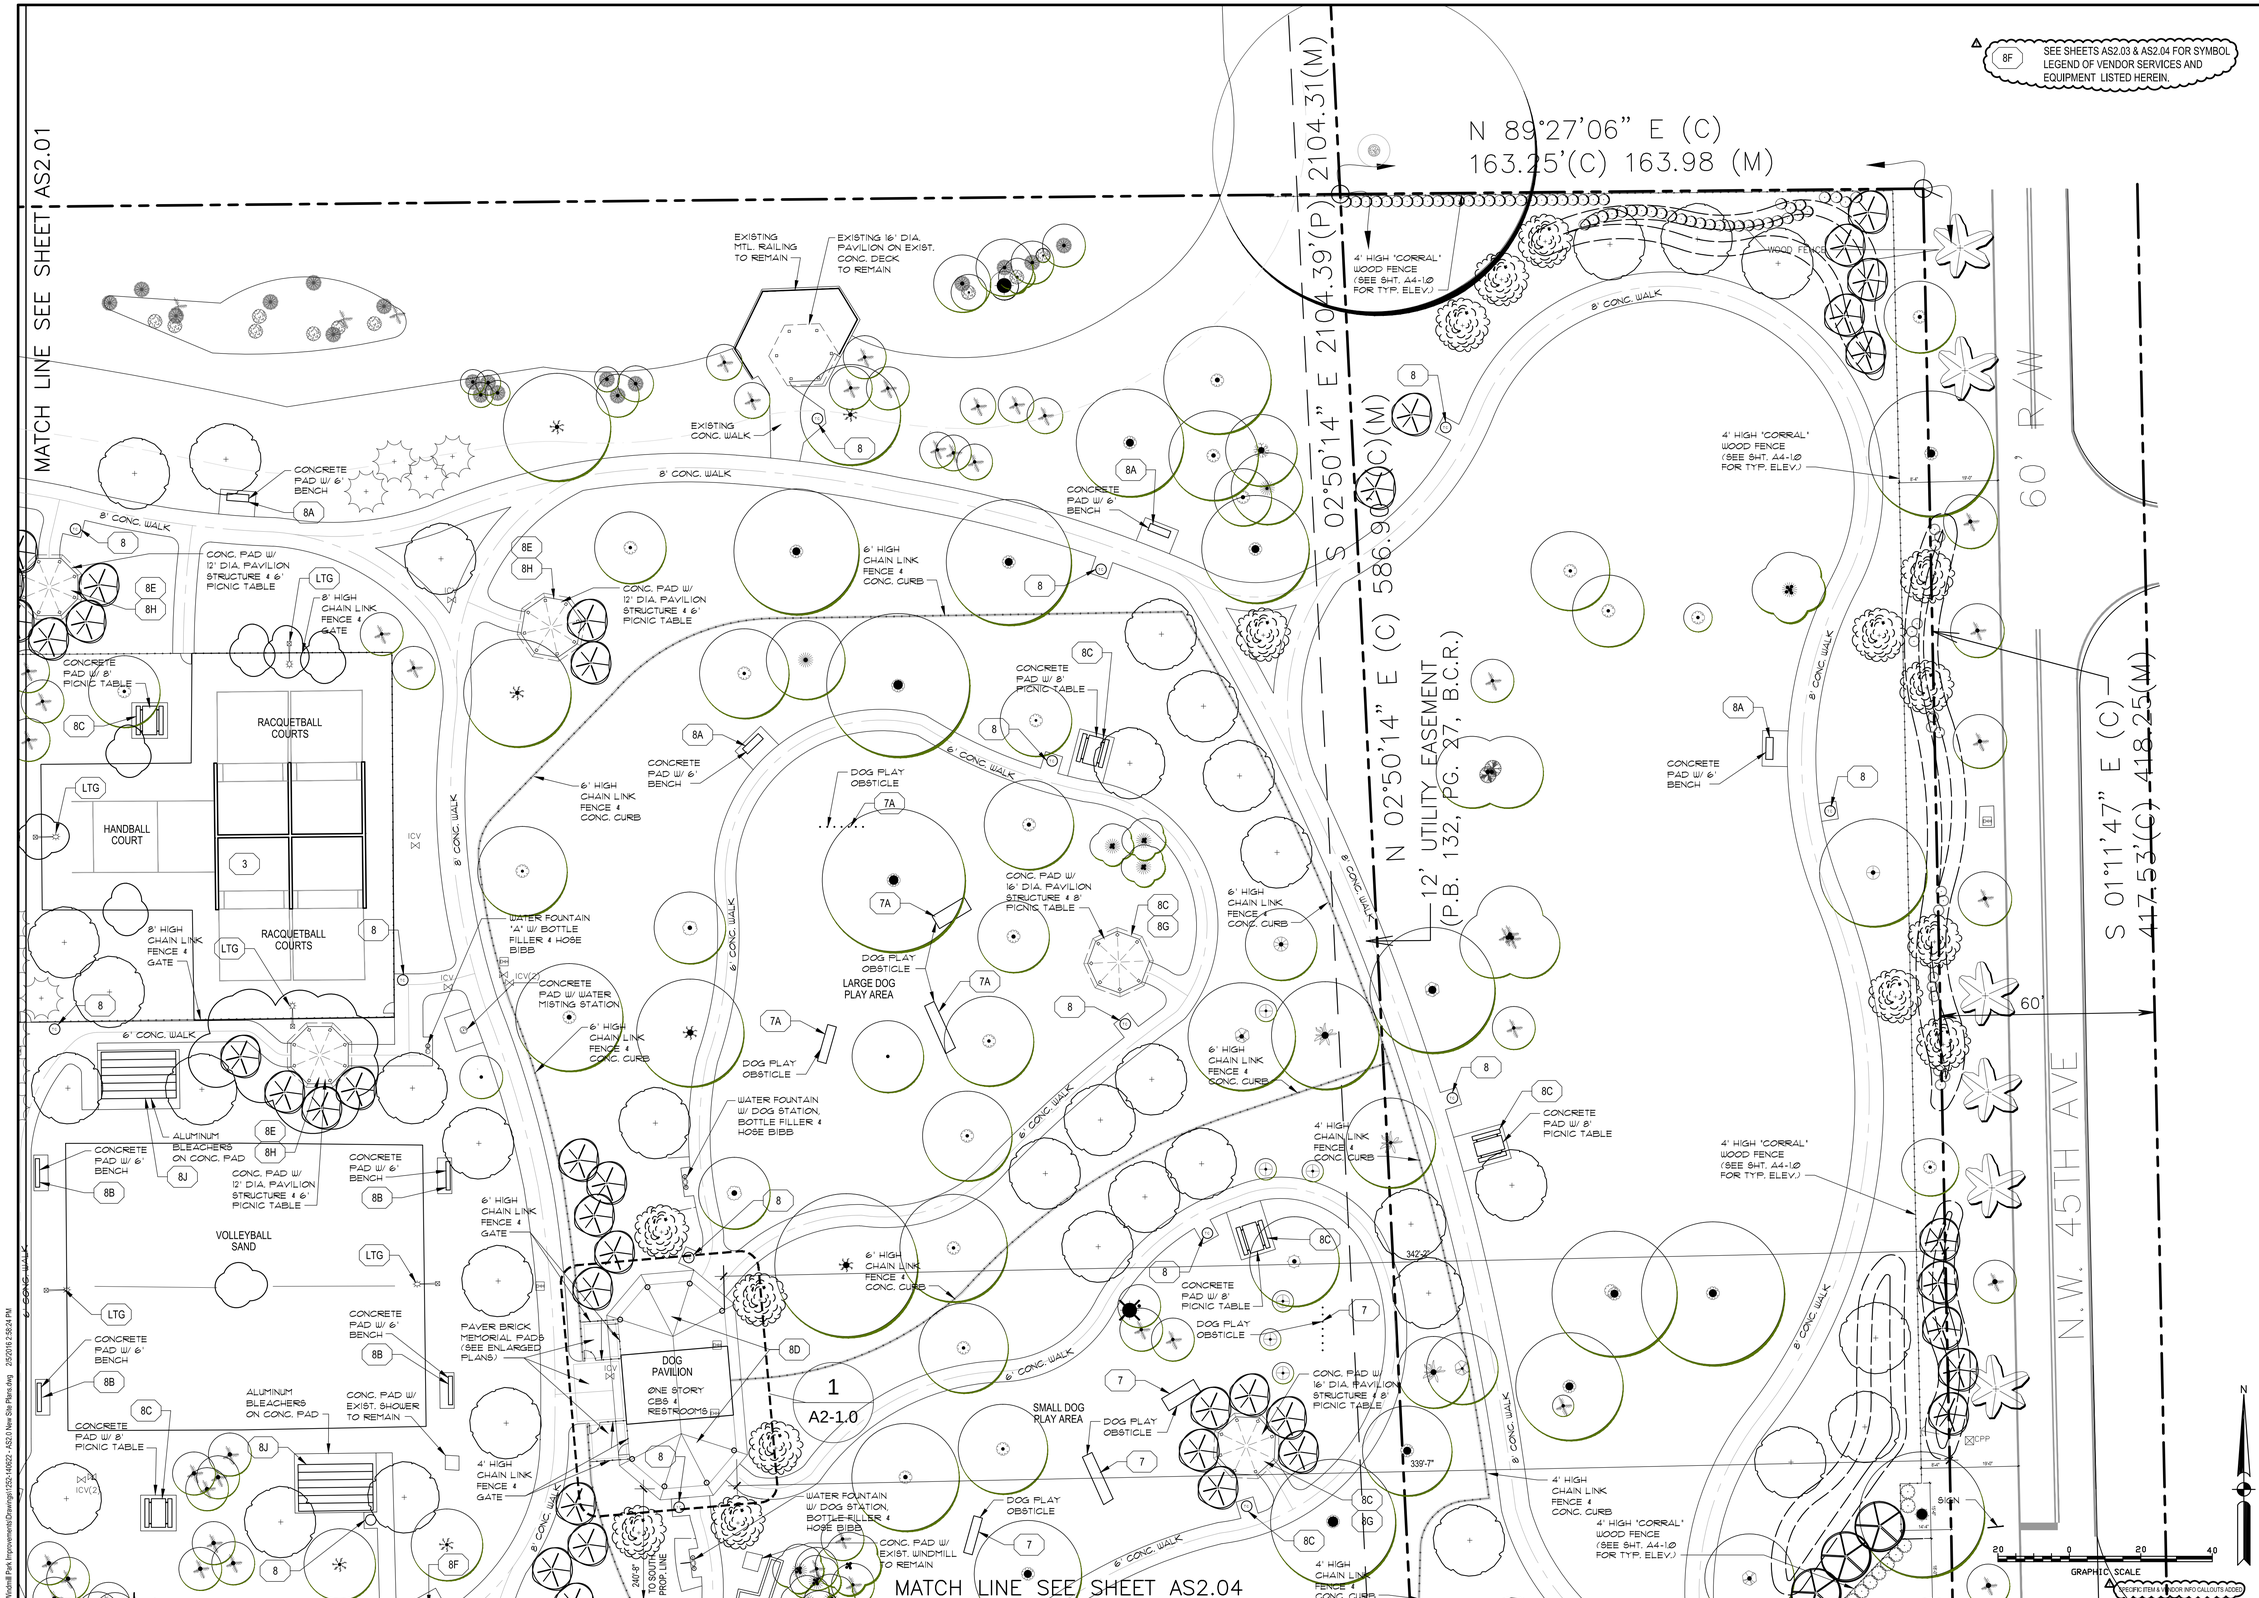

8F SEE SHEETS AS2.03 & AS2.04 FOR SYMBOL LEGEND OF VENDOR SERVICES AND EQUIPMENT LISTED HEREIN.

1 ENLARGED PARTIAL SITE PLAN
SCALE: 1" = 20'

SYNALOVSKI ROMANIK SAYE
Architecture • Planning • Interior Design
1800 Eller Drive, Suite 500
Fort Lauderdale, FL 33316
T 954.961.6806
F 954.961.6807
www.synalovski.com

Manuel Synalovski, AIA
AR 0011628
SEAL

Manuel Synalovski
Digitally signed by Manuel Synalovski
DN: cn=Manuel Synalovski, o=Synalovski Romanik Saye, ou, email=msynalovski@synalovski.com, c=US
Date: 2016.02.05 15:03:53 -05'00'

LICENSE NO. AA26001863

WINDMILL PARK

700 LYONS ROAD
COCONUT CREEK, FL 33063

CLIENT: CITY OF COCONUT CREEK

REV	DATE	DESCRIPTION
A	12/14/15	DRC REVIEW COMMENTS

DESIGN DELIVERABLE: PERMIT SET
ISSUE DATE: 01/26/16

PROJECT NUMBER: 1252-140622
DRAWN BY: KW
CHECKED BY: MR

Copyright (c) by SYNALOVSKI ROMANIK SAYE
All Rights Reserved.

SHEET TITLE:
PARTIAL SITE PLAN

SHEET NUMBER:
AS2.02

E:\1252-140622 Windmill Park Improvements\Drawings\1252-140622 - AS2.0 New Site Plans.dwg 2/5/2016 2:58:24 PM