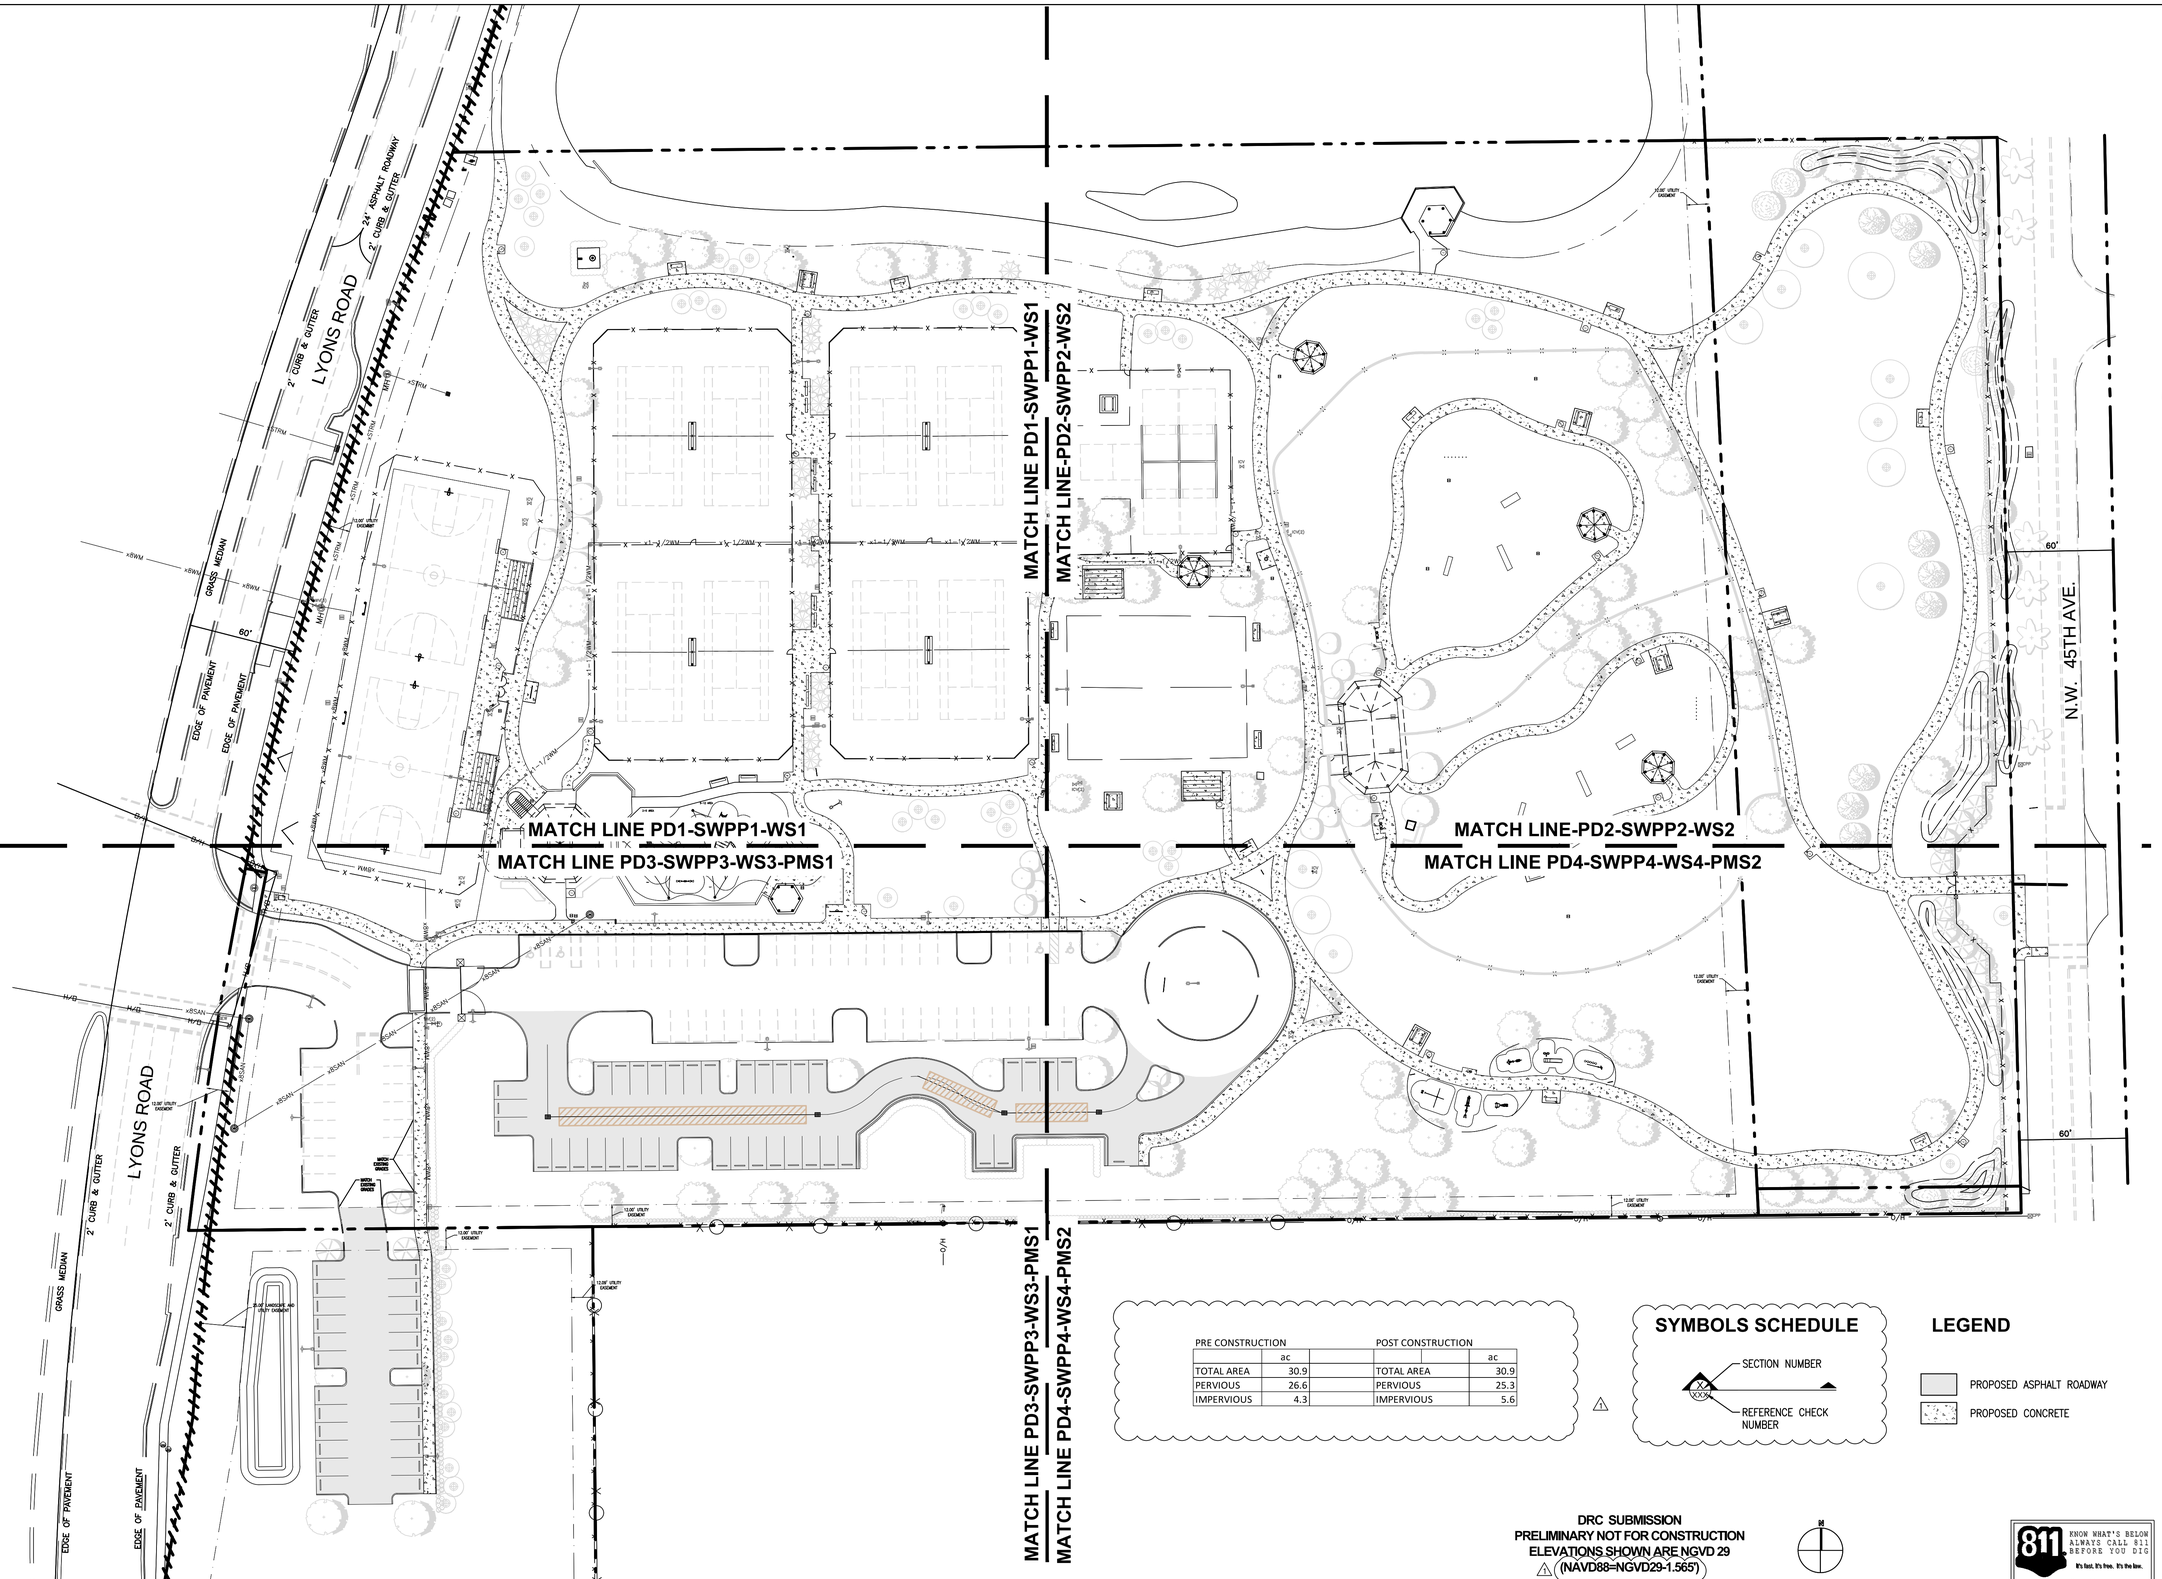

PRE CONSTRUCTION			POST CONSTRUCTION	
	ac			ac
TOTAL AREA	30.9		TOTAL AREA	30.9
PERVIOUS	26.6		PERVIOUS	25.3
IMPERVIOUS	4.3		IMPERVIOUS	5.6

SYMBOLS SCHEDULE

SECTION NUMBER

REFERENCE CHECK NUMBER

LEGEND

PROPOSED ASPHALT ROADWAY

PROPOSED CONCRETE

DRC SUBMISSION
PRELIMINARY NOT FOR CONSTRUCTION
ELEVATIONS SHOWN ARE NGVD 29
(NAVD88=NGVD29-1.565')

G-1 OVERALL PLAN
1"= 40'-0"

0 20' 40' 80'

KNOW WHAT'S BELOW ALWAYS CALL 811 BEFORE YOU DIG
It's fast. It's free. It's the law.
www.callsunshine.com

SynalovskiRomanikSaye
Architecture • Planning • Interior Design
1800 Eller Drive, Suite 500
Fort Lauderdale, FL 33316
T 954.961.6806
F 954.961.6807
www.synalovski.com

NICHOLAS B. MAHON, P.E. PROFESSIONAL ENGINEER LICENSE No. 7836

Digitally signed by Nicholas B. Mahon, PE
DN: cn=Nicholas B. Mahon, PE, o, ou=Calvin, Giordano & Associates, Inc., email=nmahon@cgasolutions.com, c=US
Date: 2016.02.05 17:05:49 -05'00'

Certificate of Authorization 2-14

Calvin, Giordano & Associates, Inc.
EXCEPTIONAL SOLUTIONS
1800 Eller Drive, Suite 600, Fort Lauderdale, Florida 33316
Phone: 954.921.7781 • Fax: 954.921.8807

WINDMILL PARK

700 LYONS ROAD
COCONUT CREEK, FL 33063

CLIENT: CITY OF COCONUT CREEK

REV	DATE	DESCRIPTION
1	12/14/2015	DRC REVIEW COMMENTS

DESIGN 100% COMPLETION
DELIVERABLE: SET
ISSUE DATE: 01/13/2016

PROJECT NUMBER: 1252-140622
DRAWN BY: JB
CHECKED BY: NBM

Copyright (c) by SYNALOVSKI ROMANIK SAYE
All Rights Reserved.

SHEET TITLE:
WINDMILL PARK
OVERALL PLAN

SHEET NUMBER:
G1

P:\Projects\2014\141221 Windmill Park\CADD files\Drawings\14-7271_C-ST-RM-P-PLAN.dwg 1/13/2016 2:01:18 PM