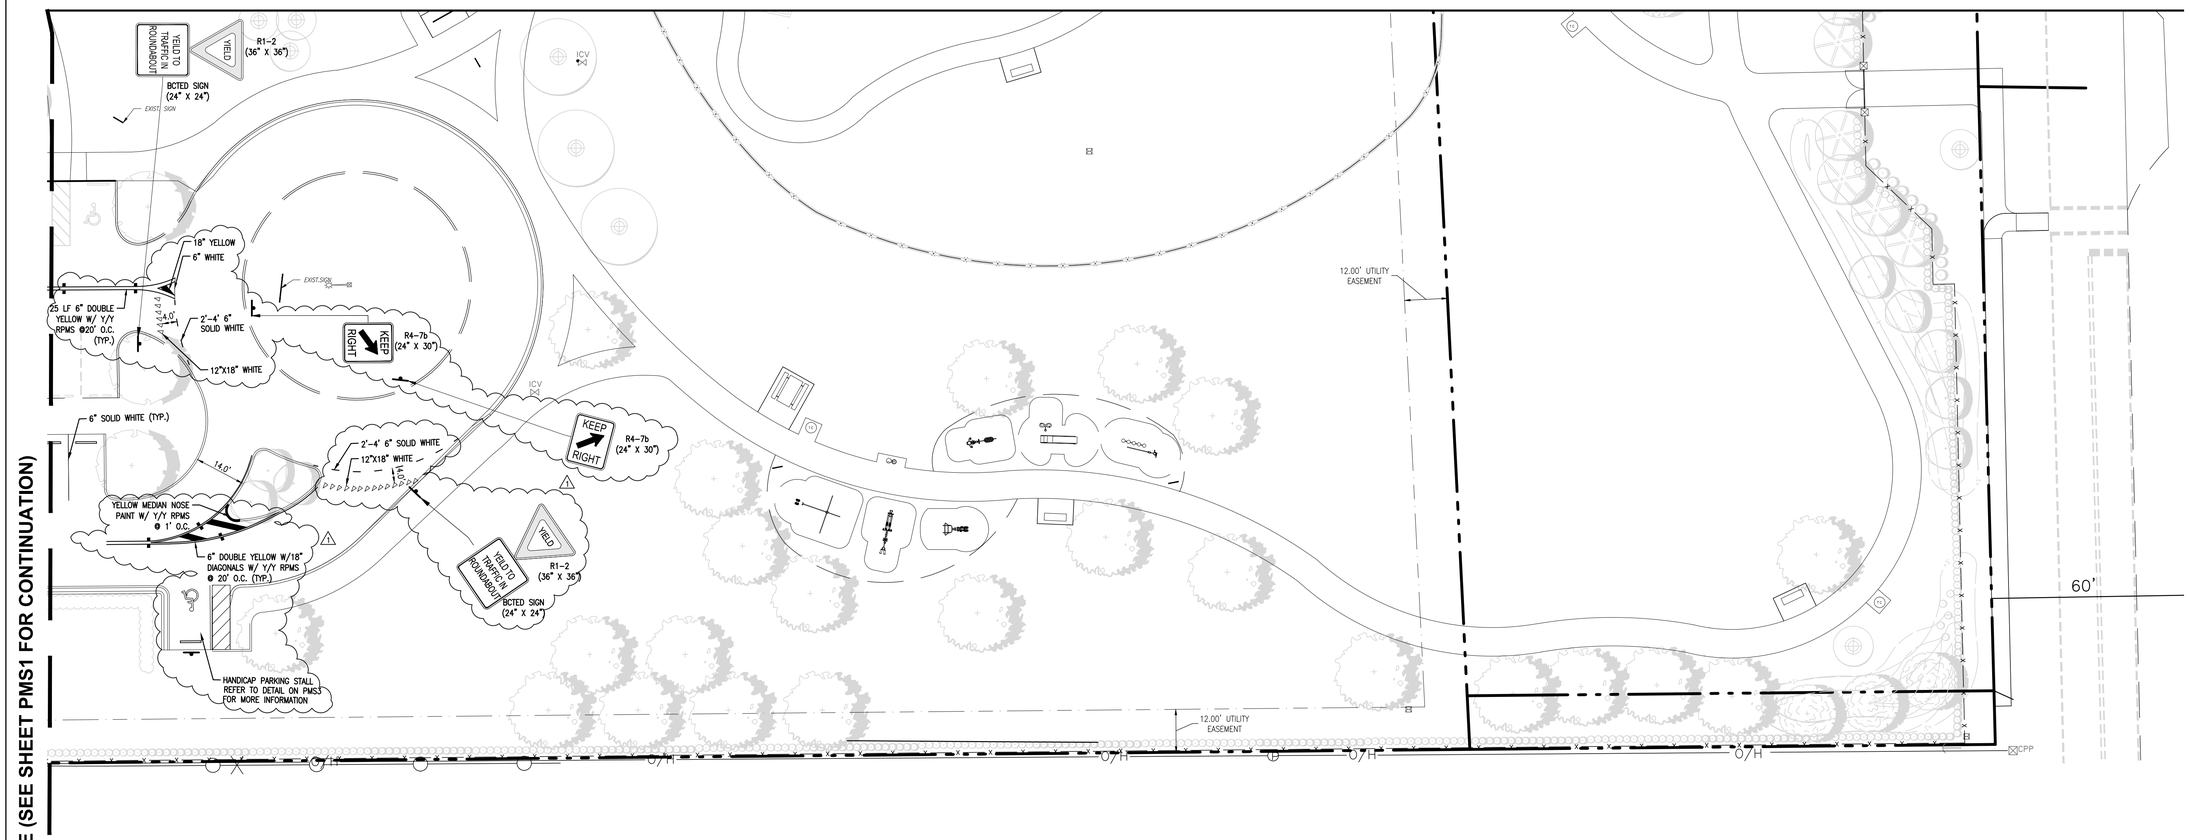

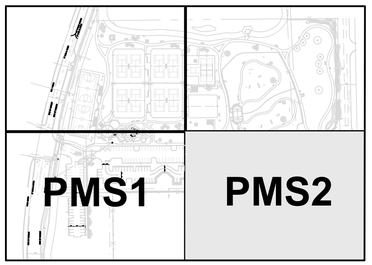

KEY MAP(NTS)

DRC SUBMISSION
PRELIMINARY NOT FOR CONSTRUCTION
ELEVATIONS SHOWN ARE NGVD 29
(NAVD88=NGVD29-1.565')

811 KNOW WHAT'S BELOW ALWAYS CALL 811 BEFORE YOU DIG
It's fast. It's free. It's the law.
www.callsunshine.com

2 PAVEMENT MARKING AND SIGNAGE PLAN
1"= 20'-0"

0 10' 20' 40'

SYNALOVSKI ROMANIK SAYE
Architecture • Planning • Interior Design
1800 Eller Drive, Suite 500
Fort Lauderdale, FL 33316
T 954.961.6806
F 954.961.6807
www.synalovski.com

NICHOLAS B. MAHON, P.E.
STATE OF FLORIDA PROFESSIONAL ENGINEER
LICENSE No. 78361
Nicholas B. Mahon, PE
Digitally signed by Nicholas B. Mahon, PE
DN: cn=Nicholas B. Mahon, PE, o, ou=Calvin, Giordano & Associates, Inc., email=nmahon@cgasolutions.com, c=US
Date: 2016.02.05 17:11:13 -05'00'
Certificate of Authorization 514

Calvin, Giordano & Associates, Inc.
EXCEPTIONAL SOLUTIONS
1800 Eller Drive, Suite 600, Fort Lauderdale, Florida 33316
Phone: 954.921.7781 • Fax: 954.921.8807

WINDMILL PARK

700 LYONS ROAD
COCONUT CREEK, FL 33063

CLIENT: CITY OF COCONUT CREEK

REV	DATE	DESCRIPTION
1	12/14/2015	DRC REVIEW COMMENTS

DESIGN DELIVERABLE: 100% COMPLETION SET
ISSUE DATE: 01/13/2016

PROJECT NUMBER: 1252-140622
DRAWN BY: JB
CHECKED BY: NBM

Copyright (c) by SYNALOVSKI ROMANIK SAYE
All Rights Reserved.

SHEET TITLE:
PAVEMENT MARKING AND SIGNAGE PLAN

SHEET NUMBER:
PMS2